


NORTHWEST CORNER OF
THE NORTHWEST 1/4 OF
SECTION 31-3-16

PLAT OF SURVEY

LOT 1 CERTIFIED SURVEY MAP NO. 2364, BEING A PART
OF THE SOUTHWEST 1/4 OF THE NORTHWEST 1/4 OF
SECTION 31, TOWN 3 NORTH, RANGE 16 EAST, TOWN
OF SUGAR CREEK, WALWORTH COUNTY, WISCONSIN.

SURVEYED FOR: TINCER REALTY

SURVEY ADDRESS: N5114 COUNTY ROAD P

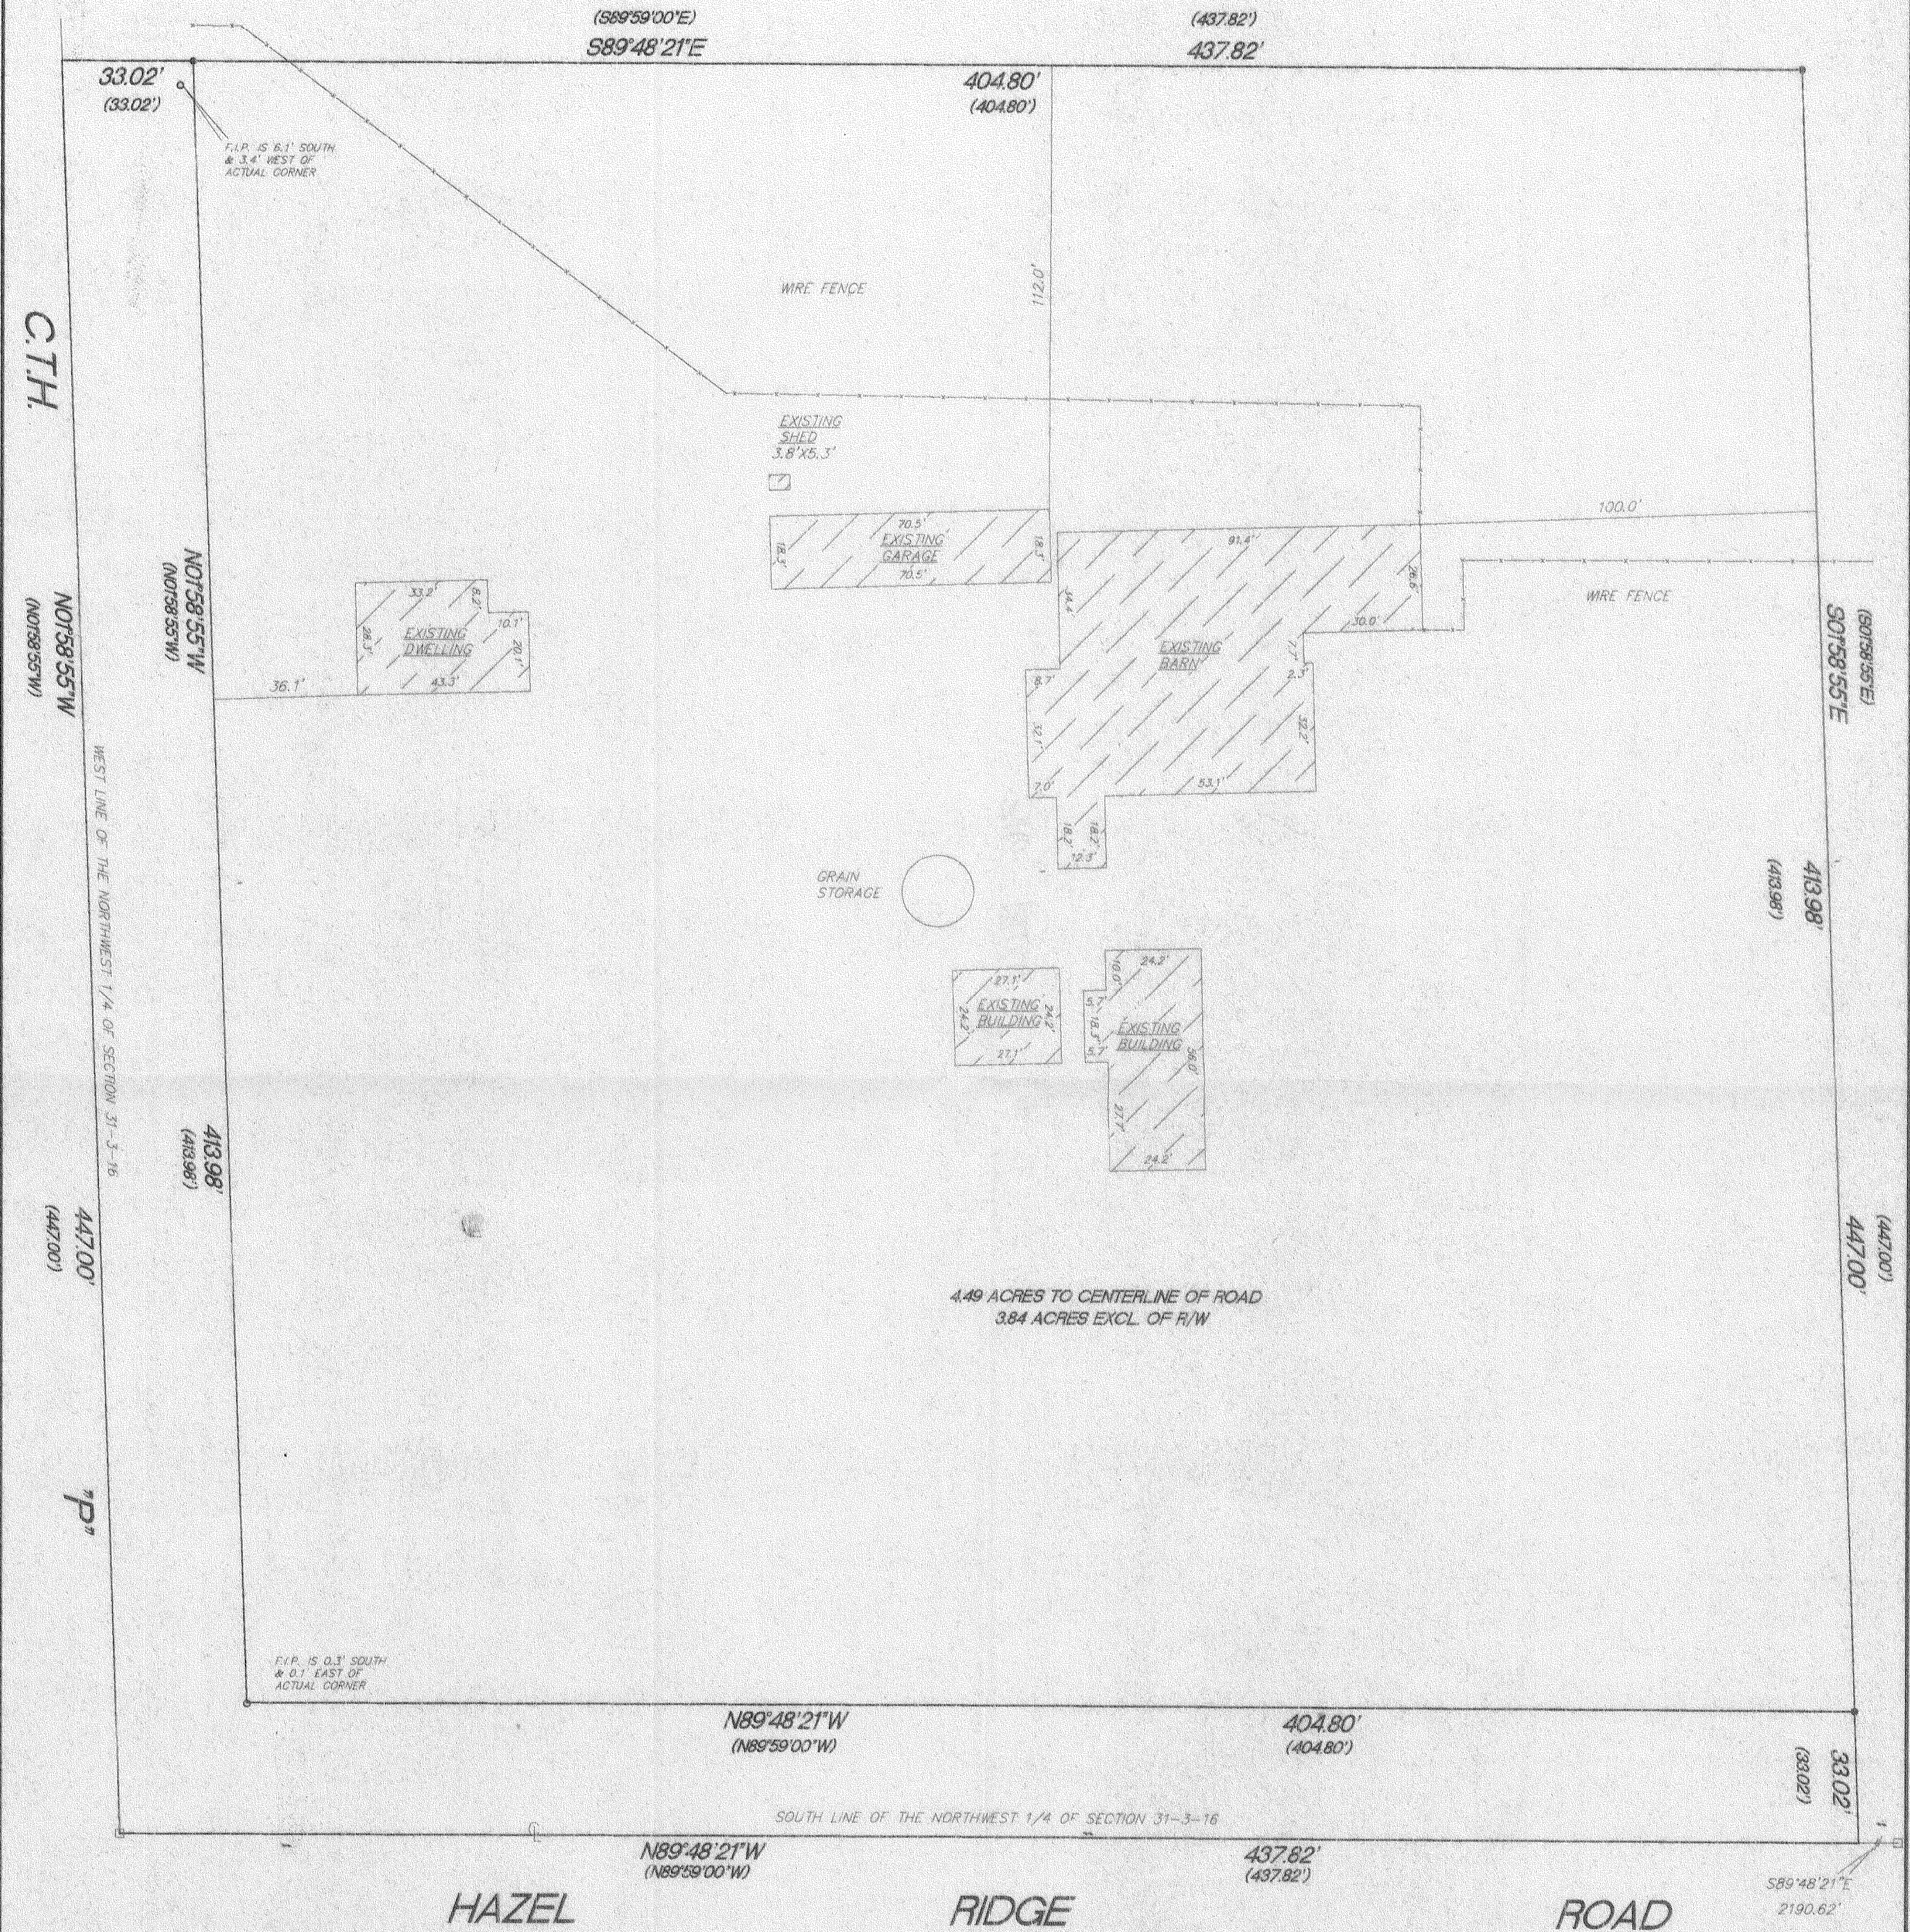


SCALE 1"=30'

"I hereby certify that I have surveyed the above property and that the above map is a true representation thereof and shows the size and location of the property exterior boundaries, the location of all visible structures and dimensions of all principal buildings thereon, boundary fences, apparent easements, roadways and encroachments if any."

"This survey is made for the use of the present owners of the property, and also those who purchase, mortgage or guarantee the title thereto within one year from date hereof."

Kettle Moraine Surveying Inc.
P.O. Box 357
Eagle WI. 53119
(262)594-3484

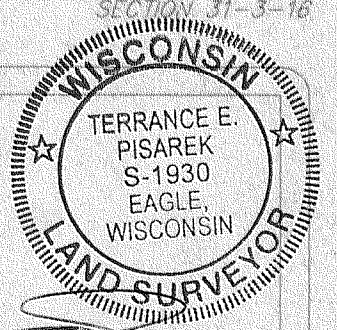

THIS IS NOT AN ORIGINAL SURVEY UNLESS THE SEAL IS RED.

9/7/06
DATE

TEP
FIELD WORK BY

TEP
DRAWN BY

06129
JOB NUMBER

GA2364-1

316-1866