
PLAT OF SURVEY

OF

LOT 9 BLOCK 104 OF LAKE WANDAWEGA SUBDIVISION, LOCATED IN THE S.E. 1/4 OF SECTION 2, T3N R16E, WALWORTH COUNTY, WISCONSIN

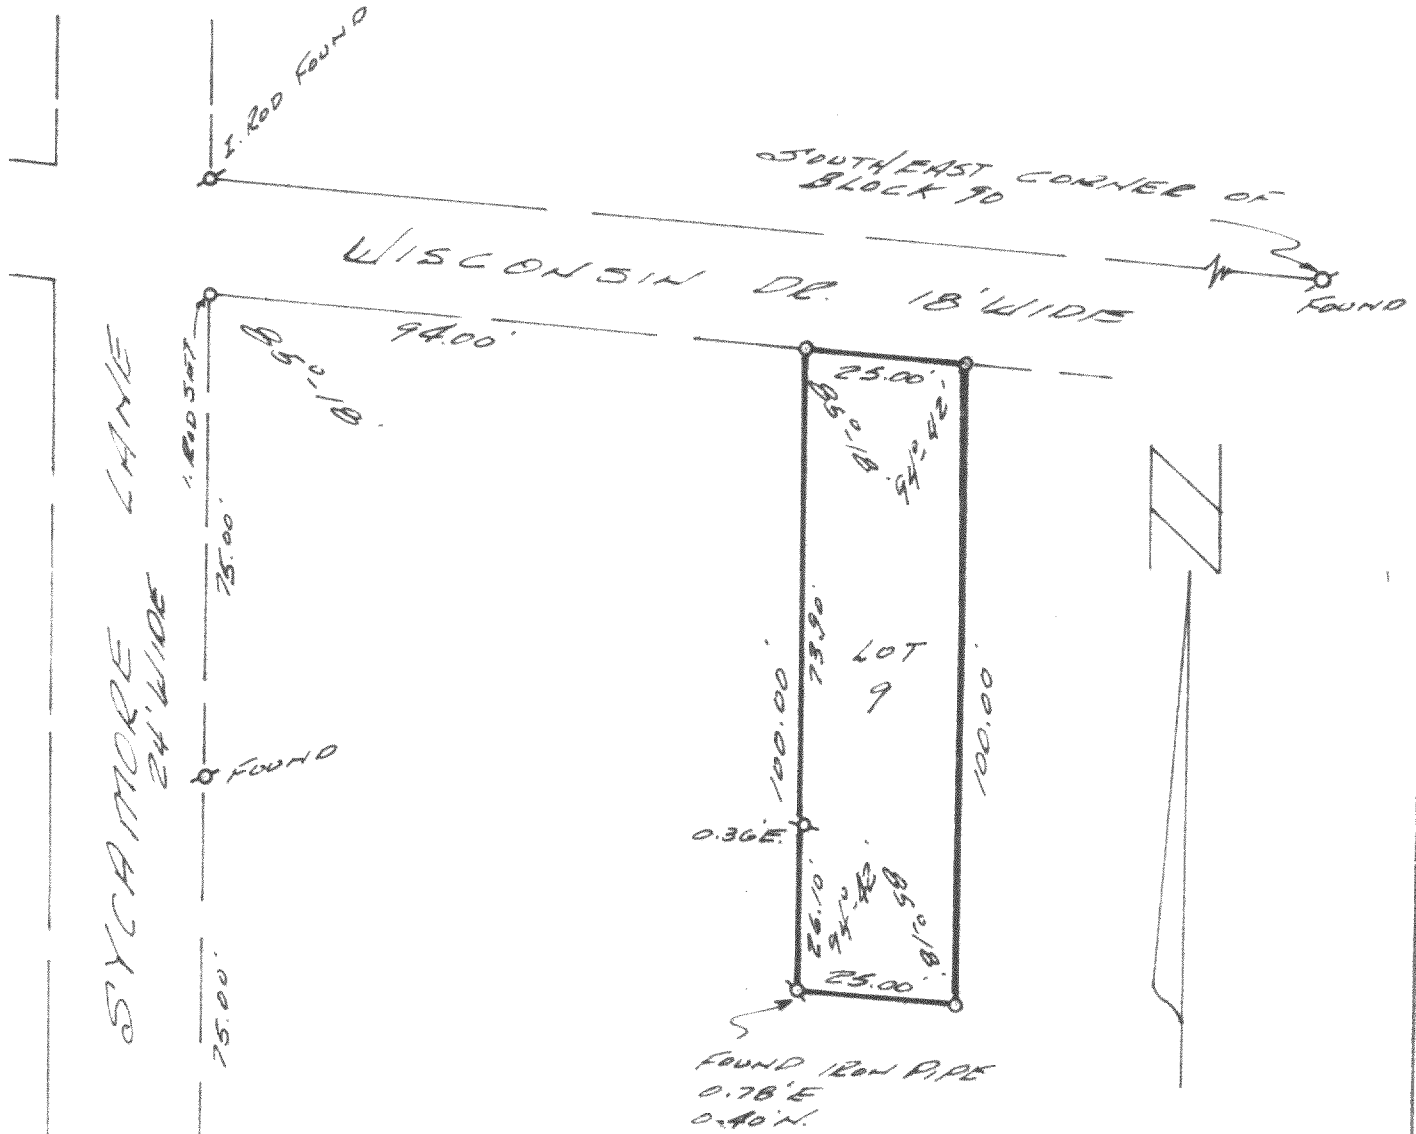

WISCONSIN
THOMAS P. A. JENSEN
S-1084
ELKHORN, WIS.
LAND SURVEYOR

SURVEY AND PLAT BY

JENSEN & JOHNSON, INC.

CIVIL ENGINEERS AND SURVEYORS

Elkhorn, Wisconsin

LEGEND

○ — Iron Pipe SET

● — Concrete Monument

Scale 1" = 30'

WE CERTIFY: That we have surveyed the above described property and that the plat shown hereon is an accurate survey and a true representation thereof and correctly shows the exterior boundary lines and all divisions of said property.

Date July 24, 1975 Thomas P.A. Jensen

T.P.A. [redacted] JENSEN,

Wisconsin Registered Land Surveyor, No. S-[redacted] 1084

GLW-264

PLSV 176H—500—11-83

316-193