Plat of Survey

of

Lots 17, 18 and 19 and Lots 40, 41 and 42 of Block R of North Lake Beach, Tract No. 2,

located in the Northwest 1/4 of Section 8, Town 3 North, Range 16 East, Town of Sugar Creek, Walworth County, Wisconsin.

Surveyed for: **Harrison Homes, LLC**
W6568 Barkers Road
Elkhorn, Wisconsin. 53121

RECEIVED
MAY - 2 2008

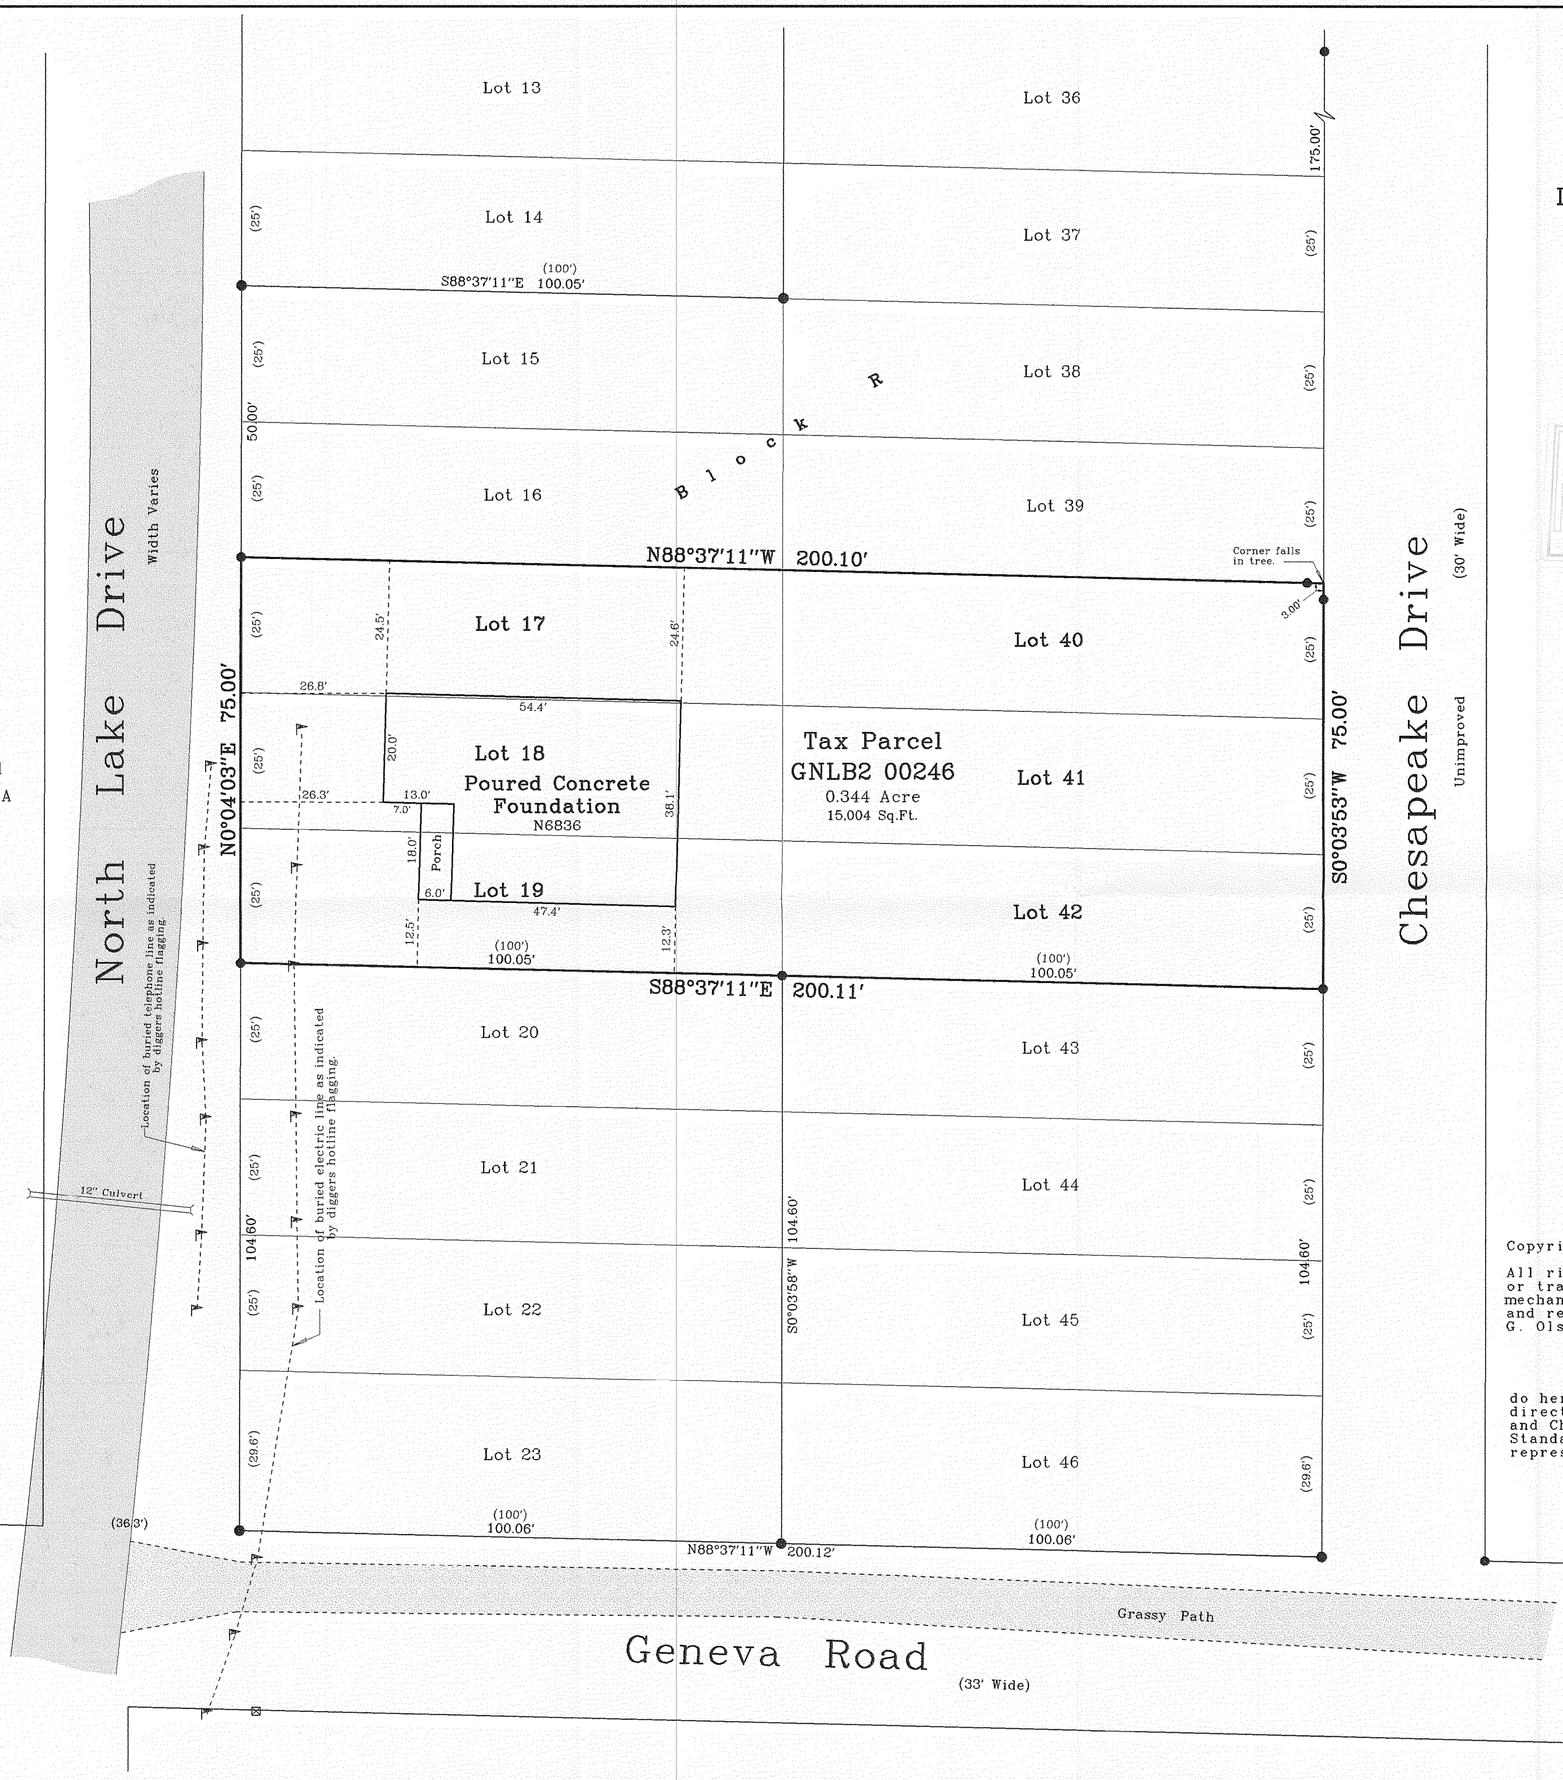

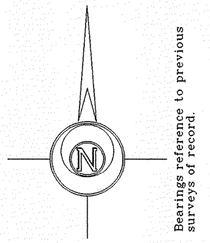

WISCONSIN
DOUGLAS G. OLSON
S-2093
ELKHORN, WI
LAND SURVEYOR
Not Certified Unless Stamped in Red.

Notes: 1) This survey plat is not certified unless signed and sealed in red ink.

2) This survey is subject to Wisconsin lien laws. This Plat of Survey is the notice of intent to file lien. Lien waiver required.

Copyright c 2007 by Jensen & Olson Land Surveying, LLC.

All rights reserved. No part of this survey plat may be reproduced or transmitted in any form by any means - graphic, electronic, or mechanical, including photocopying, tracing, or information storage and retrieval systems - without permission in writing from Douglas G. Olson, Jensen & Olson Land Surveying, LLC.

I, Douglas G. Olson, Wisconsin Registered Land Surveyor, do hereby certify that this survey was performed by me or under my direction in full compliance with the owner's/agent's instructions and Chapter A-E 7 of the Wisconsin Administrative Code "Minimum Standards for Property Surveys"; and that this map is an accurate representation thereof to the best of my knowledge and belief.

Douglas G. Olson
Wisconsin Registered Land Surveyor - 2093

Survey Date: November 13, 2007.
Revisions: No. 1 - Proposed House
No. 2 - Foundation

Scale in Feet
1" = 20'
0' 10' 20' 40'

Jensen & Olson Land Surveying, LLC
45 South Wisconsin Street P.O. Box 322
Elkhorn, Wisconsin. 53121
Telephone (262) 723-3434
Facsimile (262) 723-8044

Legend
Found Iron Rod, 3/4" dia.
Found Spindle
Recorded Information
Utility Pedestal
Diggers Hotline Flag
Asphalt Surface

Sheet 1 of 1 Sheets

Job Reference Number
2007.158
t3nr16e-2007158new-2007158ex2.590

2007.158

GNLB2-246

316-1978