


PLAT OF SURVEY

LOTS 11, 12, 13, 14, 26, 27, AND 28 BLOCK 2 AND LOT 16 OF BLOCK 5,
BLUE WING ESTATES, A SUBDIVISION LOCATED IN TOWN 3 NORTH,
RANGE 16 EAST, TOWN OF SUGAR CREEK, COUNTY OF WALWORTH
AND STATE OF WISCONSIN.

PATHFINDER SURVEYING INC.
(formerly)
J.K. SURVEYING INC.
P.O. BOX 322
LAKE GENEVA, WI. 53147
WWW.PATHFINDERSURVEYING.NET
262-248-8303

TAYLOR AVE.
(platted as 30' wide)

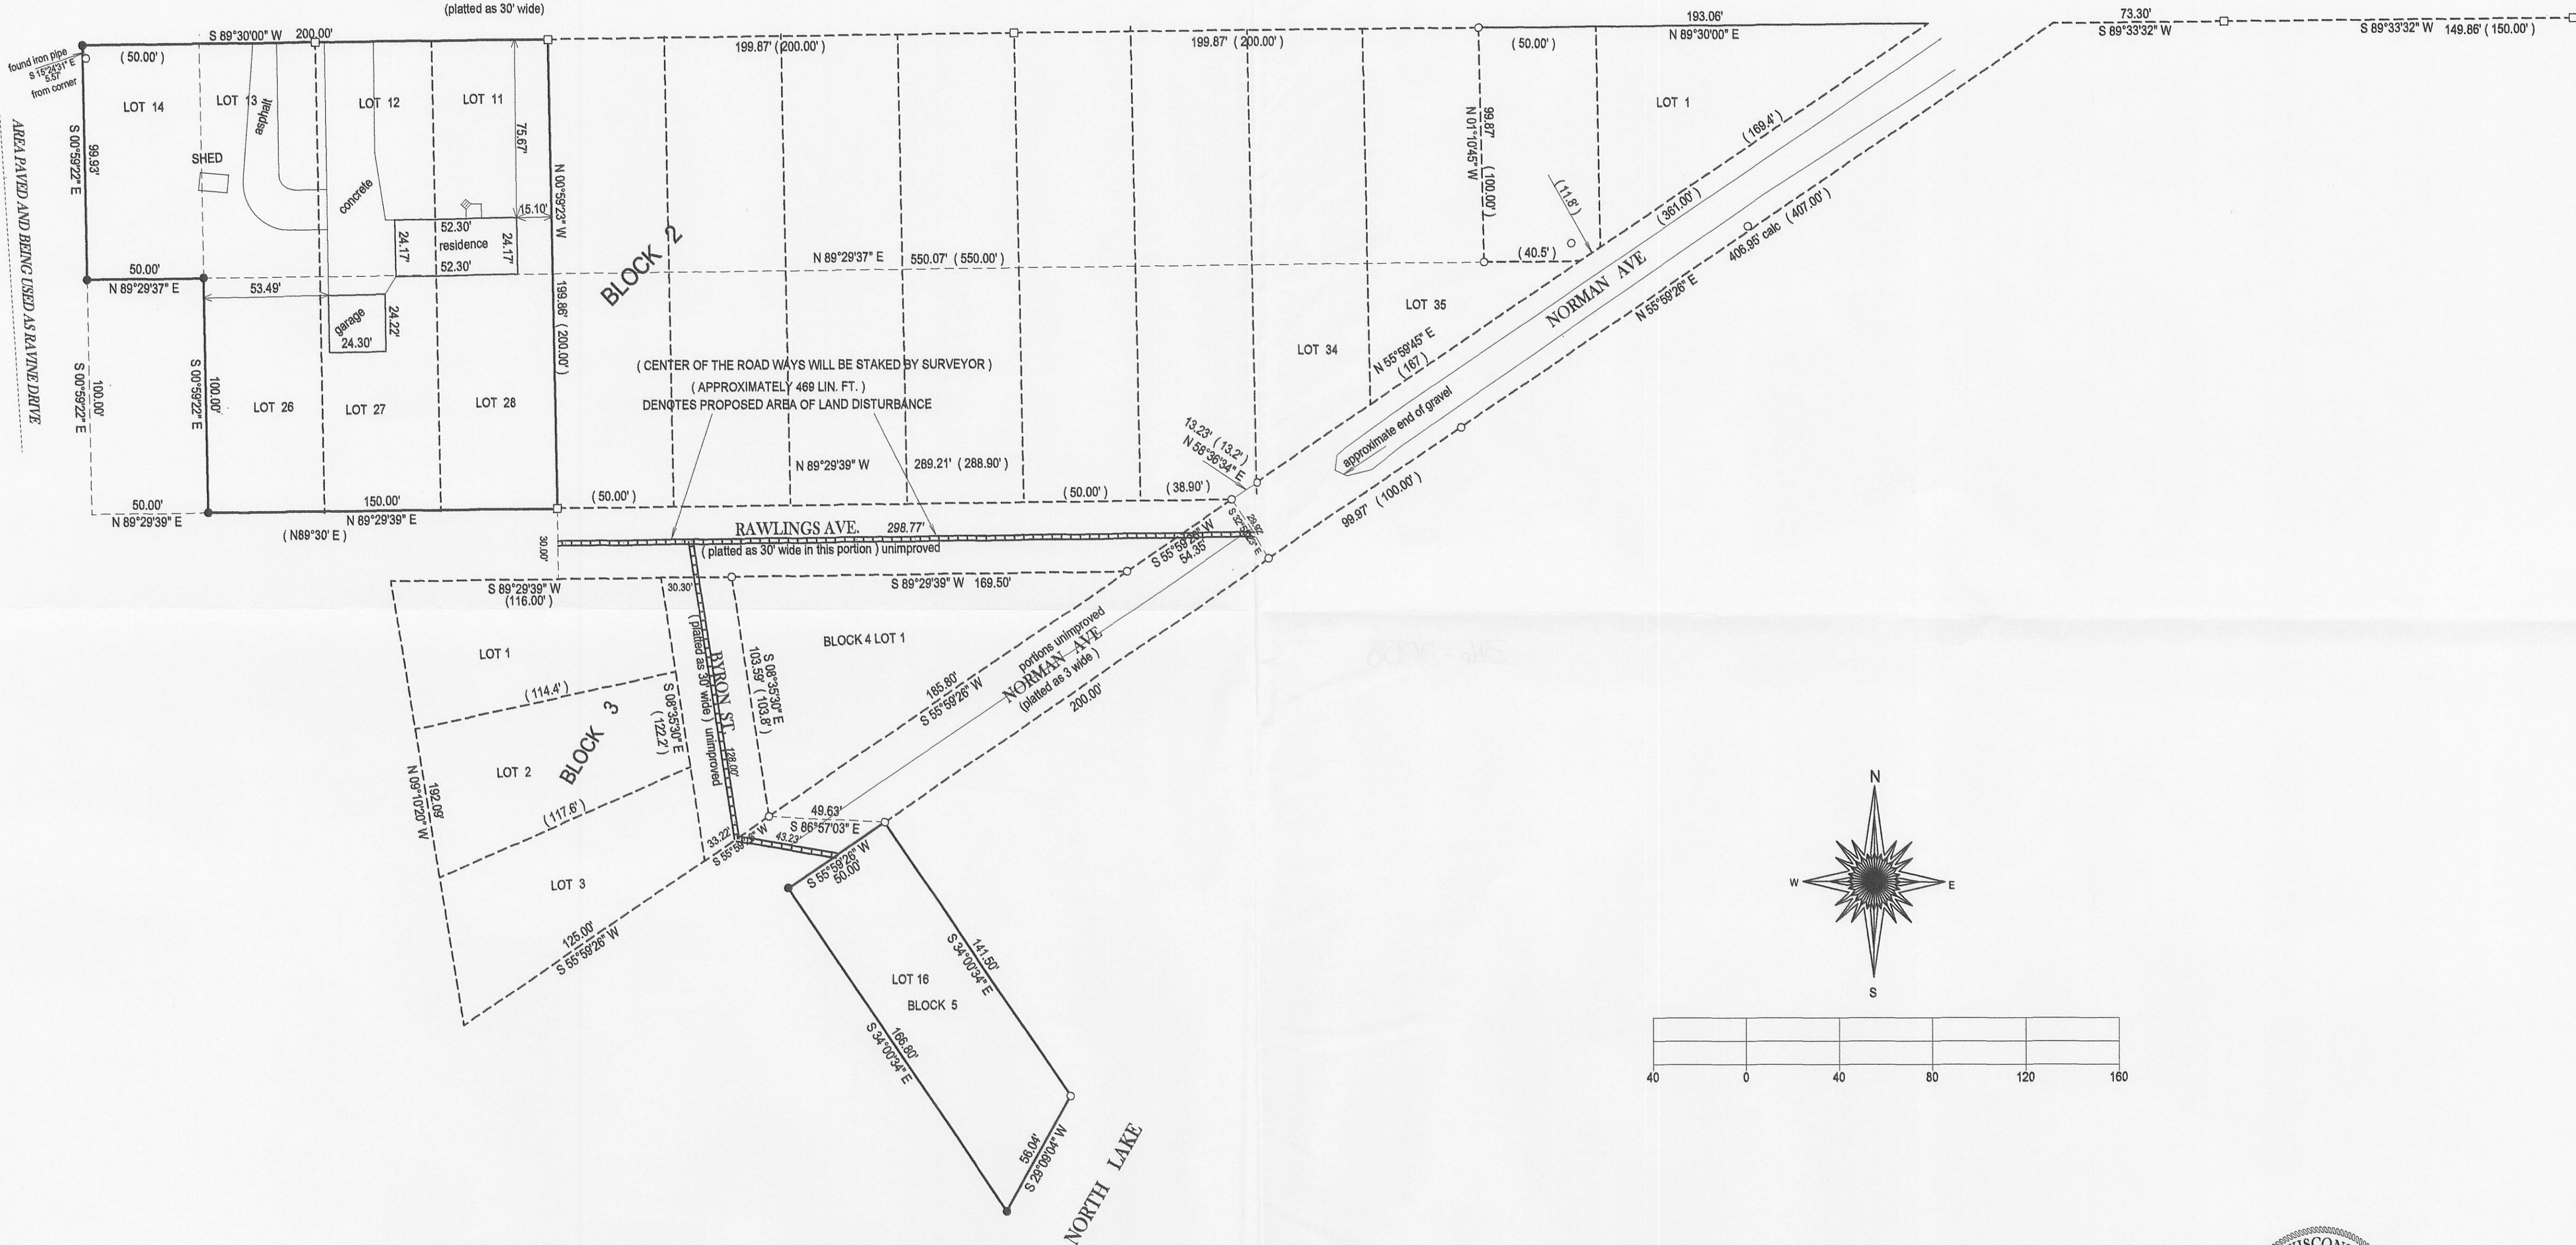

() = recorded as
□ = found iron bar
○ = found iron pipe
● = set iron pipe
■ = set iron bar





SCALE 1" = 40'

JOB # 10-90

TAX ID # GBW 00005C, 000006 AND 00009A

"I hereby certify that I have surveyed the above described property and that the above map is a true representation of its exterior boundary and shows the size and location of all visible structures, apparent easements and encroachments if any."

This survey is made for the present owners of the property, and those who purchase, mortgage, or guarantee the title thereto, within one year from the date hereof.

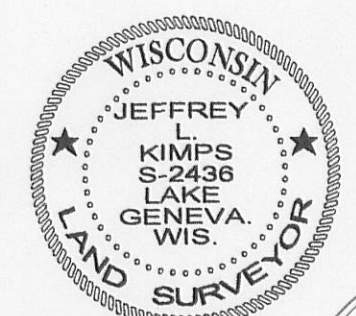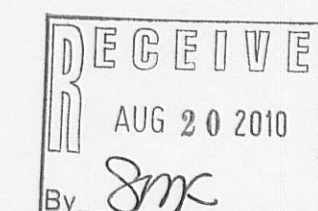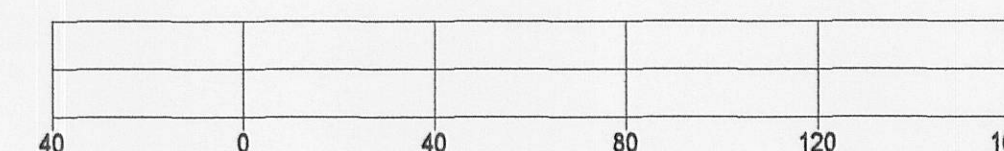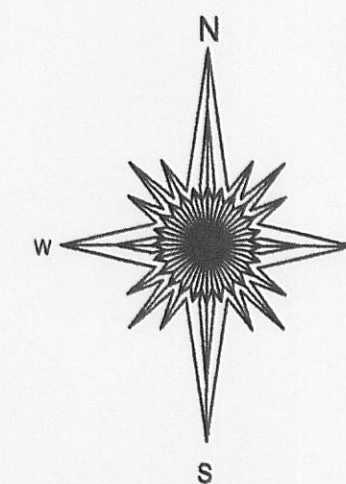

JEFFREY L. KIMPS S-2436
Wisconsin Registered Land Surveyor
(original if signed in red)

316-2058 316-5089