


— WORK ORDERED BY —
C/O KATHY SHEAHAN
HELEN TOTAL CONSTRUCTION
PO BOX 17
ELKHORN, WISCONSIN 53121

FARRIS, HANSEN & ASSOCIATES, INC.
ENGINEERING — ARCHITECTURE — SURVEYING
7 RIDGWAY COURT P.O. BOX 437
ELKHORN, WISCONSIN 53121
OFFICE: (262) 723-2098 FAX: (262) 723-5886

REVISIONS

PROJECT NO.	8387
DATE:	05/22/2000
SHEET NO.	1 OF 2

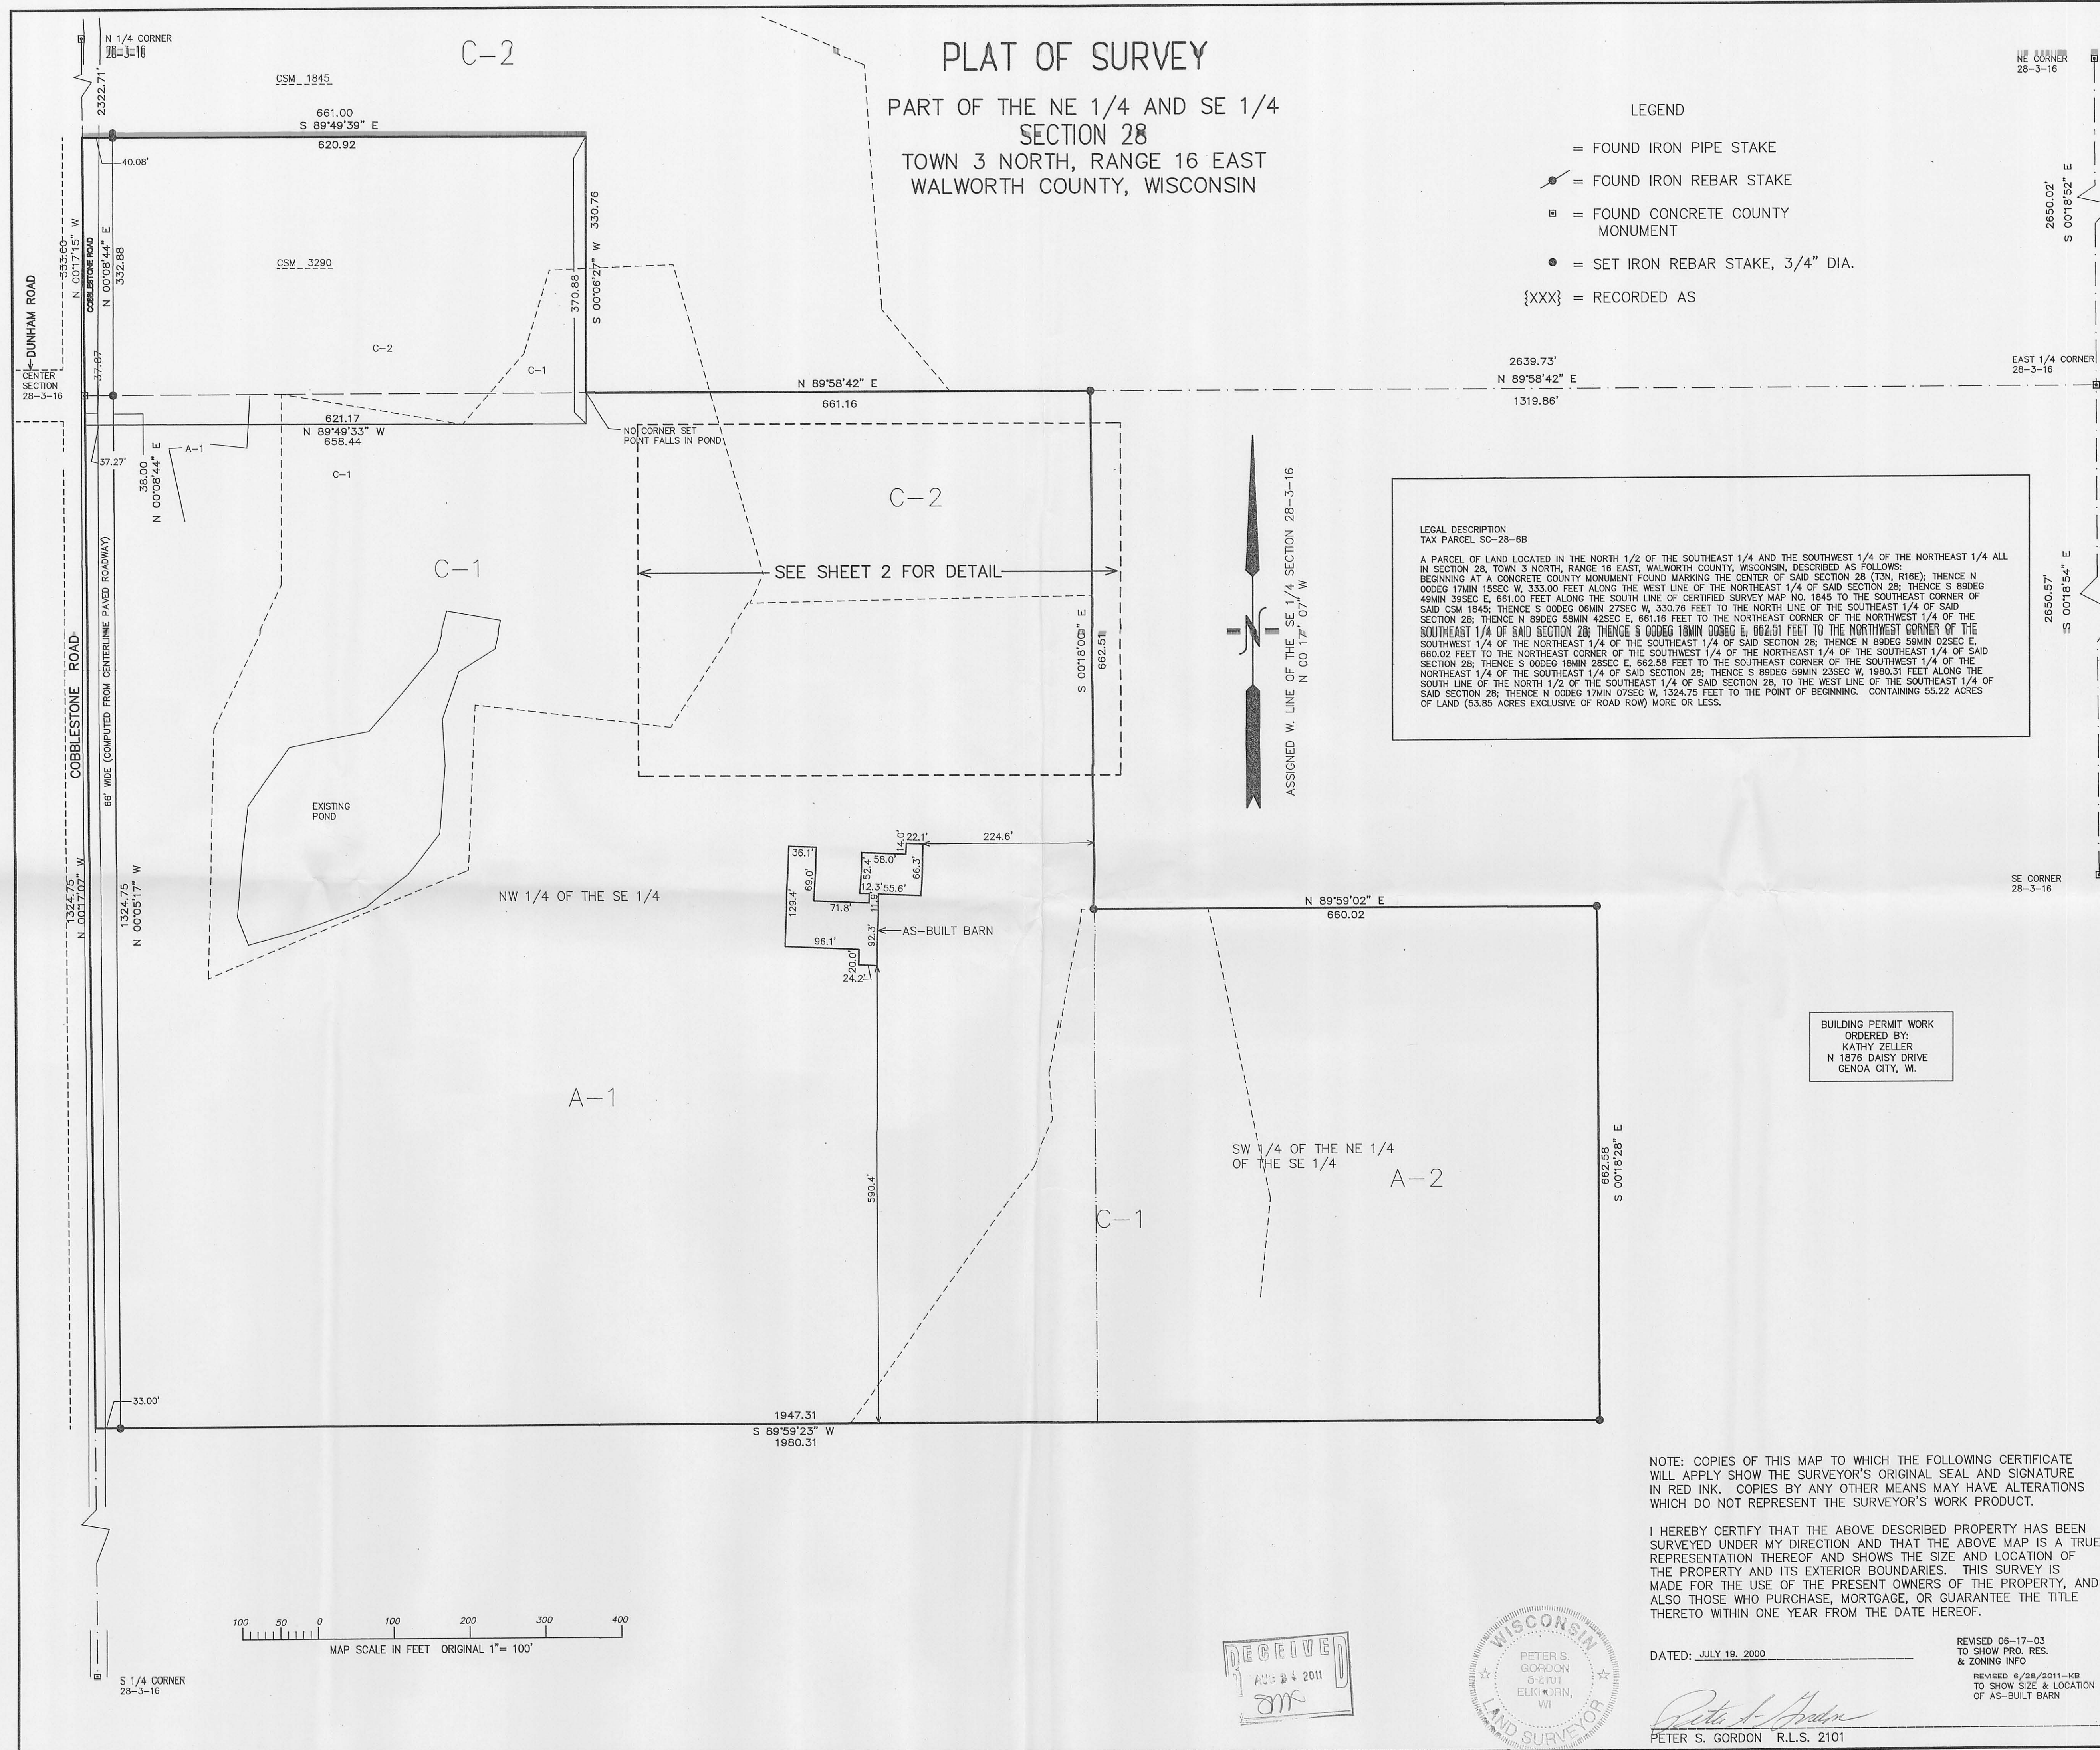

GSC 28-6B

316-2089



20' SIDE YARD SETBACK

C-1 ZONING

C-2 ZONING

C-2 ZONING

C-2 ZONING

C-2 ZONING

A-1 ZONING

A-1 ZONING

A-1 ZONING

C-1 ZONING

EXISTING EDGE OF POND
POND EL. = 1011'

EXISTING TREE/BRUSH LINE (TYPICAL)

BENCH MARK
NAIL IN SIDE OF
12" WILLOW TREE
ELEVATION=1014.19'

ZONING LINE (TYPICAL)

EXTG. 12" ADS
IE=1013.7' SE
IE=1013.8' NW

EXISTING TRANSFORMER

EXISTING GRAVEL DRIVE

100' REAR YARD SETBACK

