


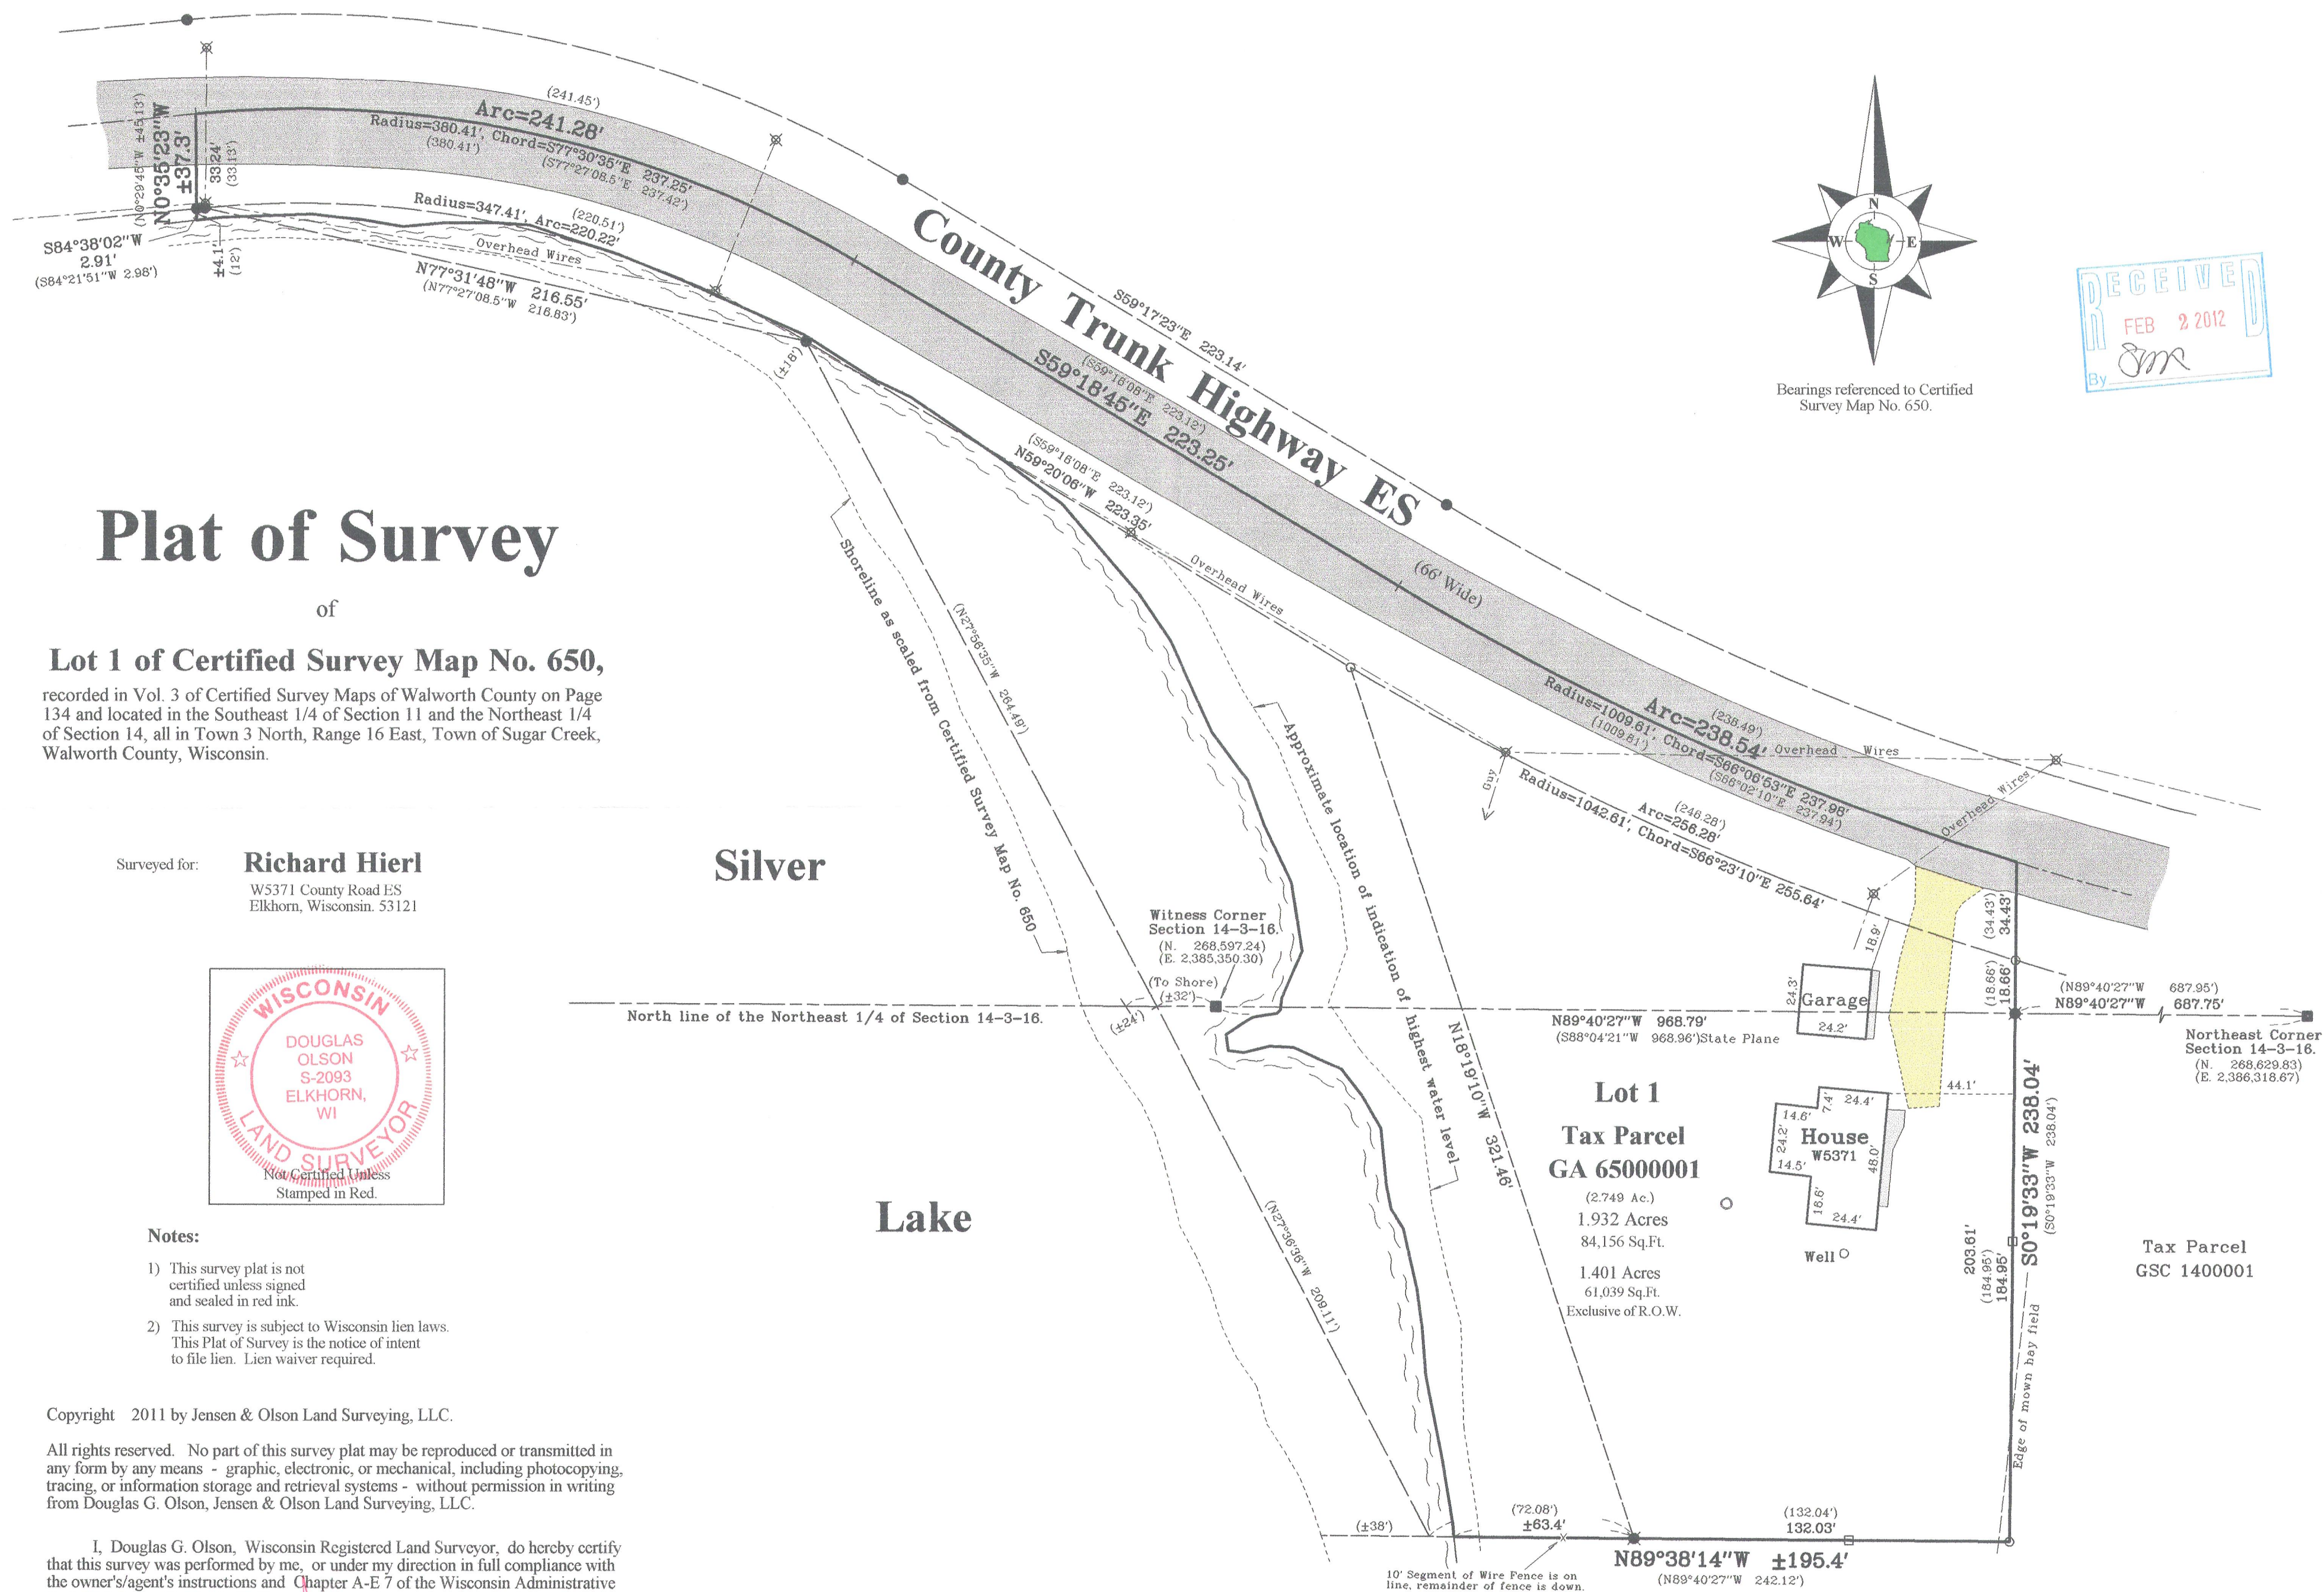

Jensen & Olson Land Surveying, LLC
45 South Wisconsin Street * P.O. Box 322 * Elkhorn, Wisconsin. 53121
Telephone: (262) 723-3434 * Facsimile: (262) 723-8044
Email: jensen.olson@elknet.net

Legend

Found County Section Corner
Set Iron Rod 1-3/4" dia.
Recorded Information
Utility Pole
Concrete Cover
Asphalt Surface
Gravel

Sheet 1 of 1 Sheets
Drawing Name: GA 650-2011030-2011030.dwg
Job Reference Number
2011.030

2011.030

GA 650-1

316-2107