
# PLAT OF SURVEY

PREPARED FOR
MARCEY JOHNSON
KEEFE REAL ESTATE
1040 N. WISCONSIN ST.
ELKHORN WI. 53121

-OF-

LOTS 17 THRU 22 AND LOTS 27 THRU 32 IN BLOCK 56 IN LAKE WANDAWEGA SUBDIVISION A SUBDIVISION LOCATED IN SECTIONS 1 AND 2, TOWN 3 NORTH, RANGE 16 EAST, WALWORTH COUNTY, WISCONSIN.

KROTT SURVEYING INC.
N3705 WILLOW BEND LANE
LAKE GENEVA WI. 53147
PHONE # (262)248-3697
FAX # (262)249-0639

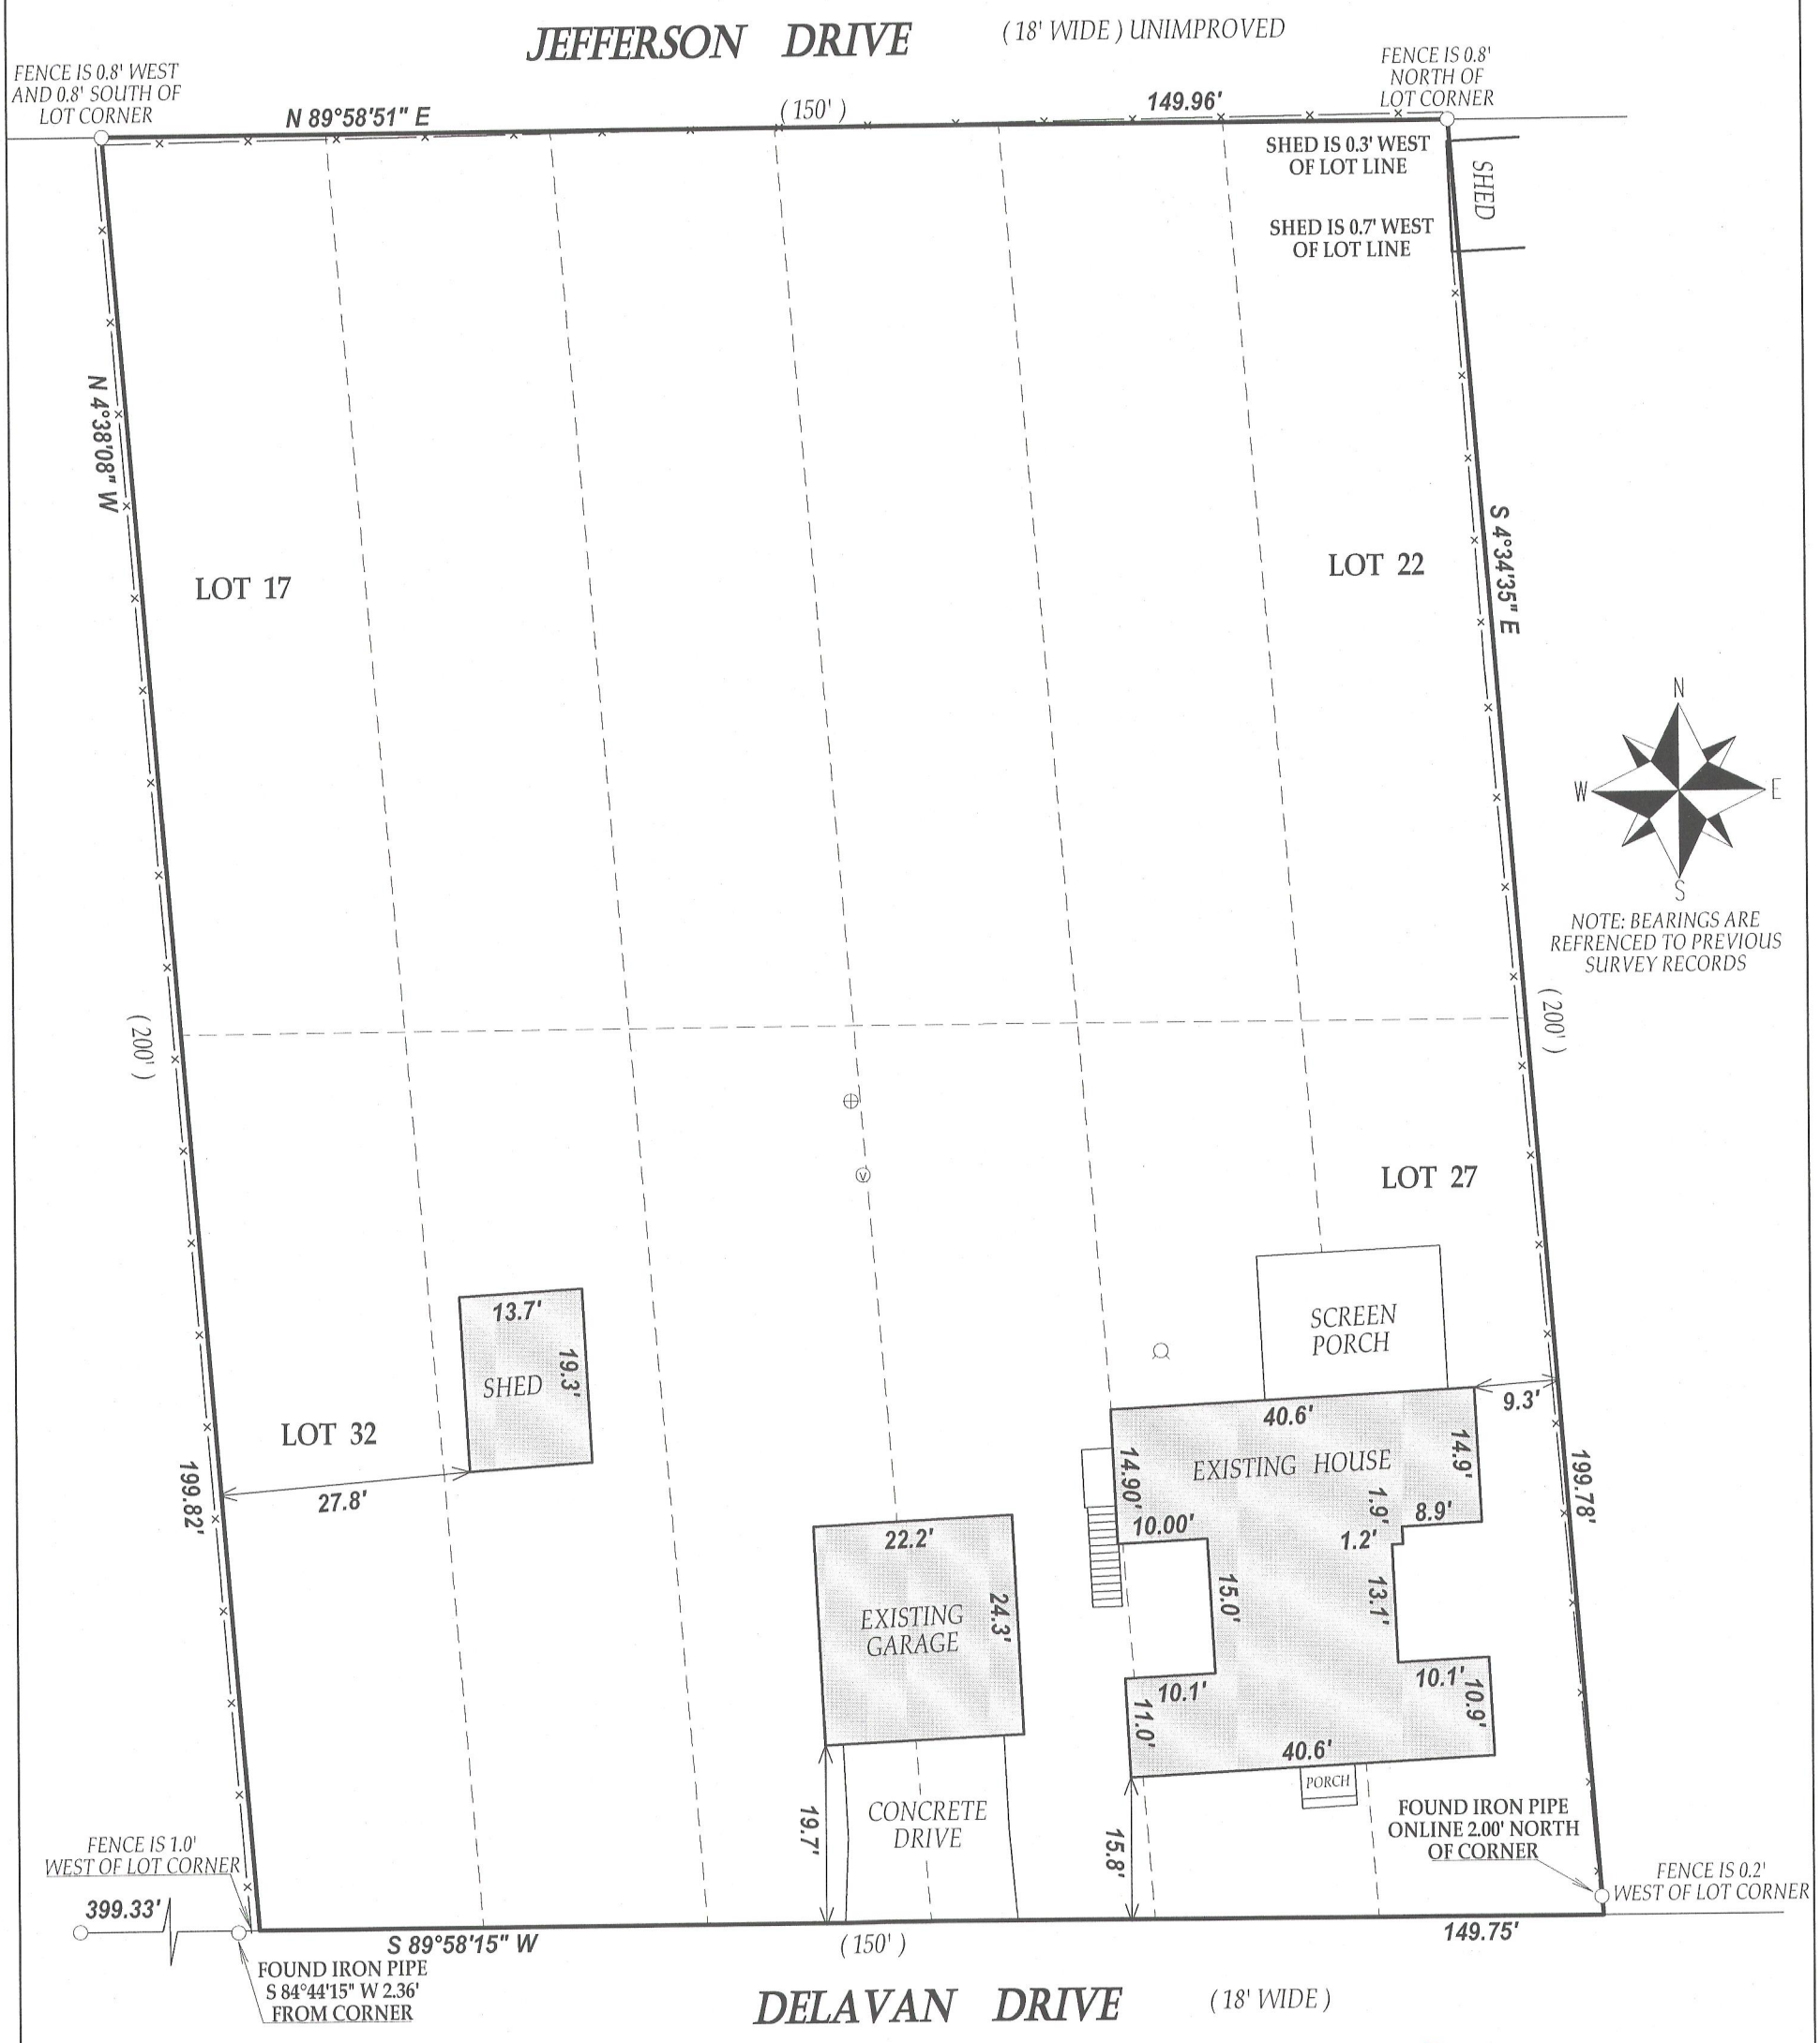


LEGEND

- ○ FOUND IRON PIPE
- ⊕ CONCRETE LID
- ⌾ WELL
- ⓥ VENT
- (XX) RECORDED AS

TAX ID # GLW00092, 94 & 95

JOB # 11-170

SCALE 1" = 20'

0 20 40 60

I have surveyed the above-described property and the above map is a true representation thereof and shows the size and location of the property, its exterior boundaries, the location and dimensions of all structures thereon, fences apparent easements and roadways and visible encroachments. if any.

This survey is made for the exclusive use of the present owners of the property, and also those who puchase, mortgage,or insure the title therto within one (1) year from date hereof; and as to them I warrant the accuracy of said survey map.

WISCONSIN
JOHN P. KROTT
S-2258
LAKE GENEVA WIS.
LAND SURVEYOR

RECEIVED
APR 18 2012
By

DATED THIS 5th DAY OF DECEMBER 2011.

JOHN KROTT S - 2258
Wisconsin Registered Land Surveyor
( original if signed in red )

316-211