
PREPARED FOR
ROBERT PESKA
W5127 HAWKHUNTER RD.
ELKHORN WI. 53121


PLAT OF SURVEY

-OF-

LOTS 28, 29 AND 30, BLOCK 102, LAKE WANDAWEGA SUBDIVISION, LOCATED IN SECTIONS 1 AND 2, TOWN 3 NORTH, RANGE 16 EAST, TOWN OF SUGAR CREEK WALWORTH COUNTY, WISCONSIN.

KROTT SURVEYING INC.
N3705 WILLOW BEND LANE
LAKE GENEVA WI. 53147
PHONE # (262)248-3697
FAX # (262)249-0639

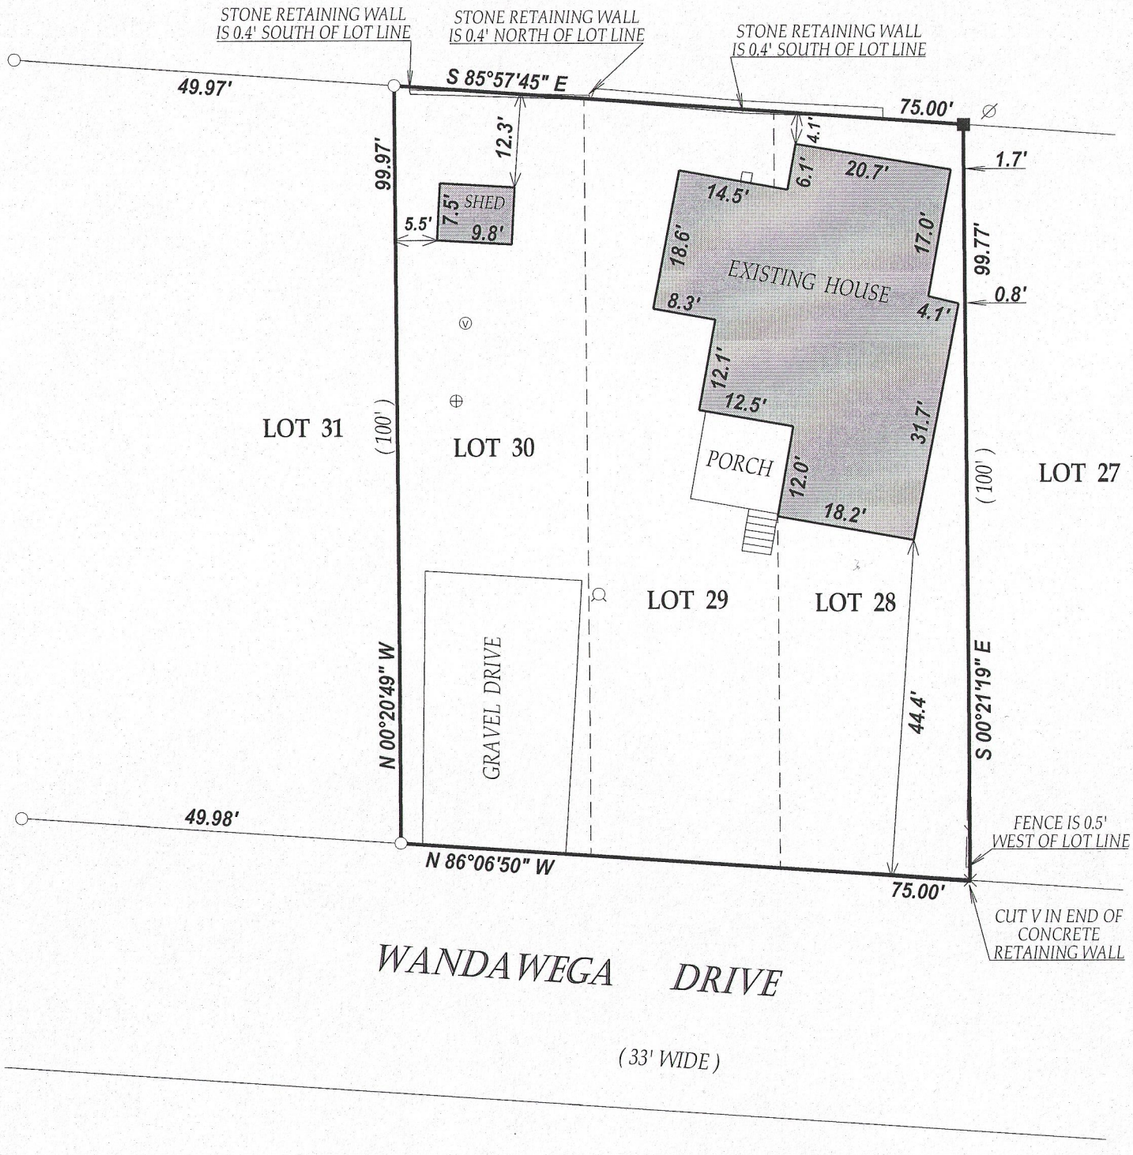

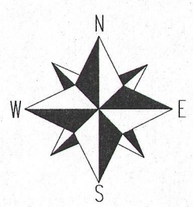

SCALE 1" = 20'

0 20 40 60

NOTE : BEARINGS ARE REFRENCED TO PREVIOUS SURVEY RECORDS

RECEIVED
JUN 27 2013
By

WISCONSIN
JOHN P.
KROTT
S-2258
LAKE GENEVA
WIS.
LAND SURVEYOR

LEGEND

- ○ FOUND IRON PIPE
- ■ SET IRON BAR
- ⊕ CONCRETE ACCESS COVER
- Ⓥ VENT
- ⌾ WELL
- ⌀ UTILITY POLE
- (XX) RECORDED AS

TAX ID # GLW00239

JOB # 13-053

I have surveyed the above-described property and the above map is a true representation thereof and shows the size and location of the property, its exterior boundaries, the location and dimensions of all structures thereon, fences apparent easements and roadways and visible encroachments. if any.

This survey is made for the exclusive use of the present owners of the property, and also those who puchase, mortgage,or insure the title therto within one (1) year from date hereof, and as to them I warrant the accuracy of said survey map.

DATED THIS 6th DAY OF MAY 2013

JOHN KROTT S - 2258
Wisconsin Registered Land Surveyor
(original if signed in red)

316 - 2146