

Property Exhibit

of

Lot 1 of Certified Survey Map No. 4489,

recorded in Vol. 29 of Certified Survey Maps of Walworth County on Page 170 and located in the Southwest 1/4 of the Northwest 1/4 of Section 33, Town 3 North, Range 16 East, Town of Sugar Creek, Walworth County, Wisconsin.

Tax Parcel
GSC 3300001B


Surveyed for:

**Dorothy O. McDonough Revocable
Living Trust Dated June 24, 2009**

c/o


Jayne Mann, Trustee

S103W20814 Heather Lane
Muskego, Wisconsin. 53150

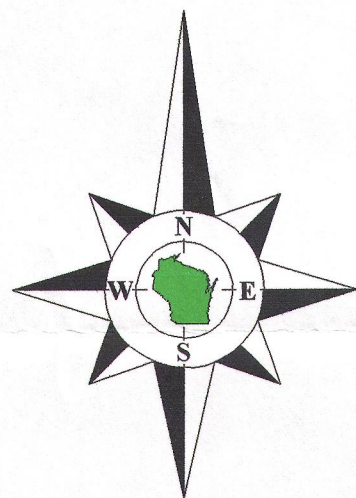

Bearings reference to the Wisconsin State
Plane Coordinate System, South Zone.

Tax Parcel
GSC 3300001B

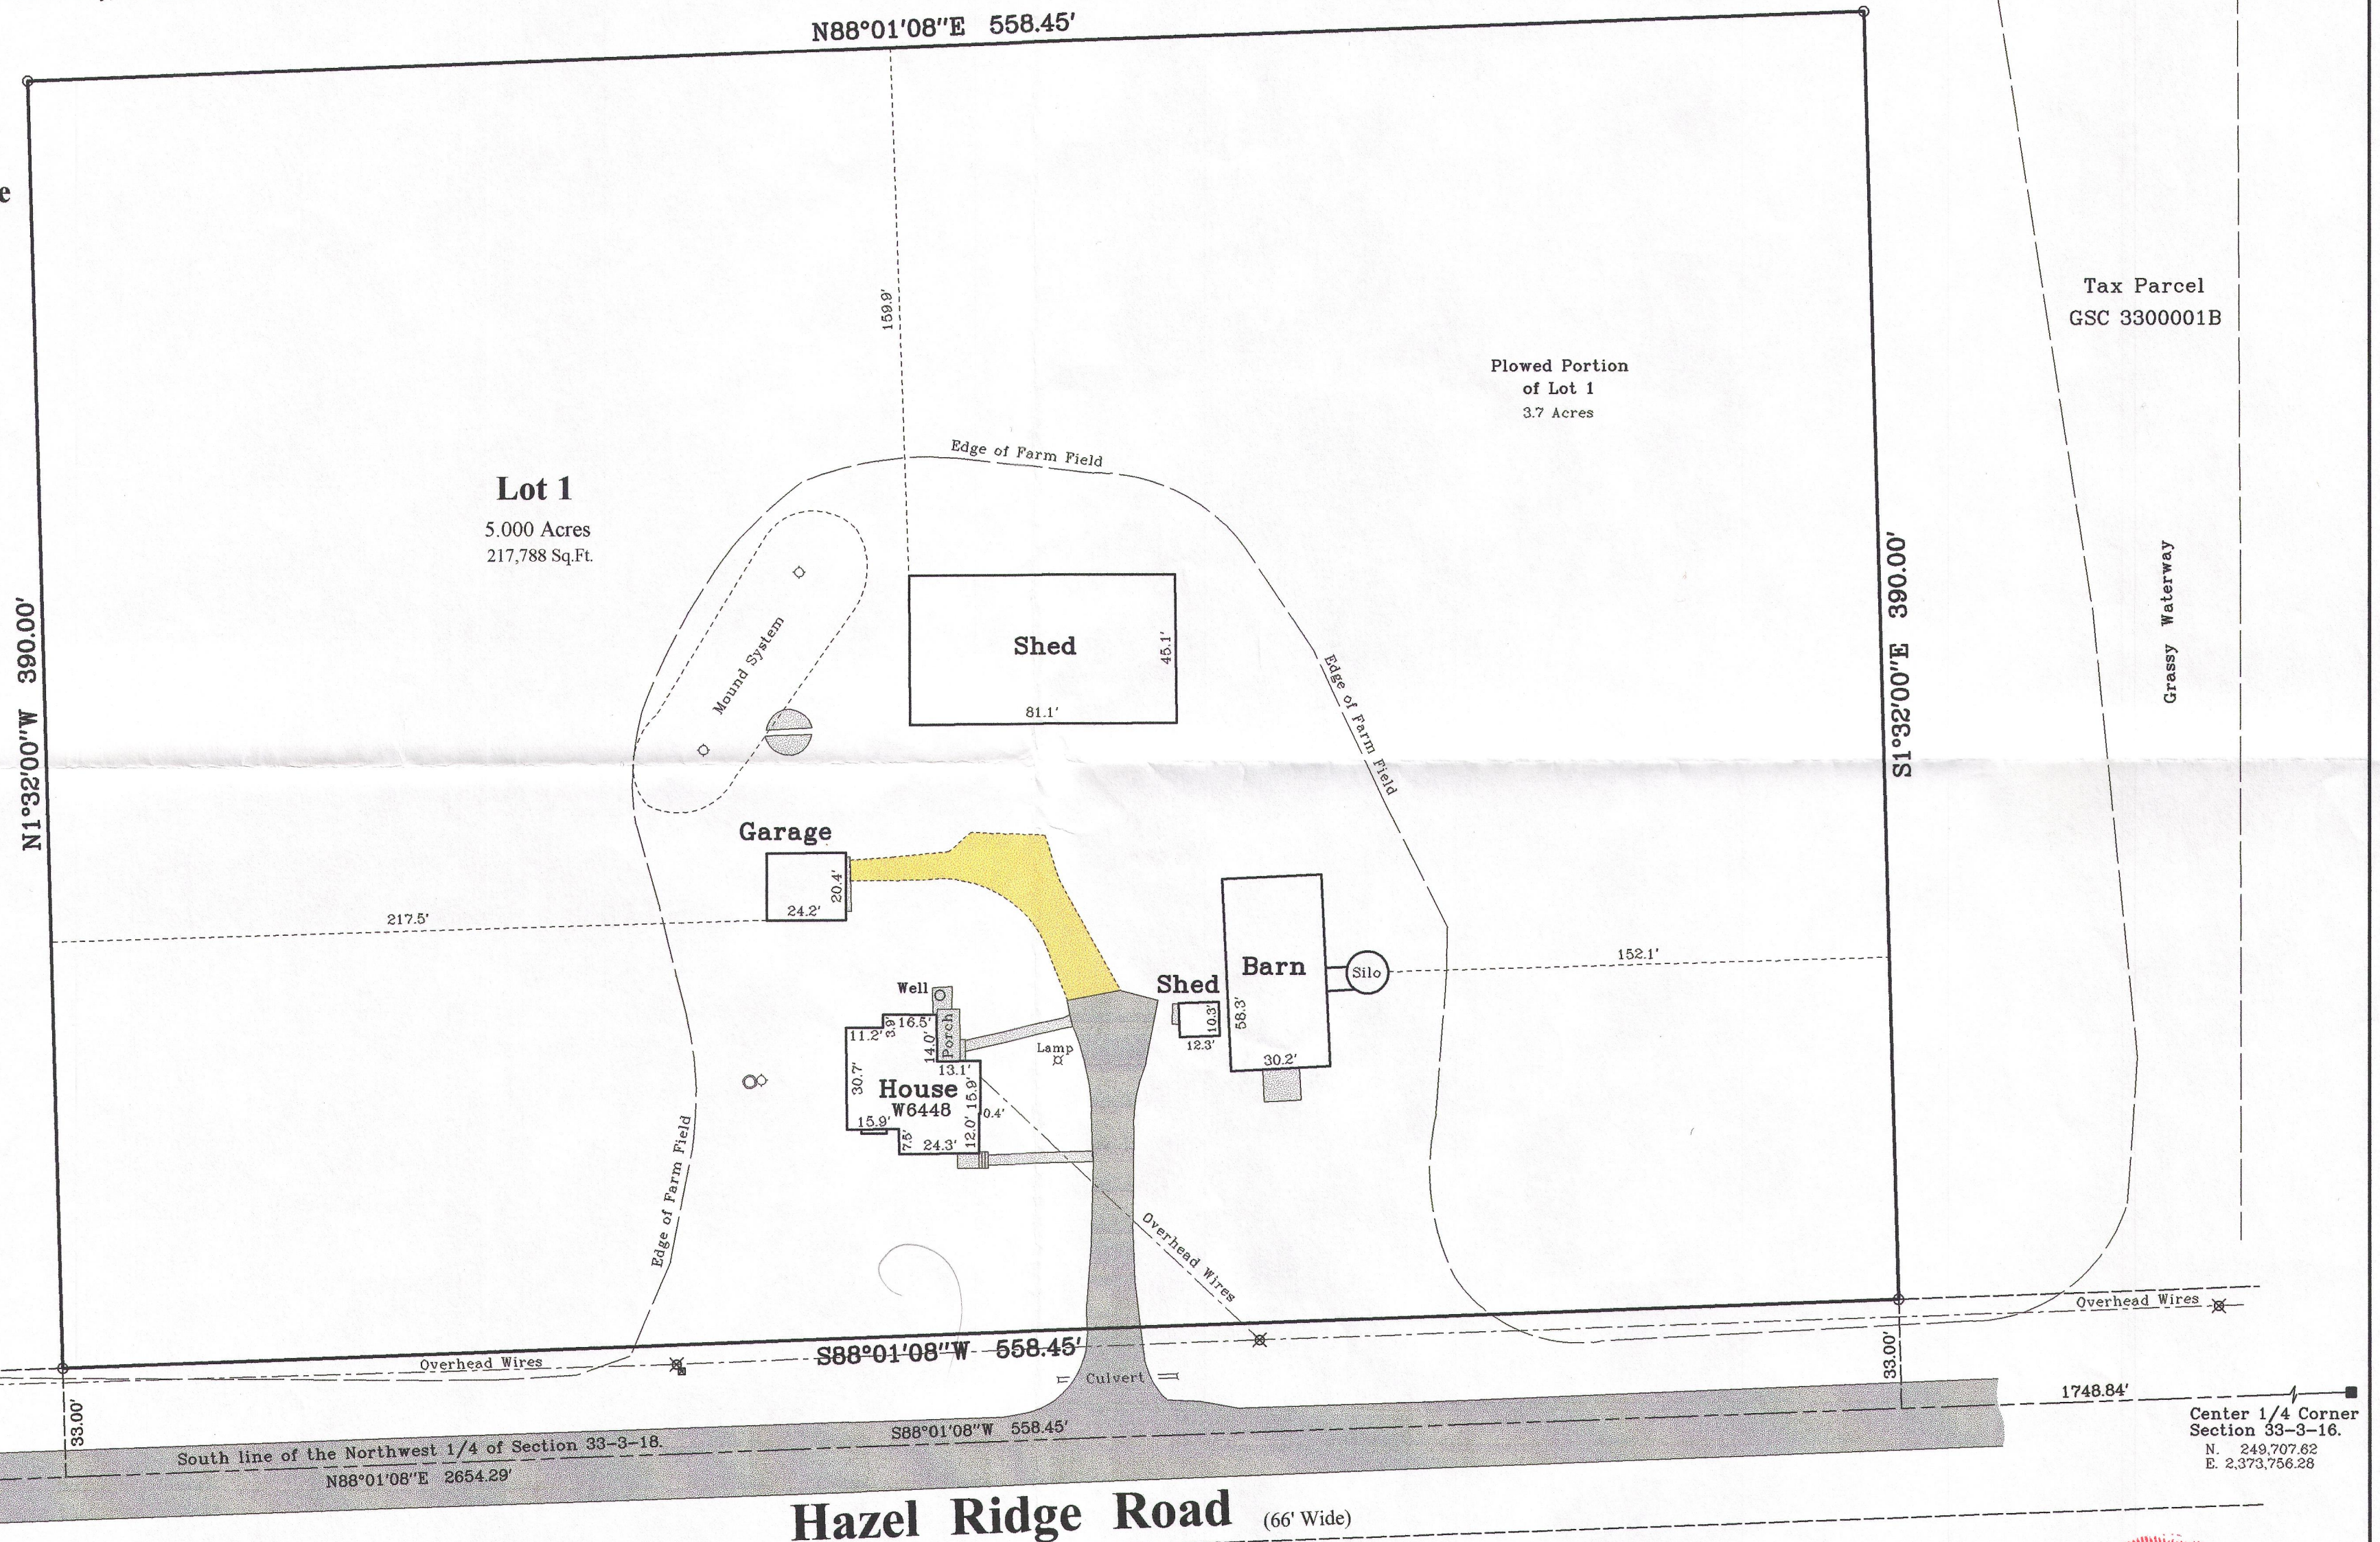

West 1/4 Corner
Section 33-3-16.
N. 249,615.86
E. 2,371,103.68

Copyright 2013 by Jensen & Olson Land Surveying, LLC.


All rights reserved. No part of this survey plat may be reproduced or transmitted in any form by any means - graphic, electronic, or mechanical, including photocopying, tracing, or information storage and retrieval systems - without permission in writing from Douglas G. Olson, Jensen & Olson Land Surveying, LLC.

I, Douglas G. Olson, Wisconsin Registered Land Surveyor, do hereby certify that this survey was performed by me, or under my direction in full compliance with the owner's/agent's instructions and Chapter A-E 7 of the Wisconsin Administrative Code "Minimum Standards for Property Surveys"; and that this map is an accurate representation thereof to the best of my knowledge and belief.

Douglas G. Olson
Wisconsin Registered Land Surveyor - 2093

Notes:

- 1) This Property Exhibit is not an original unless signed and sealed in red ink.
- 2) This exhibit is subject to Wisconsin lien laws. This Property Exhibit is the notice of intent to file lien. Lien waiver required.

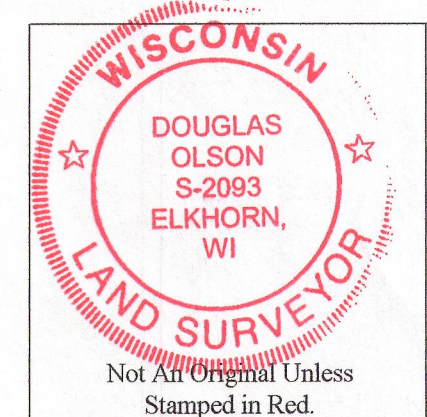

Survey Date: May 6, 2013.
Revisions: No. 1 - Grassy Waterway
No. 2 - C.S.M. Recorded

Scale in Feet
1" = 40'
0' 20' 40' 80'

Jensen & Olson Land Surveying, LLC

45 South Wisconsin Street * P.O. Box 322 * Elkhorn, Wisconsin. 53121
Telephone: (262) 723-3434 * Facsimile: (262) 723-8044
Email: jensen.olson@elknet.net

Legend
Found County Section Corner
Set Iron Pipe, 1" dia.
Recorded Information
Utility Pole
Concrete Cover
Septic Tank
Separate Surface
Concrete Surface
Gravel

Sheet 1 of 1 Sheets
Job Reference Number
2013.040

2013.040

GA4489-1

316-2150