


NOV 18 2014

11/18/2014 X:\Projects\9166\DCAD\Survey

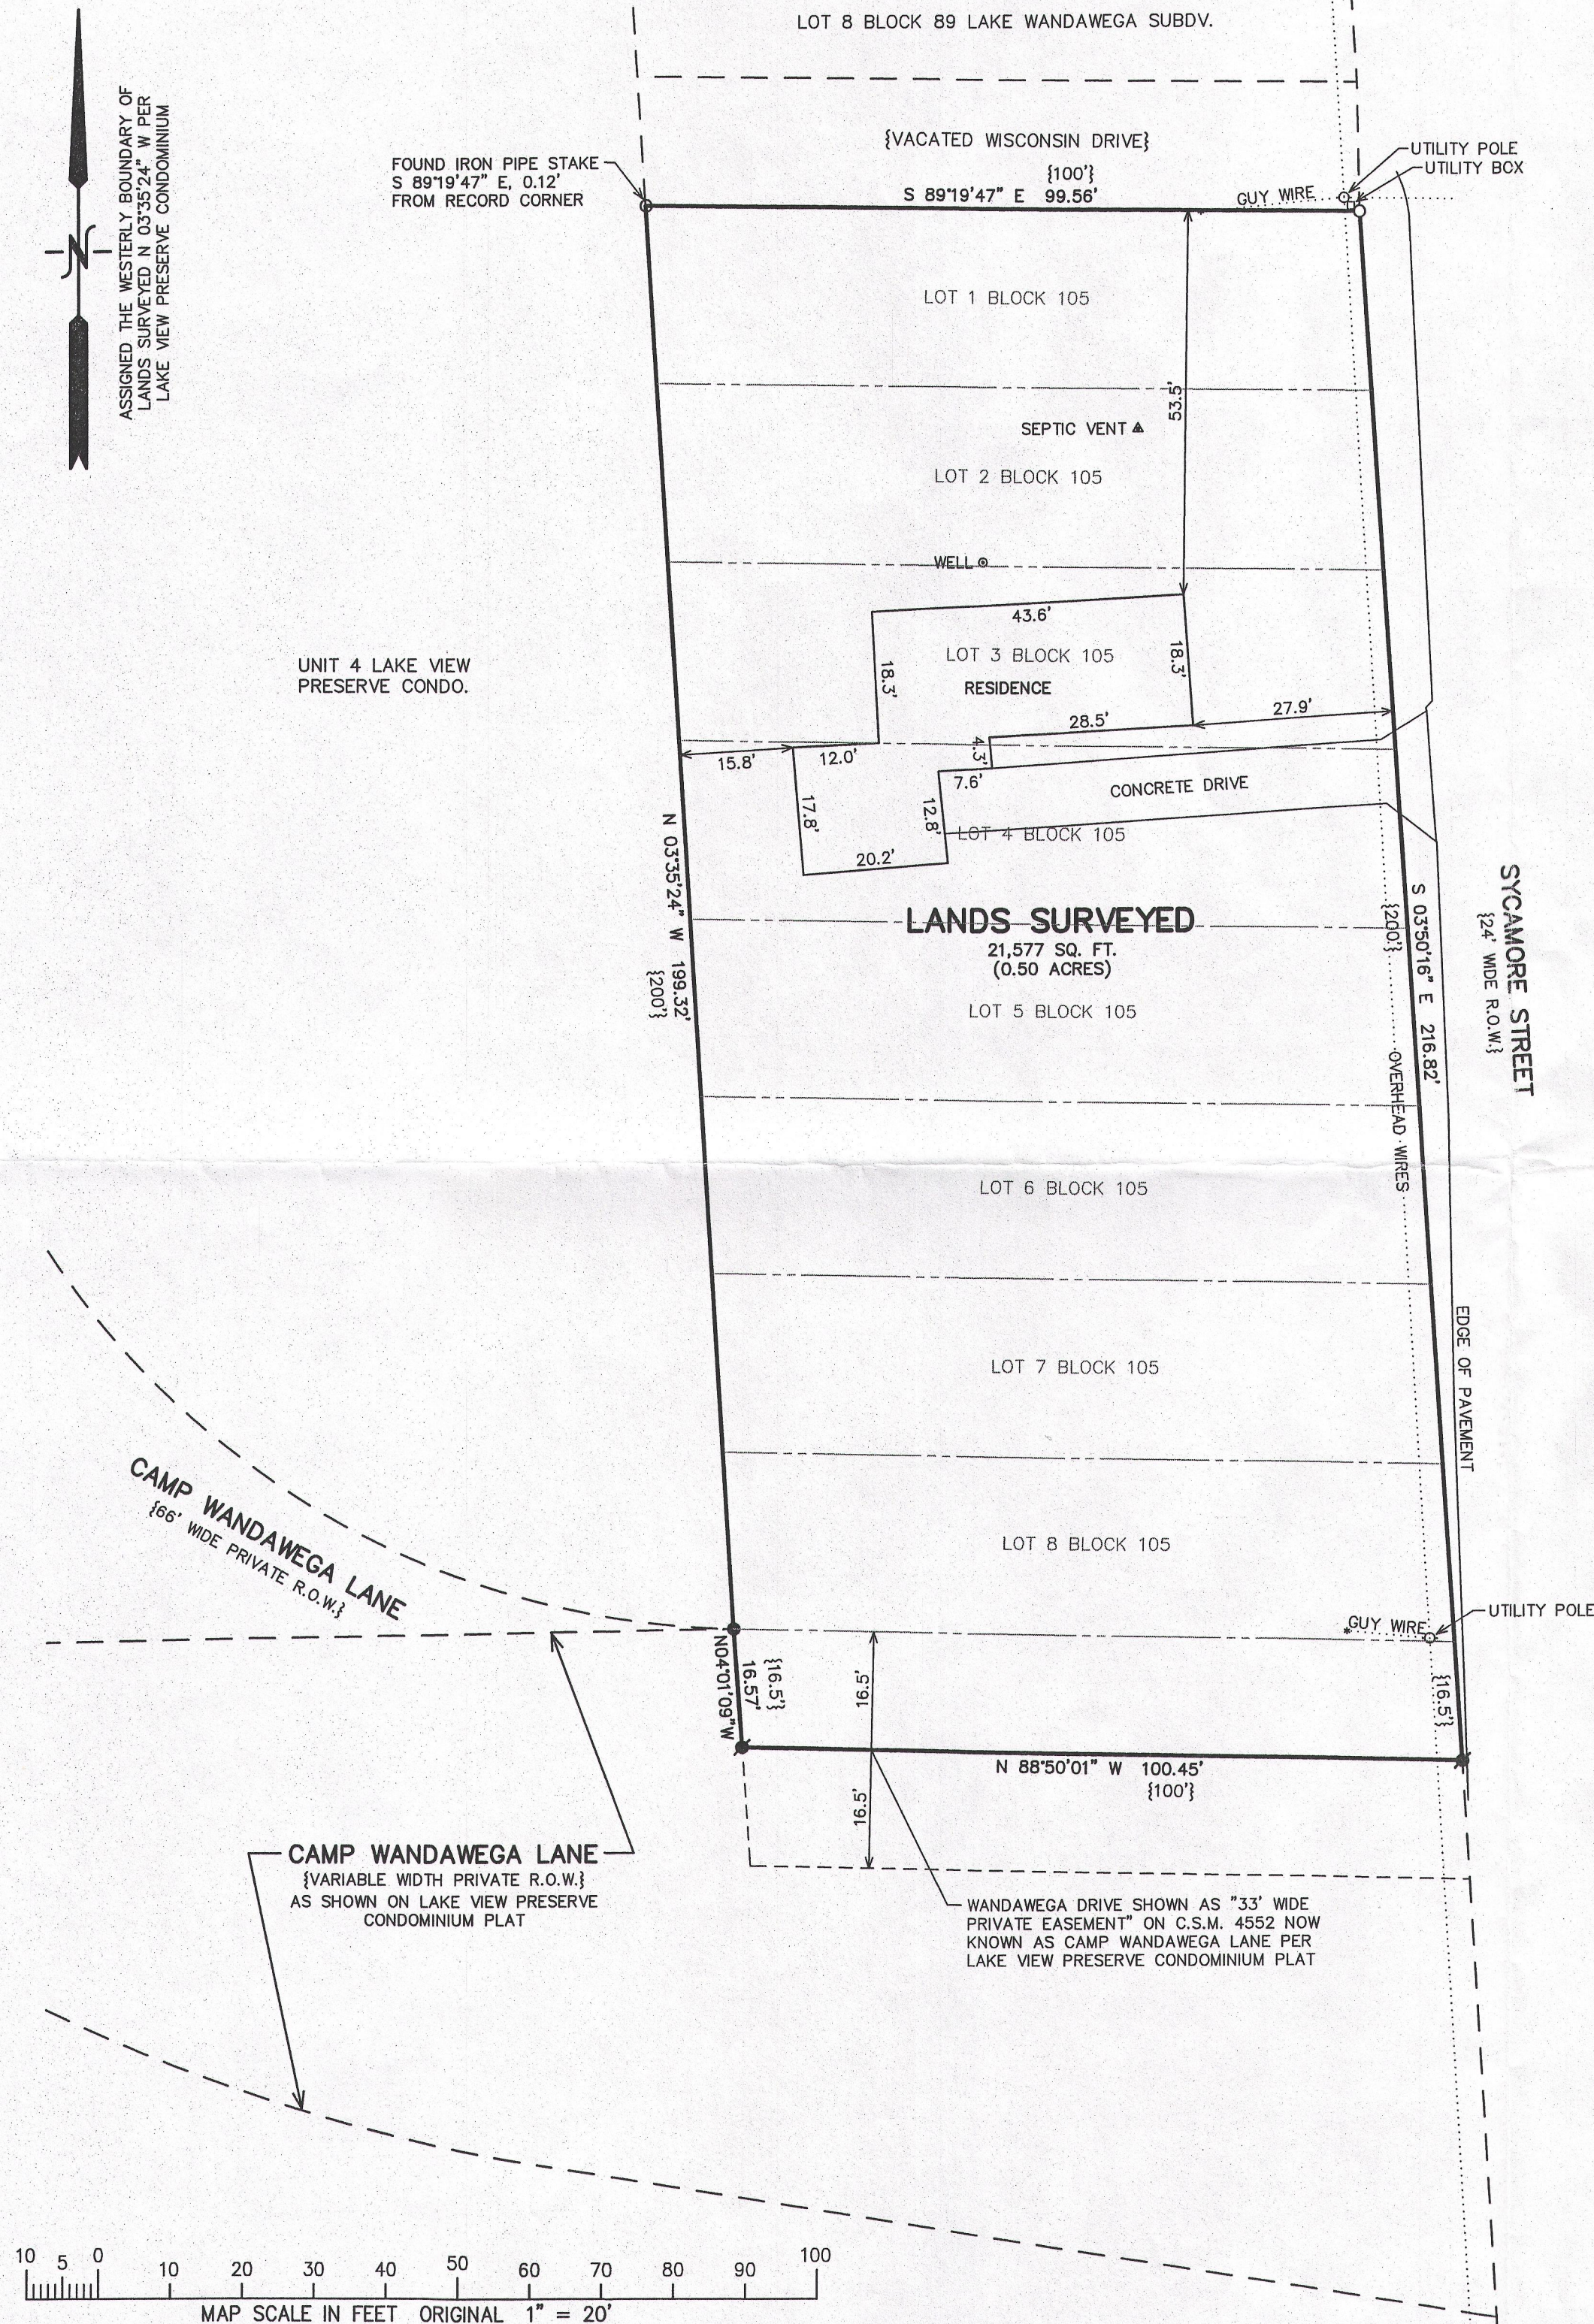

PLAT OF SURVEY

LOTS 1 THROUGH 8 OF BLOCK 105 OF LAKE WANDAWEGA SUBDIVISION & PART OF THE NORTH 1/2 OF CAMP WANDAWEGA LANE (FORMERLY KNOWN AS WANDAWEGA DRIVE)

PART OF THE SE 1/4 OF SECTION 2, TOWN 3 NORTH, RANGE 16 EAST, WALWORTH COUNTY, WISCONSIN

- LEGEND
- = FOUND IRON PIPE STAKE
 - = FOUND IRON REBAR STAKE
 - ✕ = SET IRON REBAR STAKE
 - {XXX} = RECORDED AS

NOTE: COPIES OF THIS MAP TO WHICH THE FOLLOWING CERTIFICATE WILL APPLY SHOW THE SURVEYOR'S ORIGINAL SEAL AND SIGNATURE IN RED INK. COPIES BY ANY OTHER MEANS MAY HAVE ALTERATIONS WHICH DO NOT REPRESENT THE SURVEYOR'S WORK PRODUCT.

I HEREBY CERTIFY THAT THE ABOVE DESCRIBED PROPERTY HAS BEEN SURVEYED UNDER MY DIRECTION AND THAT THE ABOVE MAP IS A TRUE REPRESENTATION THEREOF AND SHOWS THE SIZE AND LOCATION OF THE PROPERTY AND ITS EXTERIOR BOUNDARIES. THIS SURVEY IS MADE FOR THE USE OF THE PRESENT OWNERS OF THE PROPERTY, AND ALSO THOSE WHO PURCHASE, MORTGAGE, OR GUARANTEE THE TITLE THERETO WITHIN ONE YEAR FROM THE DATE HEREOF.

DATED: 11/12/2014

PETER S. GORDON R.L.S. 2101

GLW-277
GLW-278
GLW-279

316-2202



PLAT OF SURVEY

WORK ORDERED BY -
DAVID HERNANDEZ
1922 WEST RACE
CHICAGO, IL 60622

FARRIS, HANSEN & ASSOCIATES, INC.
ENGINEERING - ARCHITECTURE - SURVEYING
7 RIDGWAY COURT P.O. BOX 437
ELKHORN, WISCONSIN 53121
OFFICE: (262) 723-2088 FAX: (262) 723-5886

REVISIONS

PROJECT NO.
9166
DATE:
11/12/2014
SHEET NO.
1 OF 1