




PLAT OF SURVEY LOTS 39 THROUGH 43 OF BLOCK 115 OF LAKE WANDAWEGA SUBDIVISION

PART OF THE SOUTHEAST 1/4 OF THE SOUTHWEST 1/4 OF SECTION 1, TOWN 3 NORTH, RANGE 16 EAST,
WALWORTH COUNTY, WISCONSIN

ASSIGNED THE WESTERLY BOUNDARY OF
HERKIMER AVENUE S 00°42'53" E

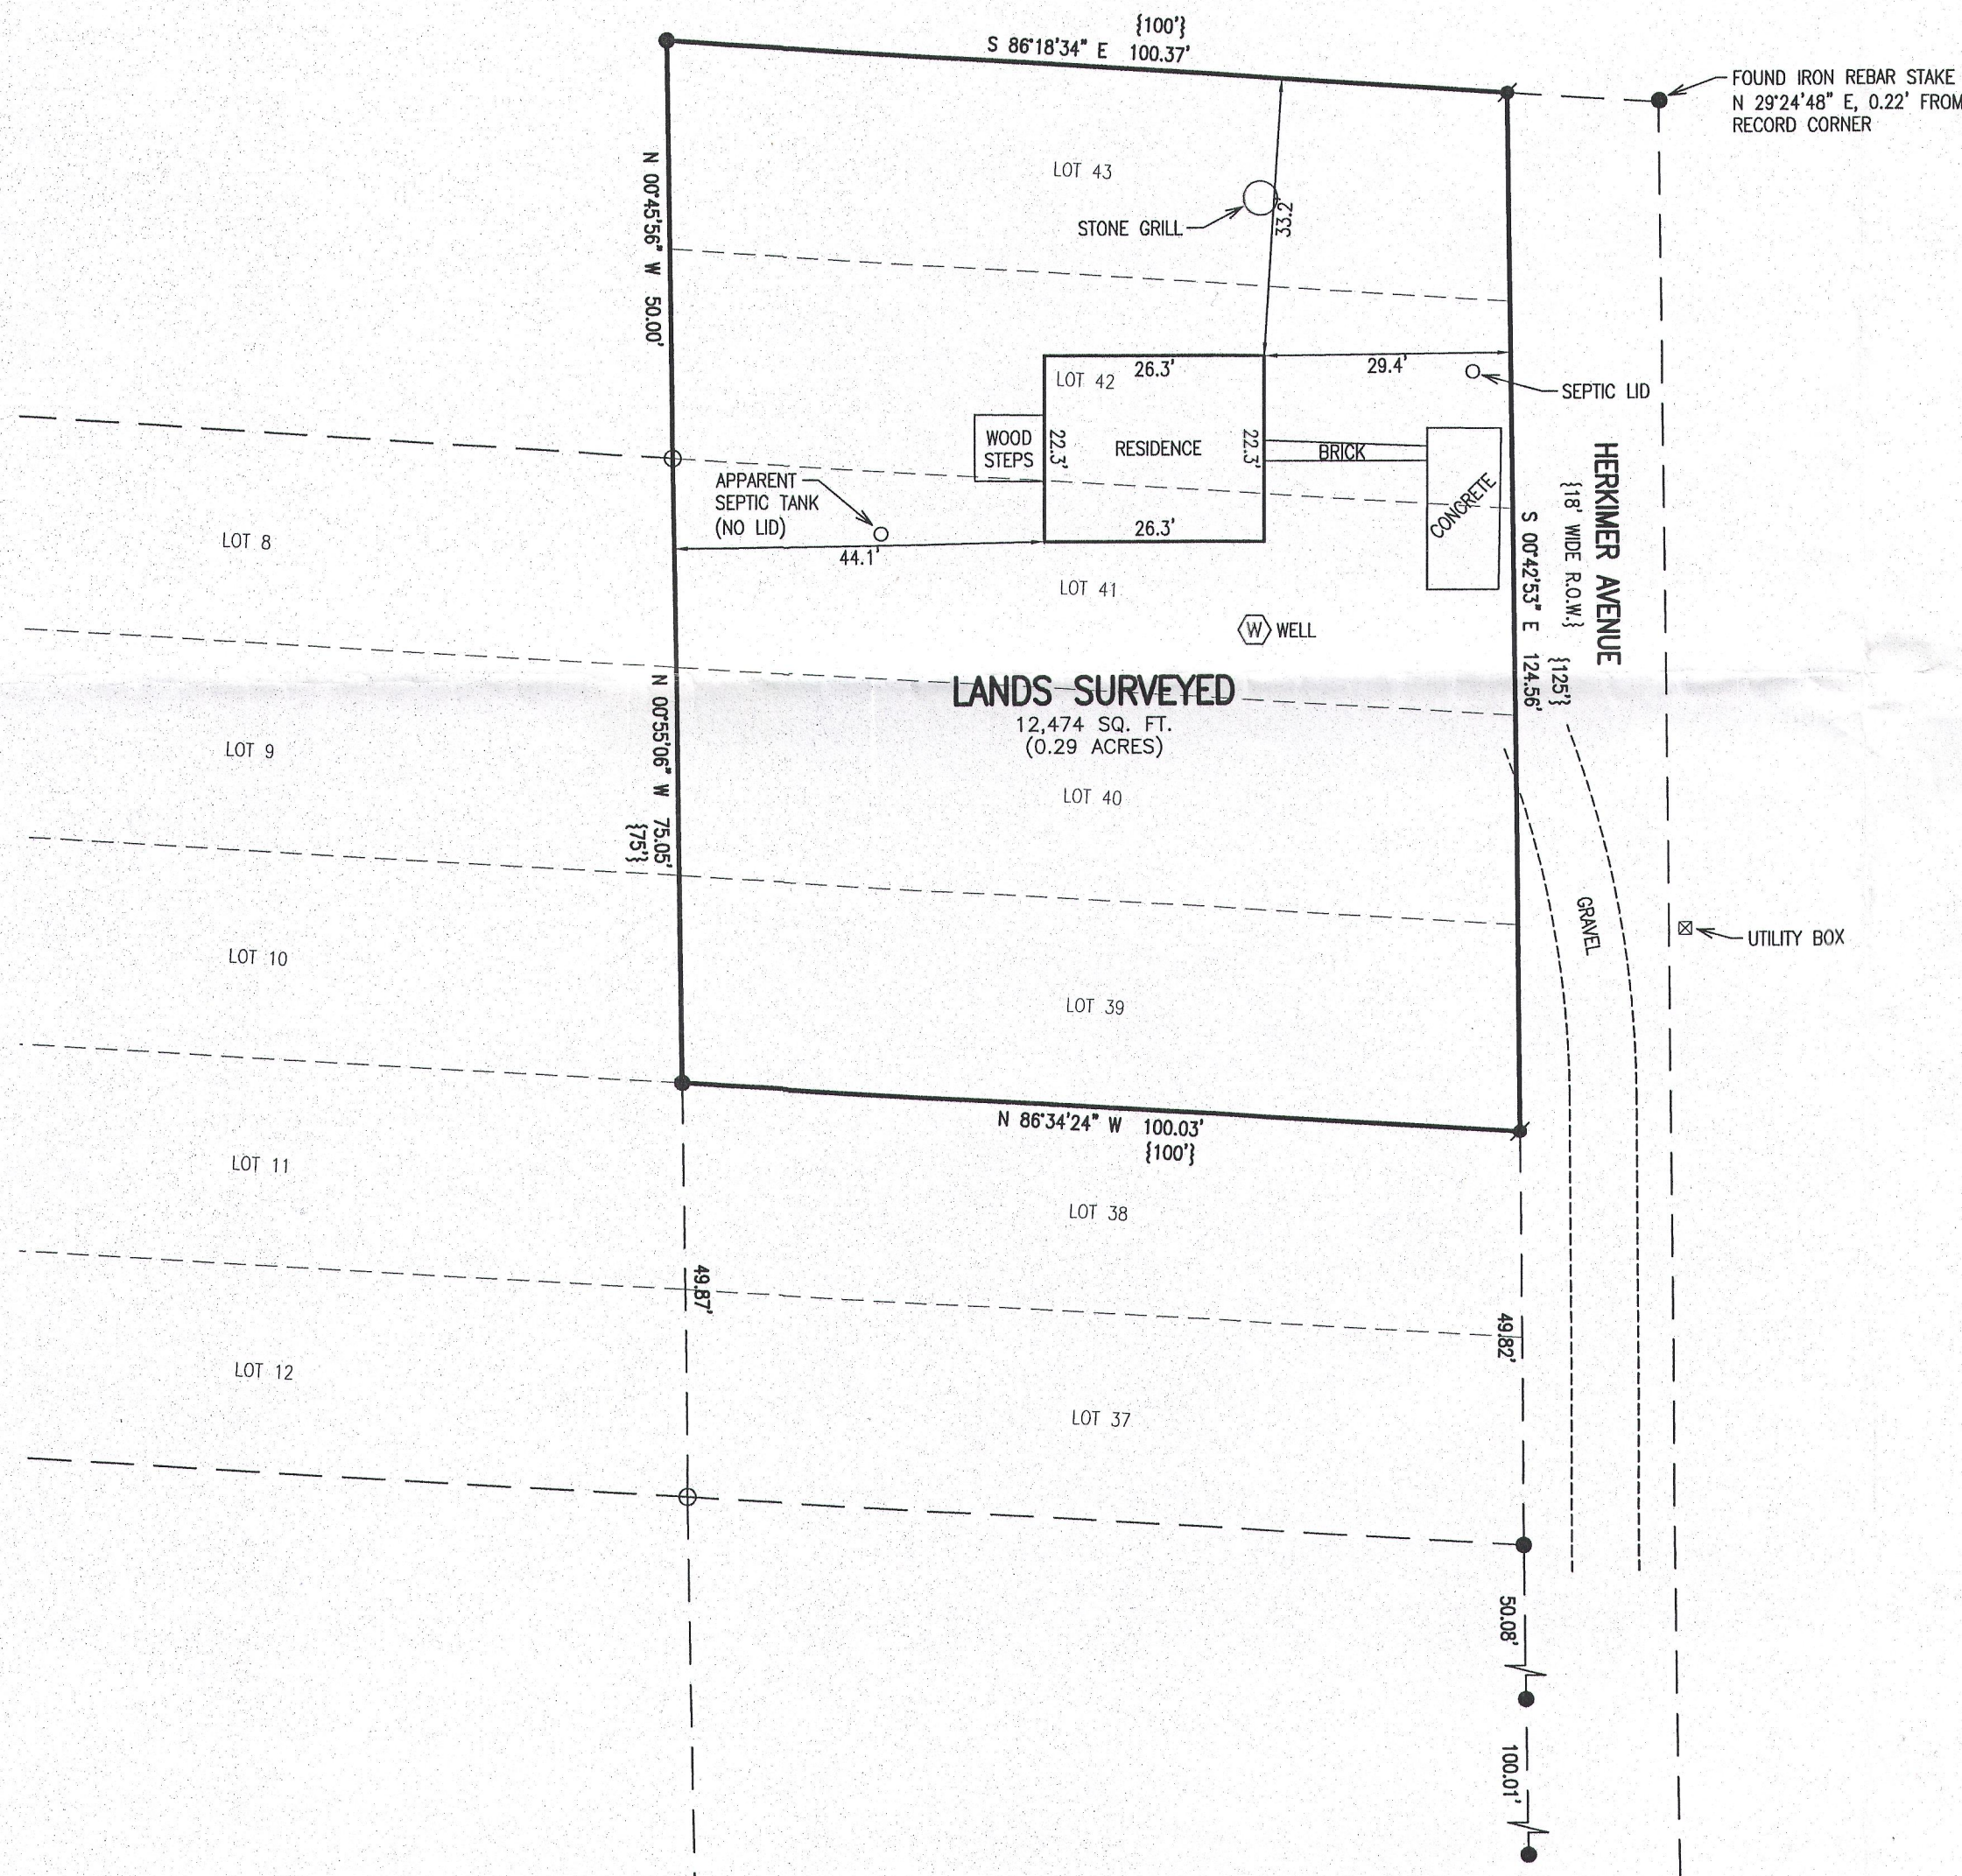

LEGEND
○ = FOUND IRON PIPE STAKE
● = FOUND IRON REBAR STAKE
⊗ = SET IRON REBAR STAKE, 3/4" DIA.
{XXX} = RECORDED AS

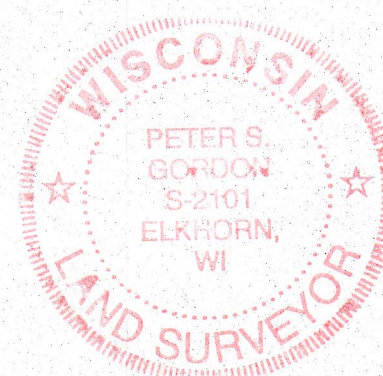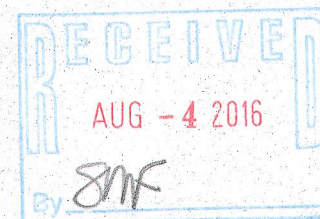


NOTE: COPIES OF THIS MAP TO WHICH THE FOLLOWING CERTIFICATE WILL APPLY SHOW THE SURVEYOR'S ORIGINAL SEAL AND SIGNATURE IN RED INK. COPIES BY ANY OTHER MEANS MAY HAVE ALTERATIONS WHICH DO NOT REPRESENT THE SURVEYOR'S WORK PRODUCT.

I HEREBY CERTIFY THAT THE ABOVE DESCRIBED PROPERTY HAS BEEN SURVEYED UNDER MY DIRECTION AND THAT THE ABOVE MAP IS A TRUE REPRESENTATION THEREOF AND SHOWS THE SIZE AND LOCATION OF THE PROPERTY AND ITS EXTERIOR BOUNDARIES. THIS SURVEY IS MADE FOR THE USE OF THE PRESENT OWNERS OF THE PROPERTY, AND ALSO THOSE WHO PURCHASE, MORTGAGE, OR GUARANTEE THE TITLE THERETO WITHIN ONE YEAR FROM THE DATE HEREOF.

DATED: 5/26/2016

Peter S. Gordon
PETER S. GORDON P.L.S. 2101

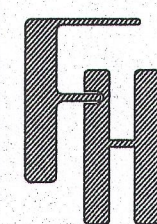

WORK ORDERED BY -
JOYCE HAYWARD
638 POPLAR AVENUE
ROMEIOVILLE, IL 60446

FARRIS, HANSEN & ASSOCIATES, INC.
ENGINEERING - ARCHITECTURE - SURVEYING
7 RIDGWAY COURT P.O. BOX 437
ELKHORN, WISCONSIN 53121
OFFICE: (262) 723-2098 FAX: (262) 723-5886

REVISIONS

PROJECT NO.	9524
DATE:	05/26/2016
SHEET NO.	1 OF 1

GLW-339

316-2265