

LAND-MARK SURVEYING

Mark L. Miritz



Wisconsin Professional Land Surveyor S-2582

N9330 Knuteson Drive
Whitewater, WI 53190
Phone: (262) 495-3284
FAX: (262) 495-8421
LAND-MARKSURVEYING.COM

PLAT OF SURVEY

LOT 39 OF SYLVAN TRACE SUBDIVISION, LOCATED IN THE SOUTHWEST 1/4 OF THE NORTHWEST 1/4, THE SOUTHWEST 1/4 AND THE SOUTHEAST 1/4 OF THE NORTHWEST 1/4 AND THE NORTHEAST 1/4 AND THE SOUTHEAST 1/4 AND THE NORTHWEST 1/4 OF THE SOUTHWEST 1/4 OF SECTION 2, TOWN 3 NORTH, RANGE 16 EAST, WALWORTH COUNTY, WISCONSIN.

SEE DOUGLAS G. OLSON
SURVEY DATED 2-2-2004

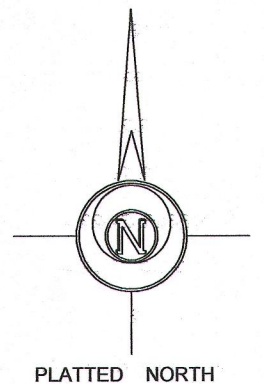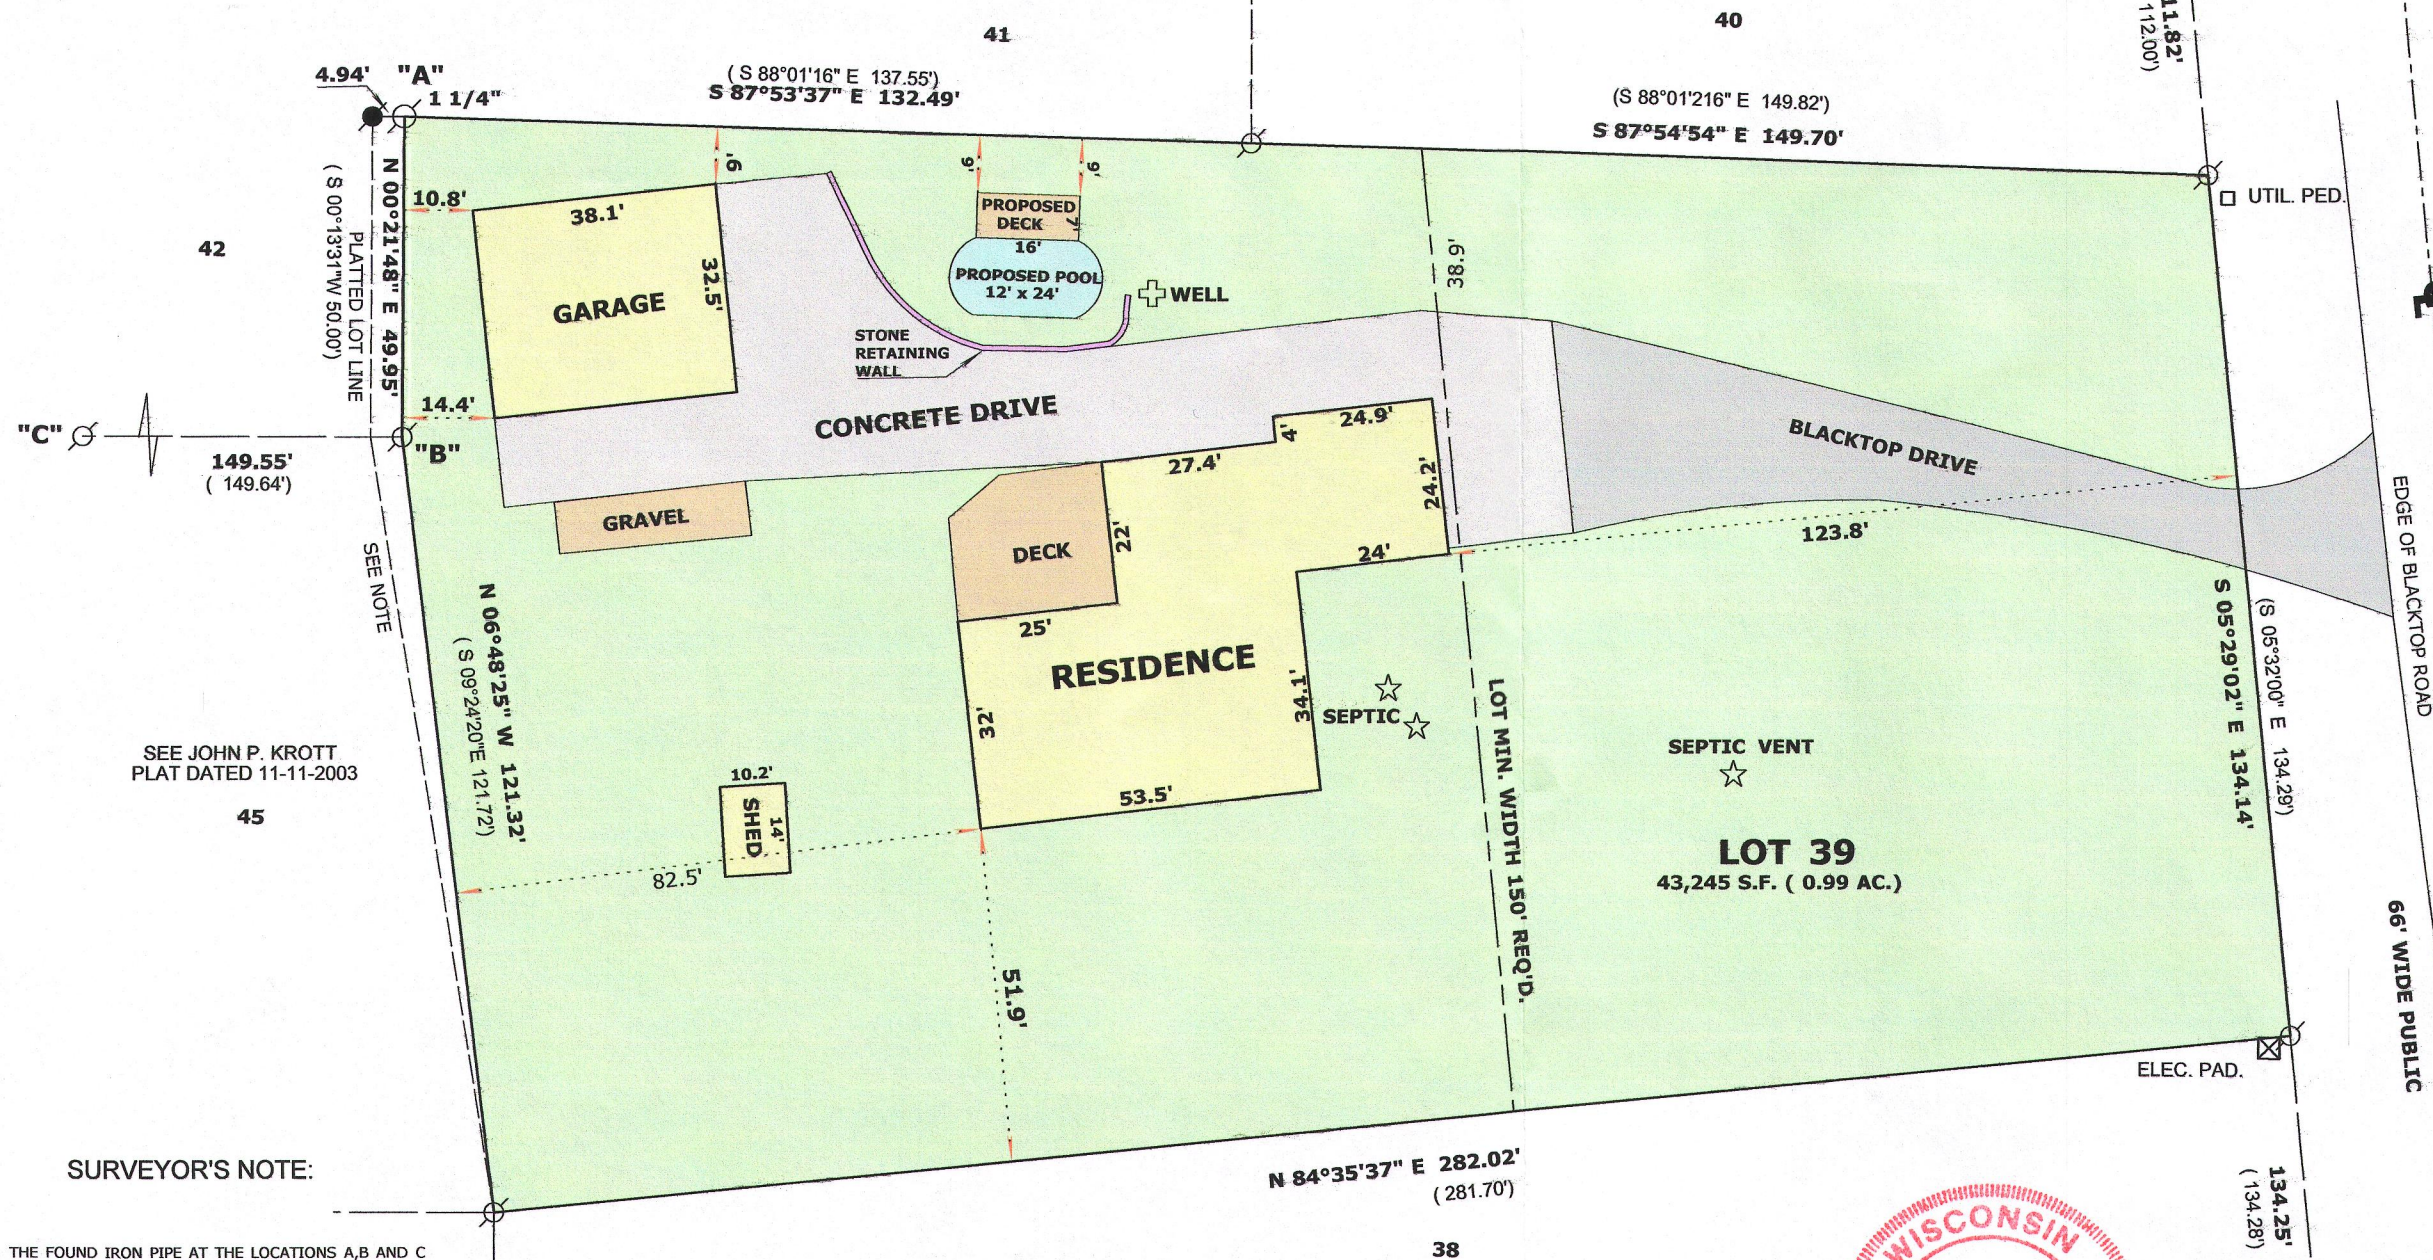

LEGEND

- FOUND IRON PIPE 1" ID
- FOUND IRON ROD 3/4"
- RECORDED AS DIMENSION
- EXISTING FENCE

SCALE: 1" = 30 FEET

"I hereby certify that the above described property has been surveyed by me or under my direction and that the above map is a true representation thereof and shows the size and location of the property, its exterior boundaries, the location of all visible structures and dimensions of all principal buildings thereon, boundary fences, apparent easements, roadways and visible encroachments, if any." "This survey is made for the use of the present owners of the property, and also those who purchase, mortgage, or guarantee the title thereto within one year from date hereof."

Mark L. Miritz
MARK L. MIRITZ
WISCONSIN PROFESSIONAL
LAND SURVEYOR S-2582

DATE: FEB. 24, 2005 JOB NO. 05.209

SURVEYOR'S NOTE:

- 1) THE FOUND IRON PIPE AT THE LOCATIONS A, B AND C ARE APPROXIMATELY 5' EAST OF THEIR PLATTED LOCATIONS. I BELIEVE THE 1" ID PIPE FOUND ARE ORIGINALS SET BY JAMES BIAGI AS CALLED FOR ON THE SYLVAN TRACE SUBDIVISION PLAT. AFTER LOTS ARE SOLD, ORIGINAL MONUMENTS TAKES PRECEDENCE OVER PLATTED DIMENSIONS.

OWNER: MARK SKALA
W5465 HILLVIEW ROAD
ELKHORN, WI 53121



REVISED TO SHOW GARAGE
AS BUILT JULY 21, 2016

GST-39

316-2267