
Plat of Survey

Survey For: Gas Light Homes, Inc.
Location: Poplar Street & North Drive — T. Grezchowiak, Sr.

Description: Lots 1,2,3 & 4, Block 8 LAKE WANDEWEGA SUBDIVISION located in the S.E. 1/4 of the N.E. 1/4 of Section 2, T. 3 N., R. 16 E., Walworth County, Wisconsin.

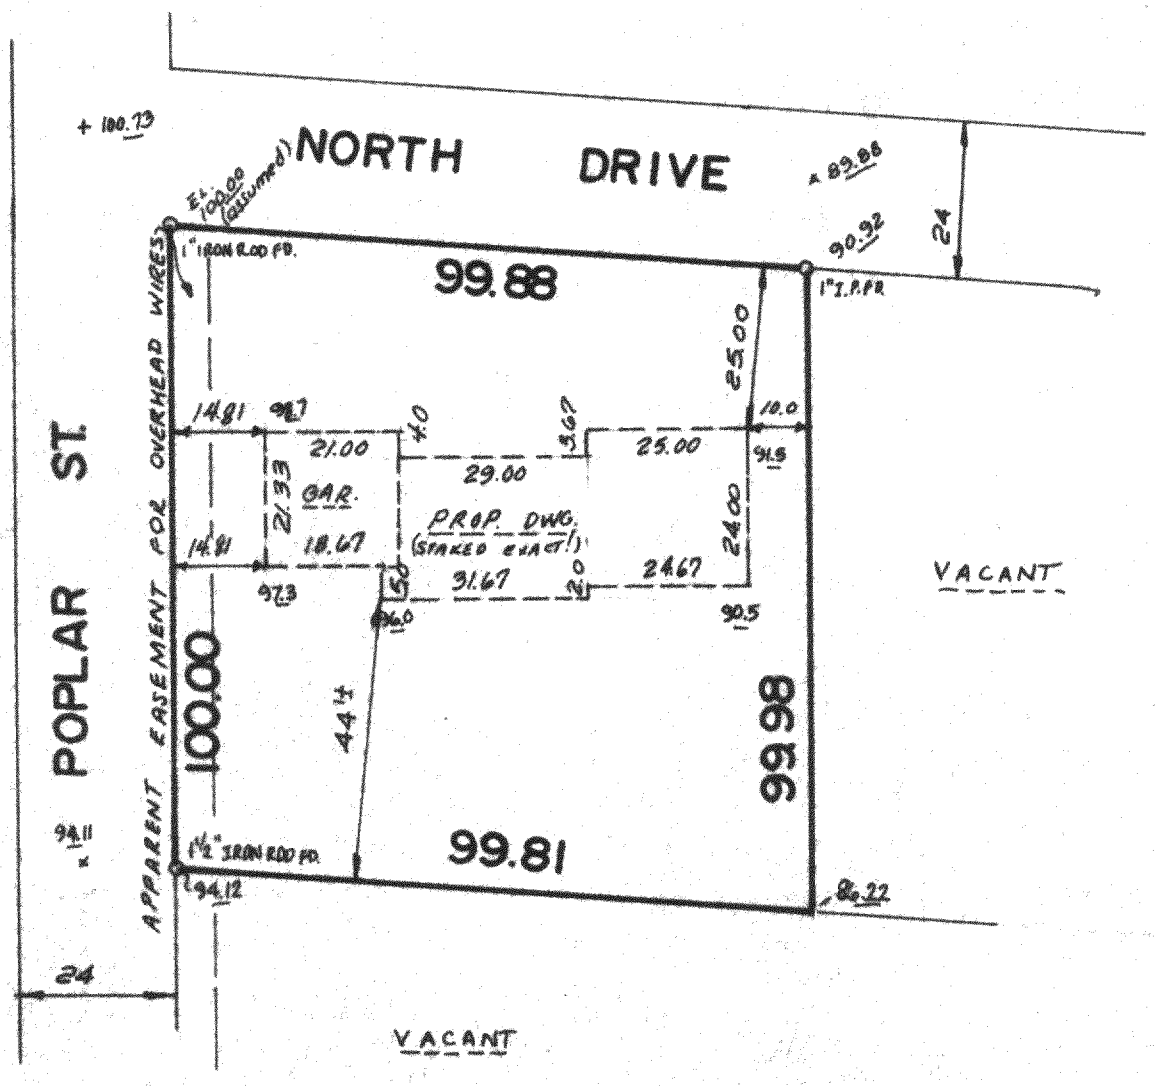

Scale: 1" = 30'

N

WISCONSIN
THOMAS INMAN
S-959
MILWAUKEE, WIS.
LAND SURVEYOR

INMAN ENGINEERING OF MILWAUKEE, INC.
ENGINEERS – SURVEYORS

SURVEY CERTIFICATE

State of Wisconsin)
Milwaukee County) ss

I certify that I have surveyed the above described (property) and the above map is a true representation thereof and shows the size and location of the Property, its exterior boundaries, the location and dimensions of all visible structures thereon, fences, apparent easements and roadways and visible encroachments, if any.

This survey is made for the exclusive use of the present owners of the Property, and also those who purchase, mortgage, or guarantee the title thereto within one (1) year from date hereof; and as to them I warrant the accuracy of said survey and map.

Thomas Inman
THOMAS INMAN, Registered Land Surveyor

DATE: 5/8/77
JOB NO.: 2388

6407

316-232 3