
FARRIS, HANSEN & COOPER, INC.

ENGINEERING, SURVEYING AND LAND PLANNING

715 W. WALWORTH ST. - P.O. BOX 487 - ELKHORN, WI 53121

OFFICE: 414/723-2098

PLAT OF SURVEY OF LOT 1, BLOCK 10 AND LOTS 1 & 2 BLOCK 13 OF BLUE WING ESTATES, TOWN OF SUGAR CREEK, WALWORTH COUNTY WISCONSIN

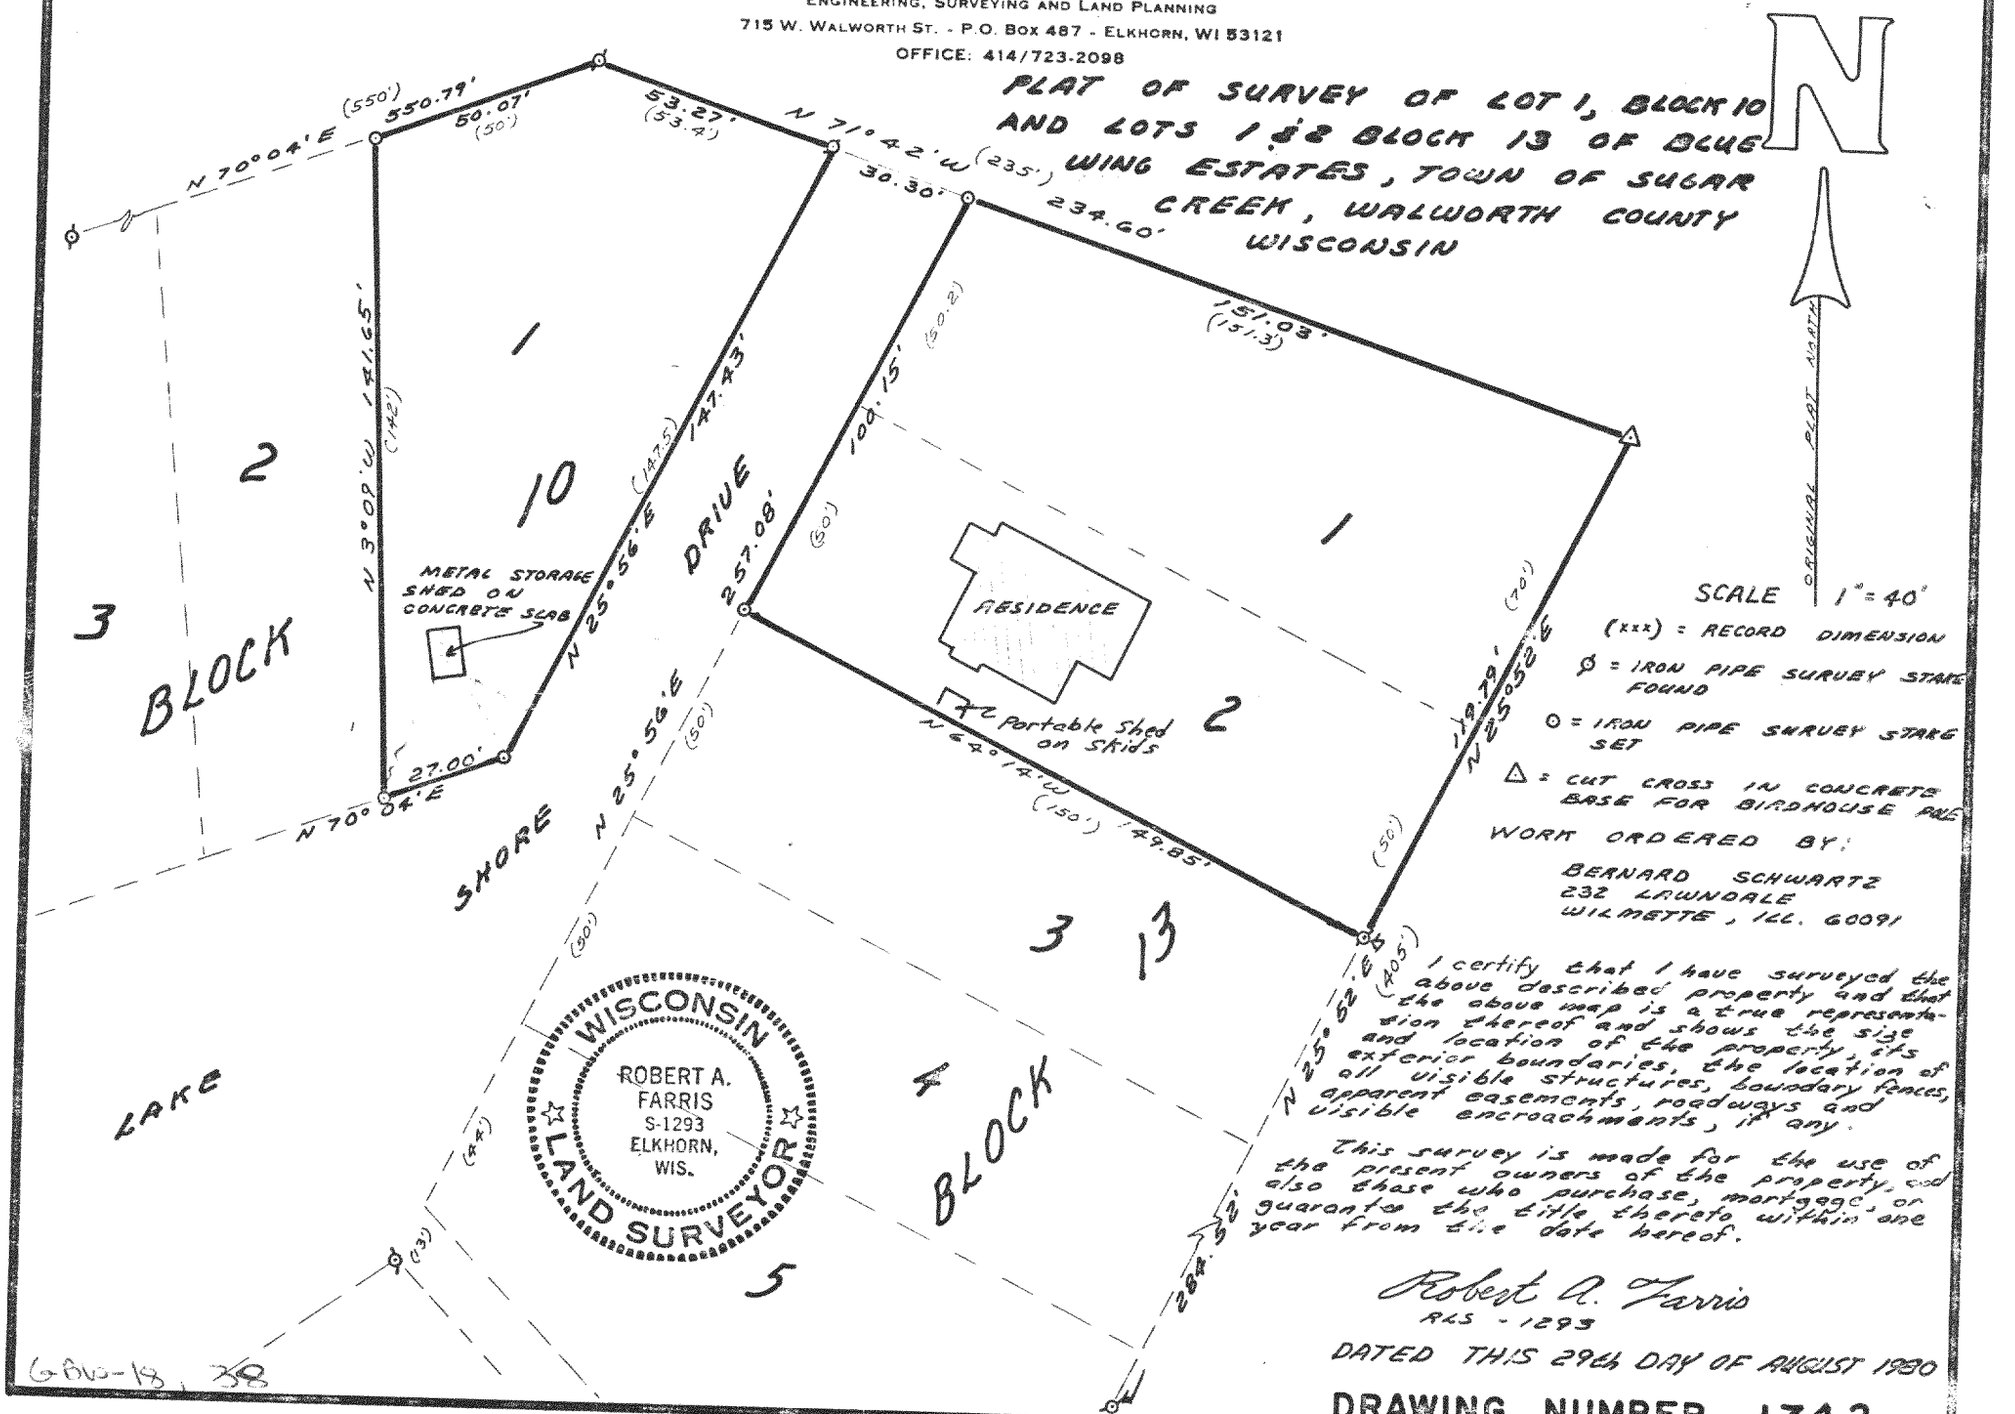

SCALE 1" = 40'

(XXX) = RECORD DIMENSION

Ø = IRON PIPE SURVEY STAKE FOUND

⊙ = IRON PIPE SURVEY STAKE SET

△ = CUT CROSS IN CONCRETE BASE FOR BIRDHOUSE POLE

WORK ORDERED BY:

BERNARD SCHWARTZ
232 LAWNDALE
WILMETTE, ILL. 60091

I certify that I have surveyed the above described property and that the above map is a true representation thereof and shows the size and location of the property, its exterior boundaries, the location of all visible structures, boundary fences, apparent easements, roadways and visible encroachments, if any.

This survey is made for the use of the present owners of the property, and also those who purchase, mortgage, or guarantee the title thereto within one year from the date hereof.

Robert A. Farris
RLS - 1293

DATED THIS 29th DAY OF AUGUST 1990

DRAWING NUMBER 1742

G-BW-18, 38