

FARRIS, HANSEN & COOPER, INC.
ENGINEERING, SURVEYING AND LAND PLANNING
715 W. WALWORTH ST. - P.O. BOX 487 - ELKHORN, WI 53121

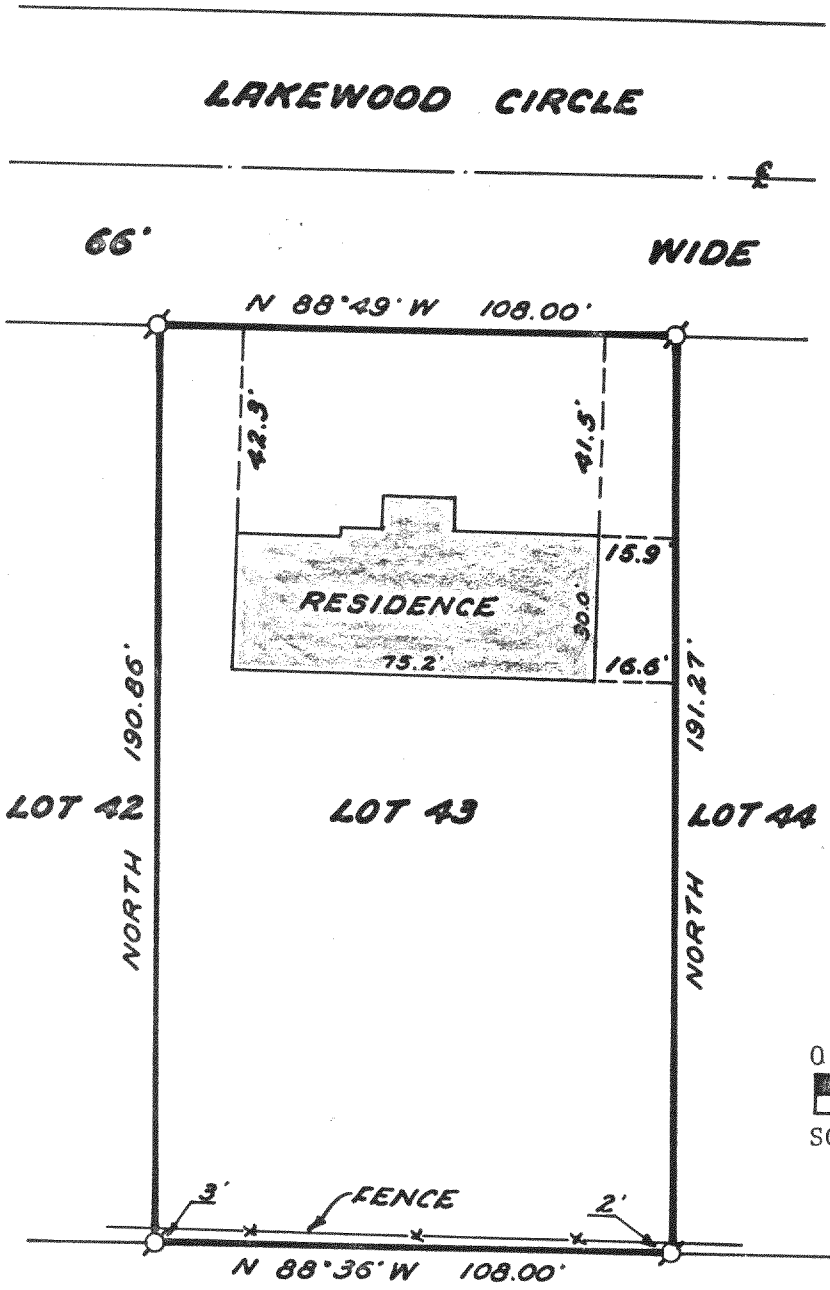

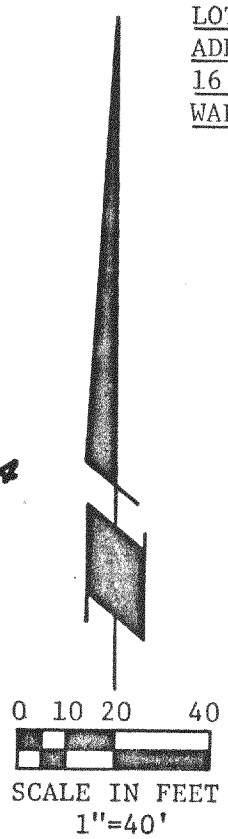

PLAT OF SURVEY

LOT 43 OF BAYWOOD ESTATES 1ST ADDITION, TOWN 3 NORTH, RANGE 16 EAST, TOWN OF SUGAR CREEK, WALWORTH COUNTY, WISCONSIN.

ORDERED BY:
Rockland Builders
Janesville, WI


OWNER:
Robert Bucholtz

NOTE: Easement granted to Wisconsin Electric Power Company in Vol. 101, P. 226 of Records.

NOTE: The West line of Lot 43 of Baywood Estates 1st Addition is assumed to bear "NORTH" as recorded on said subdivision.

LEGEND

ø—1" Diameter Iron Pipe Found

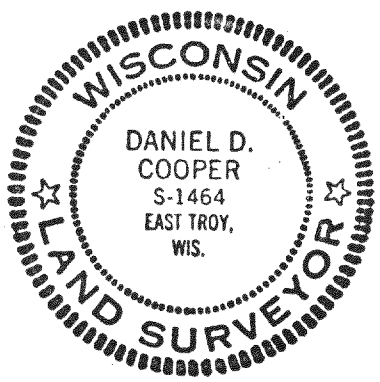

I HEREBY CERTIFY that I have surveyed the property described hereon and that this Plat of Survey is a true and accurate representation of the lot lines and the buildings located thereon to the best of my professional knowledge and belief.

Daniel D Cooper
Daniel D. Cooper, RLS No. 1464

Dated this 23 day of Aug, 1979

PROJECT NO. 1592

6B&A-20

316-295