
46-62

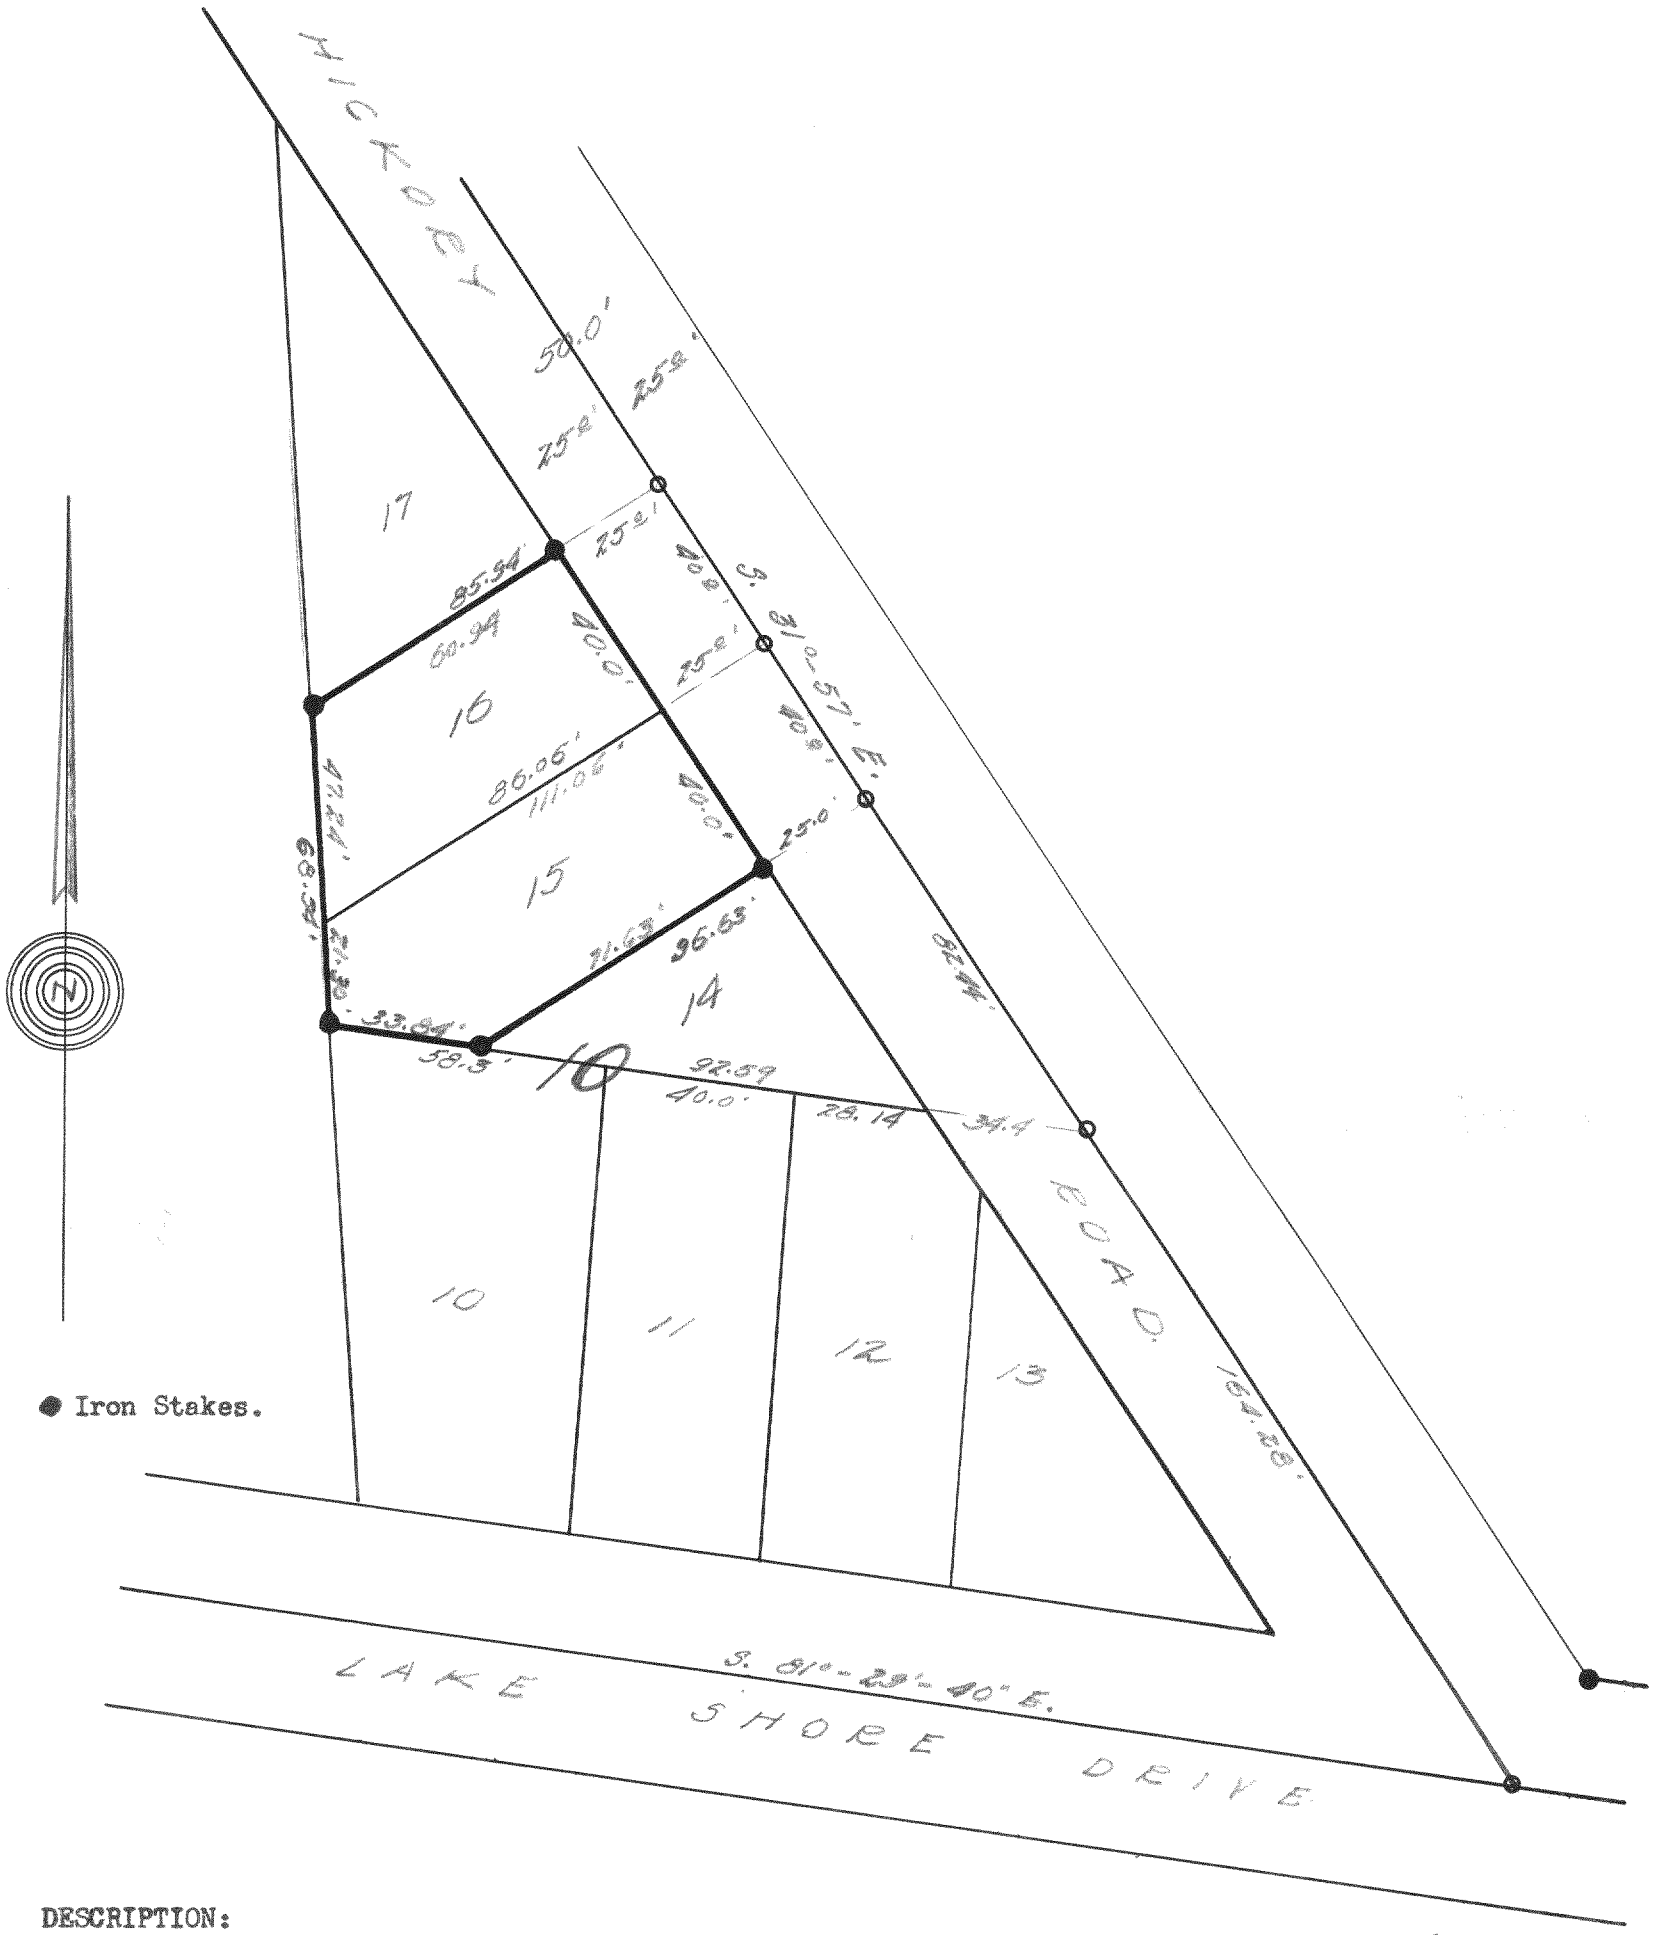

● Iron Stakes.

DESCRIPTION:

Lots 15 and 16 Block 10 Interlaken Subdivision, of a portion of the S. W. ¼ of Section 11, Town 3 north, Range 16 east of the 4th P.M.

CERTIFICATE:

I, hereby certify that I, have on his the 30th day of November 1946, surveyed thw above described property according to the official records on file in the office of the Recorder of Deeds in and for Walworth County, Wisconsin, and find that the measurements and bearings of the boundary lines of said property as taken at the site on this day, substantially agwee with those in the above description, and that no encroachments exist.

SIGNED AND SEALED THIS 1ST DAY OF NOVEMBER 1946.

Joseph M. Biagi
Professional Engineer
Elkhorn Wisconsin.

316-2B

61-98