
PLAT OF SURVEY

LOTS 13-18 INCLUSIVE OF BLOCK 8 OF LAKE WANDAWEGA SUBDIVISION LOCATED IN SECTION 2, TOWN 3 NORTH, RANGE 16 EAST, TOWN OF SUGAR CREEK, WALWORTH COUNTY, WISCONSIN.

OWNERS- Robert H. and Christine E. Miller
P.O. Box 608
Lake Geneva, Wis. 53147

Note- Subdivision is recorded in Vol. 8 P. 25 of Plats Cab. 1 Slide 98, Register of Deeds, Walworth Cnty.

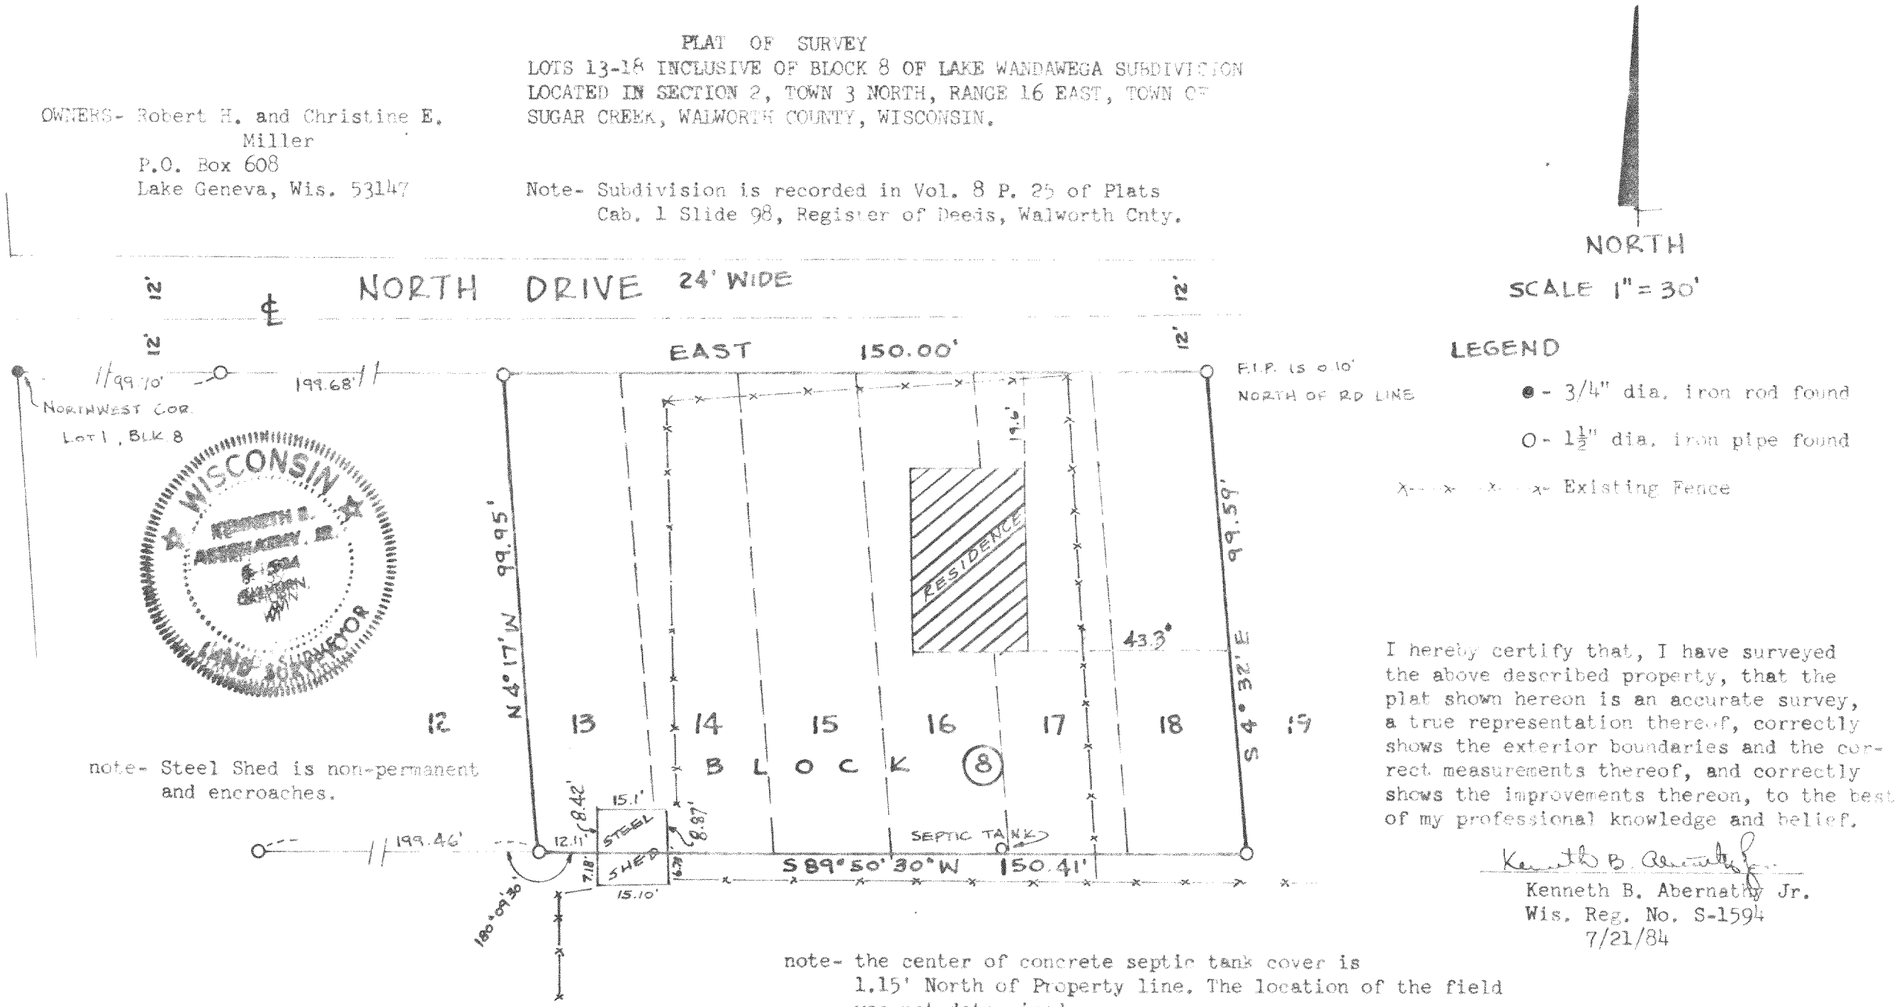

LEGEND

● - 3/4" dia. iron rod found

O - 1½" dia. iron pipe found

x--x--x--x- Existing Fence

note- Steel Shed is non-permanent and encroaches.

note- the center of concrete septic tank cover is 1.15' North of Property line. The location of the field was not determined.

I hereby certify that, I have surveyed the above described property, that the plat shown hereon is an accurate survey, a true representation thereof, correctly shows the exterior boundaries and the correct measurements thereof, and correctly shows the improvements thereon, to the best of my professional knowledge and belief.

Kenneth B. Abernathy Jr.

Kenneth B. Abernathy Jr.
Wis. Reg. No. S-1594
7/21/84

GLW-2 + 3

316-3204 # 1984702