D.D. COOPER & CO. INC.
ROUTE 4, BOX 505 B
ELKHORN, WI. 53181
PH 414-723-6265
SURVEYING • MODULAR HOMES

PLAT OF SURVEY OF LOTS 5-8 AND LOTS 49 AND 50, BLOCK 69, LAKE WANDAWEGA, TOWN 3 NORTH, RANGE 16 EAST, WALWORTH CO, WIS.

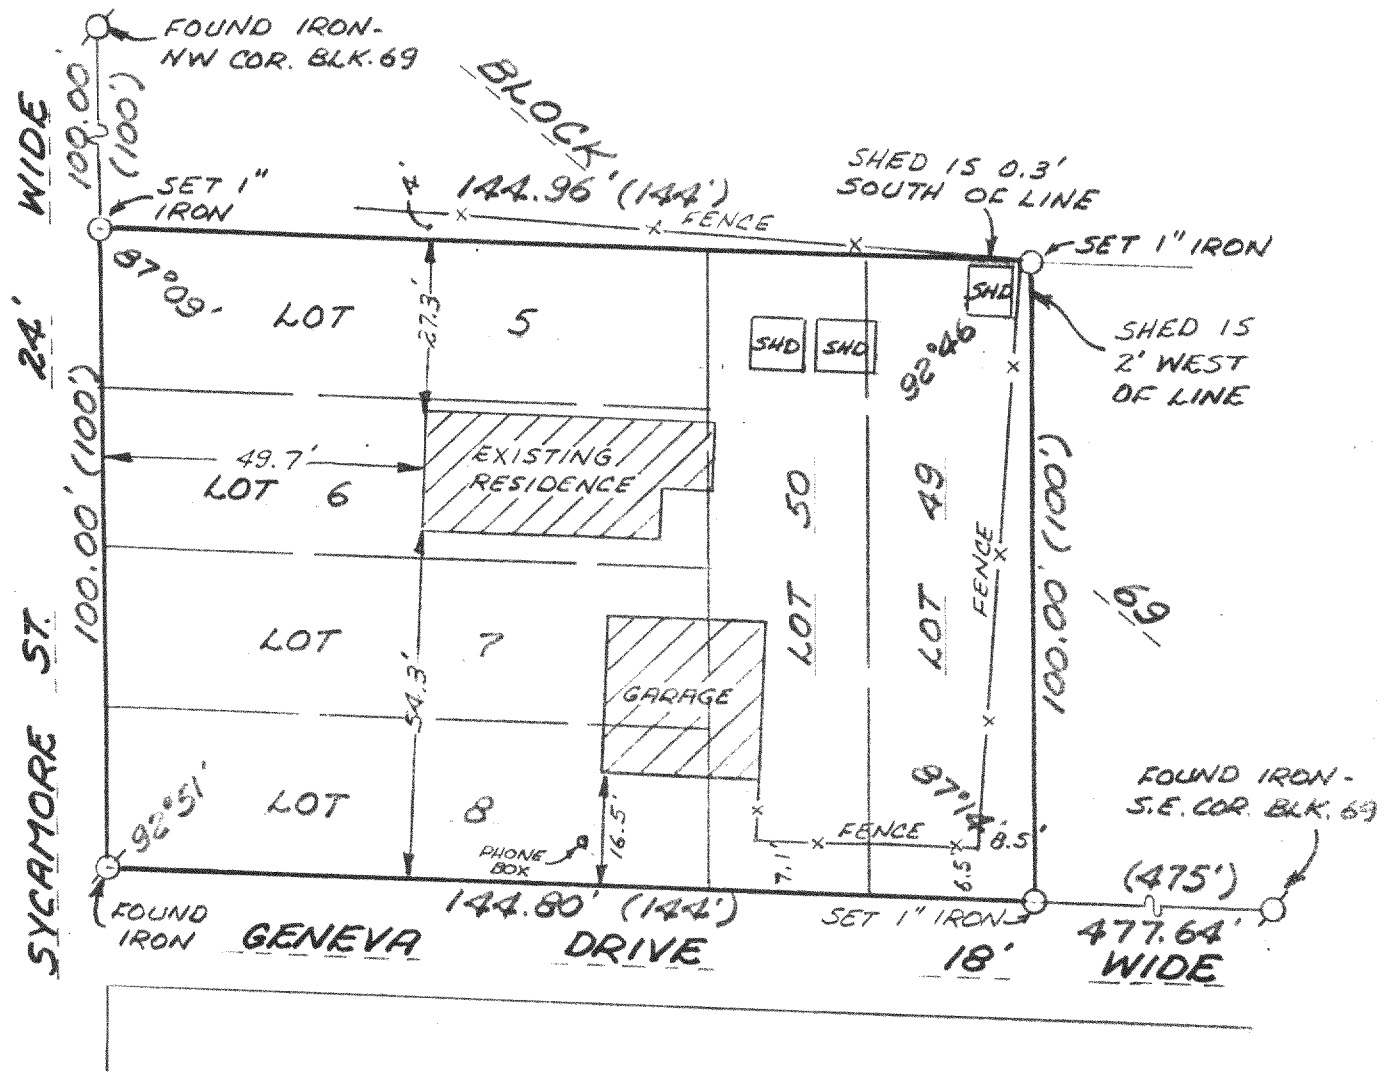

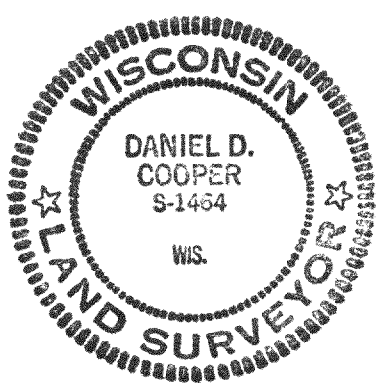

ORDERED BY: DON PAUL

PROJECT NO.: 1980

LEGEND
○—IRON PIPE FOUND
( )—RECORD DIMENSION

25 0 25 50 75 100
SCALE IN FEET (1"=30')

I, DANIEL D. COOPER, REGISTERED SURVEYOR, DO HEREBY CERTIFY THAT I HAVE SURVEYED THE PROPERTY DESCRIBED HEREON AND THAT THE MAP SHOWN HEREON IS A TRUE AND ACCURATE REPRESENTATION THEROF TO THE BEST OF MY PROFESSIONAL KNOWLEDGE AND BELIEF.

DATED THIS 1 DAY OF Oct, 1984 Daniel D. Cooper
DANIEL D. COOPER, RLS NO. S-1464

316-32

GLW-104, 111