
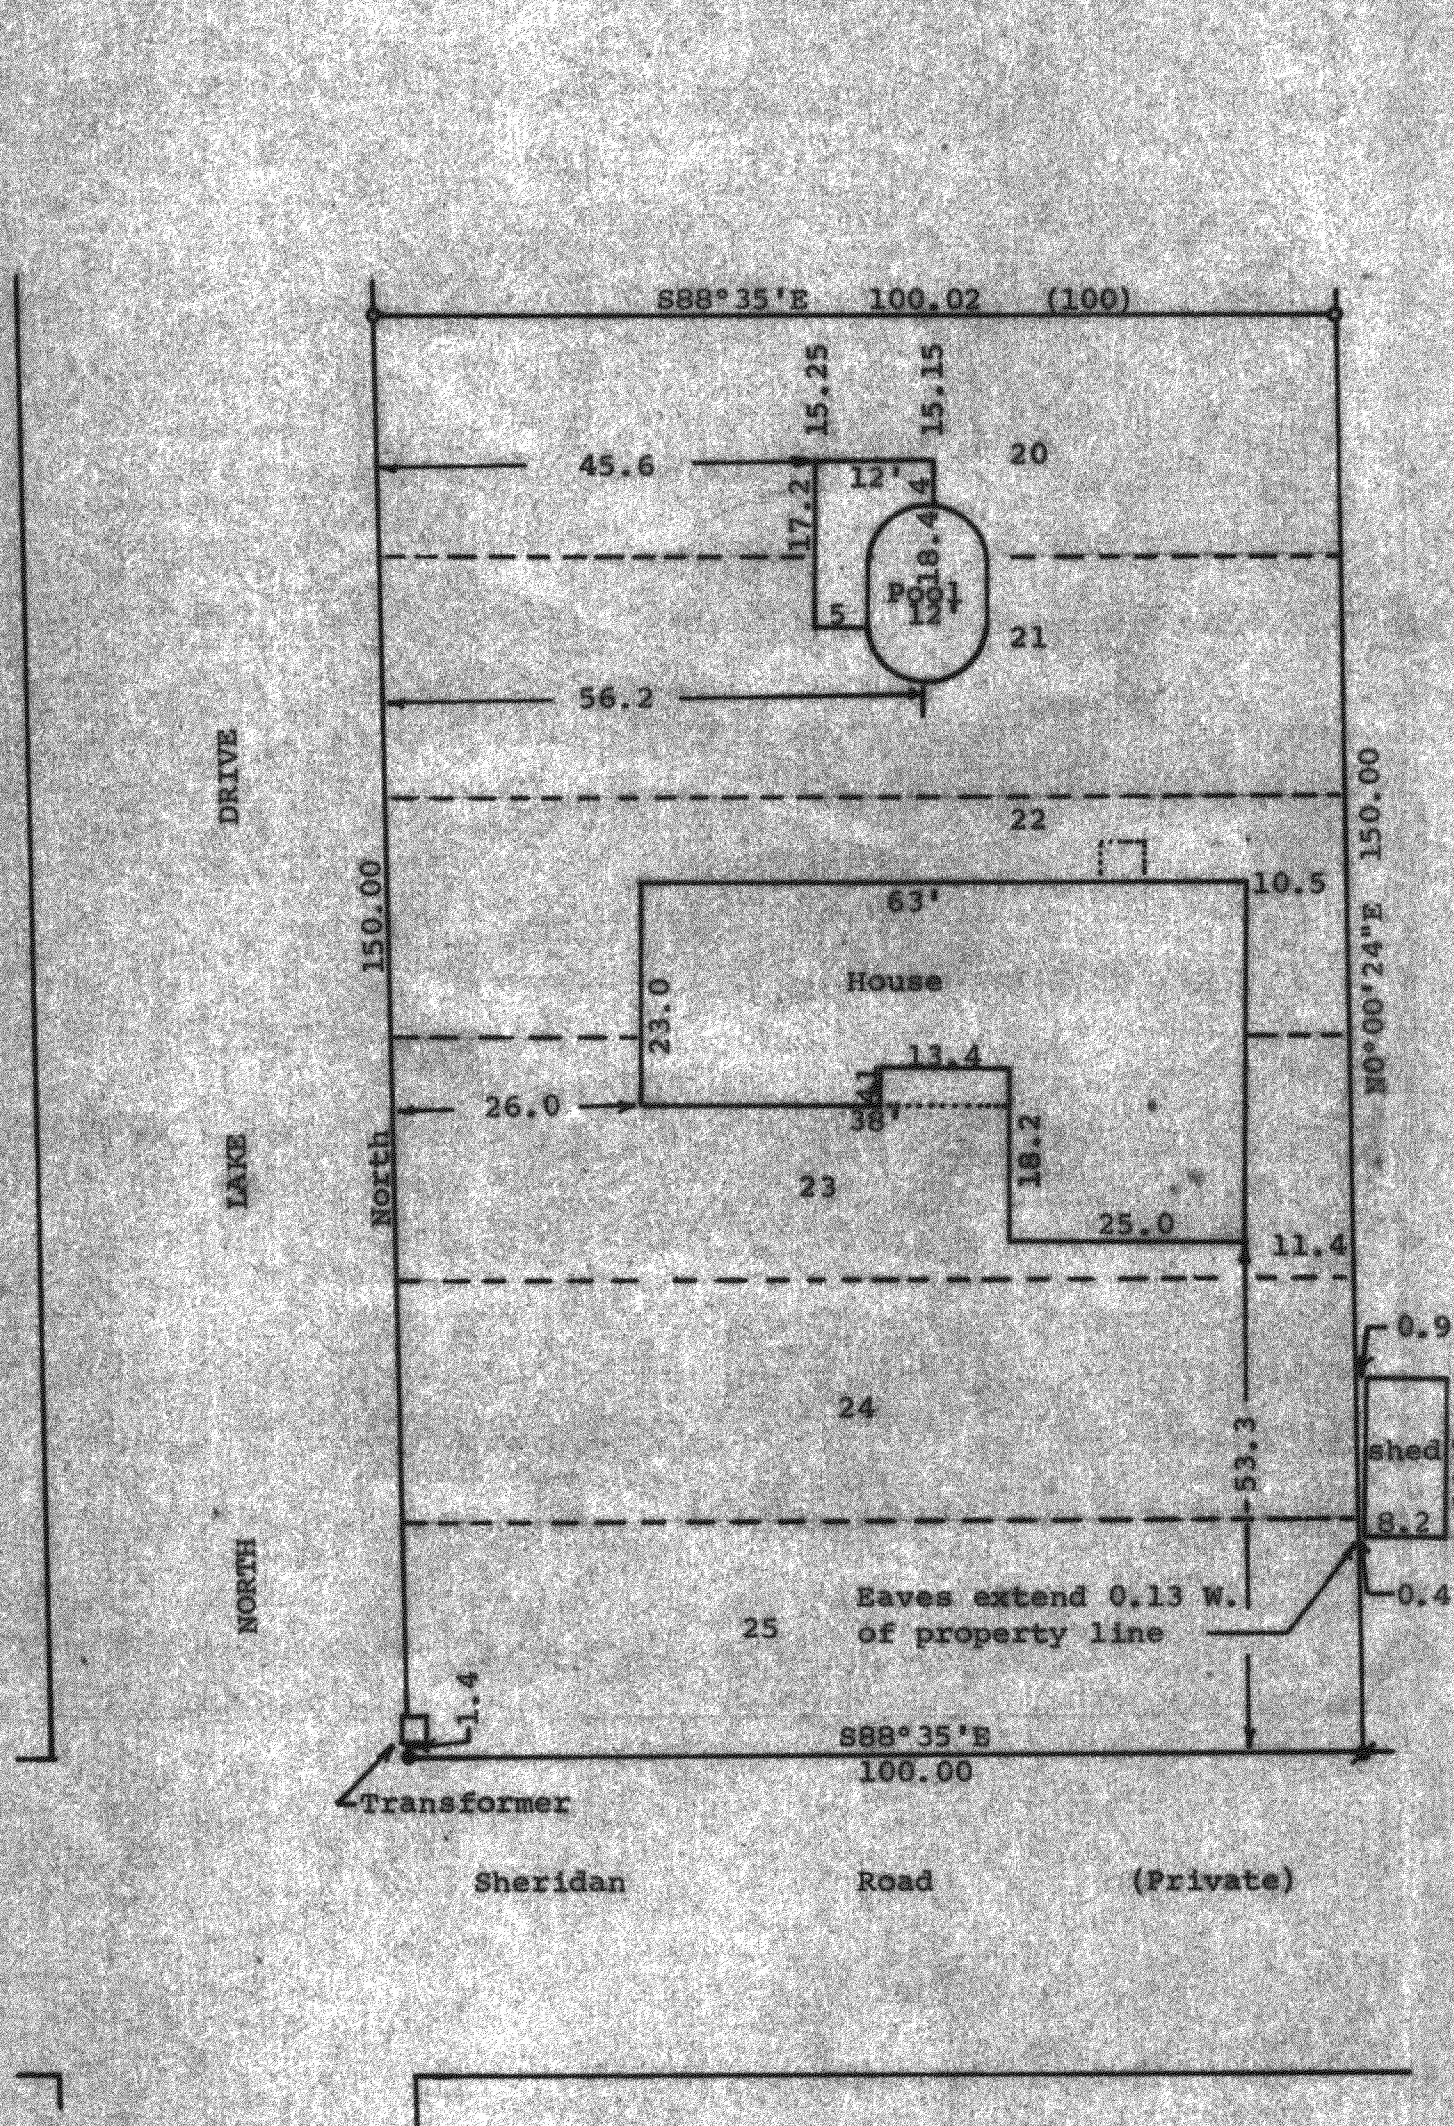


DUNHAM SURVEYING, S.C.
SURVEYING & SUBDIVIDING
DELAVER, WISCONSIN 53115

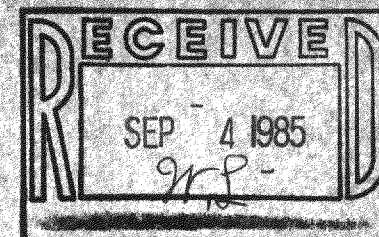

Scale - 1" = 20'
 o = 3/4" Iron Pipe Found
 • = 1 1/4" Iron Pipe Found
 s = 1 1/4" Iron Pipe Found and corrected
 (0.00) = recorded distance
 Bearings referenced to the assumed bearing of North
 along the east line of North Lake Drive
 Survey ordered by: Keefe Real Estate
 Better Homes & Gardens
 302 E. Walworth Avenue
 Delavan, WI 53115

STATE OF WISCONSIN)
 COUNTY OF WALWORTH) SS

I, George T. Dunham, Surveyor, certify that I have surveyed
 the property described as follows:

Lots 20, 21, 22, 23, 24, and 25, Block "M", in North Lake
 Beach Tract # 2, Town of Sugar Creek, Walworth County, Wisconsin,
 and that the map shown above is a true representation thereof and shows the
 size and location of the property, its exterior boundaries, the location of
 all visible structures and dimensions of all principal buildings thereon,
 boundary fences, apparent easements, roadways and visible encroachments, if
 any, and that I have surveyed the property hereon described according to the
 official records, to the best of my knowledge and belief.
 April 17, 1985

George T. Dunham
 George T. Dunham, Surveyor

