
RECEIVED
APR 25 1986

PLAT OF SURVEY

WISCONSIN
JAMES M. JENSEN
ELKHORN
WISCONSIN
S-121
LAND SURVEYOR

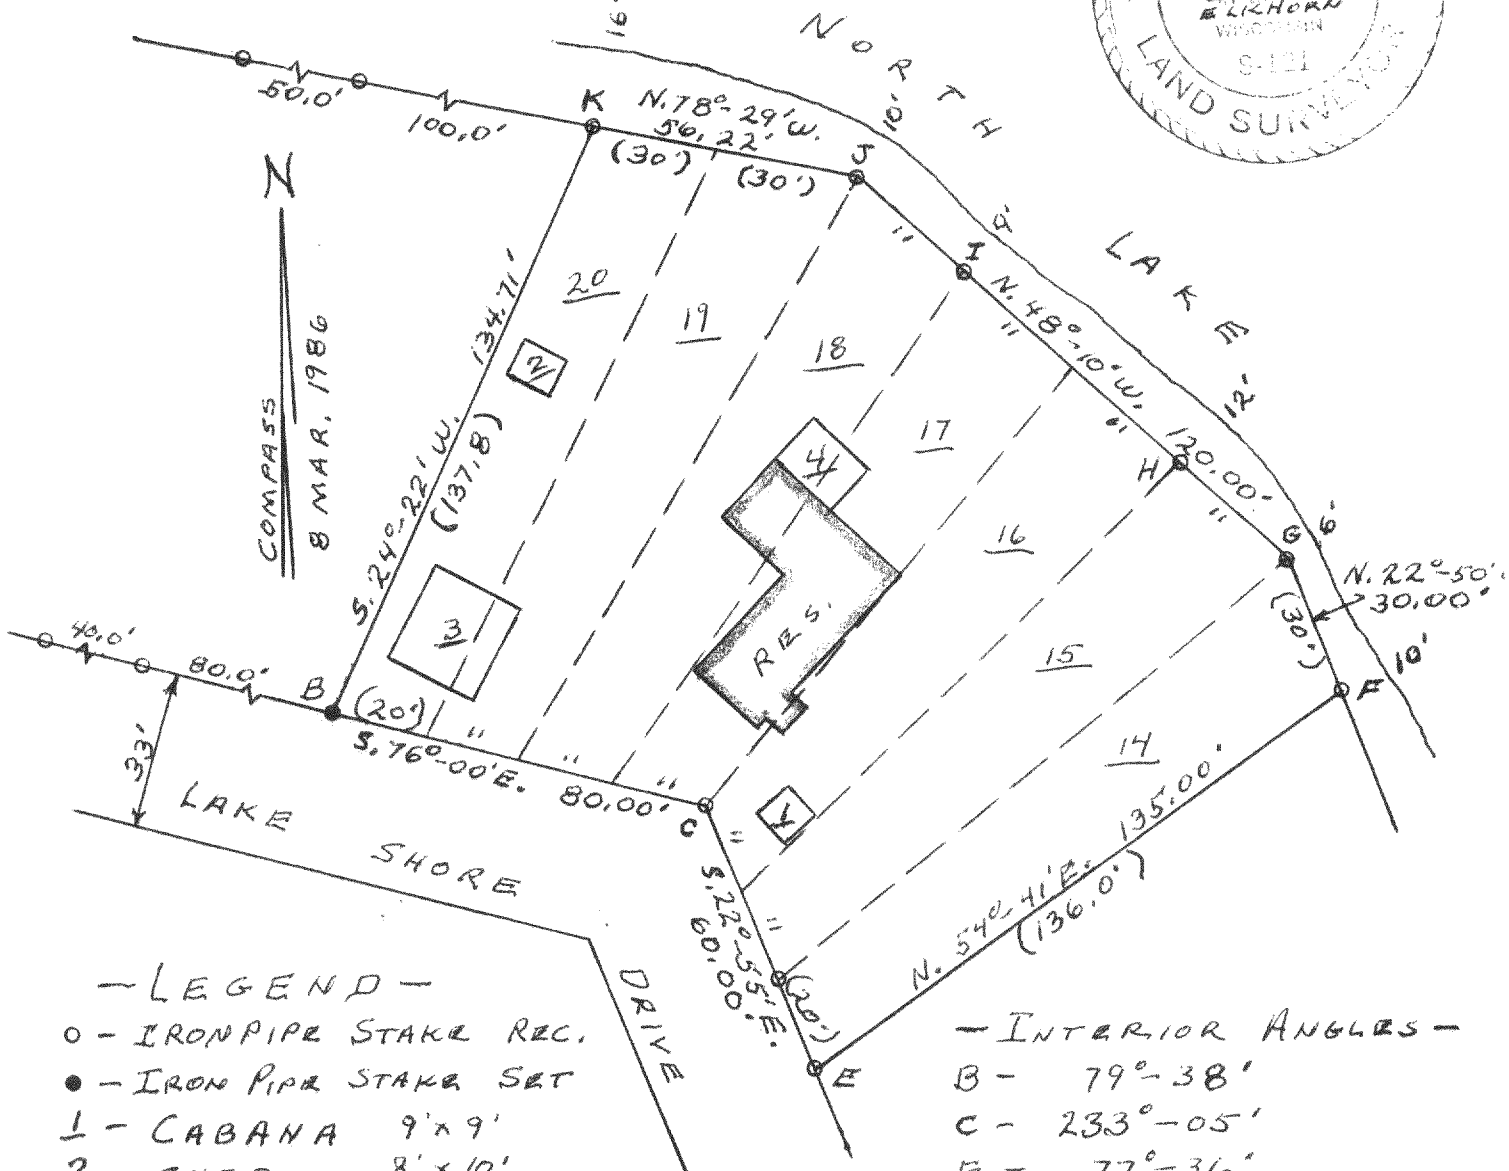

—LEGEND—

o - IRON PIPE STAKE REC.
● - IRON PIPE STAKE SET
1 - CABANA 9'x9'
2 - SHED 8'x10'
3 - GARAGE 20'x22'
4 - PATIO 12'x16'
( ) - RECORDED DISTANCE
SCALE 1" = 40'

—INTERIOR ANGLES—

B - 79°-38'
C - 233°-05'
E - 77°-36'
F - 102°-29'
G - 154°-40'
J - 149°-41'
K - 102°-51'

I, JAMES M. JENSEN, OWNER, DO HEREBY CERTIFY THAT I HAVE SURVEYED LOTS 14 THROUGH 20, BLOCK A, NORTH LAKE BEACH, TRACT 1, LOCATED IN SECTION 5, TOWN 3 NORTH, RANGE 16 EAST, WALWORTH COUNTY, WISCONSIN AND THAT THE ABOVE PLAT IS A TRUE REPRESENTATION OF THAT SURVEY.

James M. Jensen — 10 Mar. 1986

JAMES M. JENSEN — DATE
REGISTERED WISCONSIN LAND SURVEYOR No. S-121

GNLB-00009

316-352