NOTE: ALL BUILDING SETBACK LINES ARE MEASURED FROM THESE LINES TO ALLOW FOR WIDENING AVATAIA TRAIL TO 66' WIDE IN THE FUTURE, BY OTHERS.

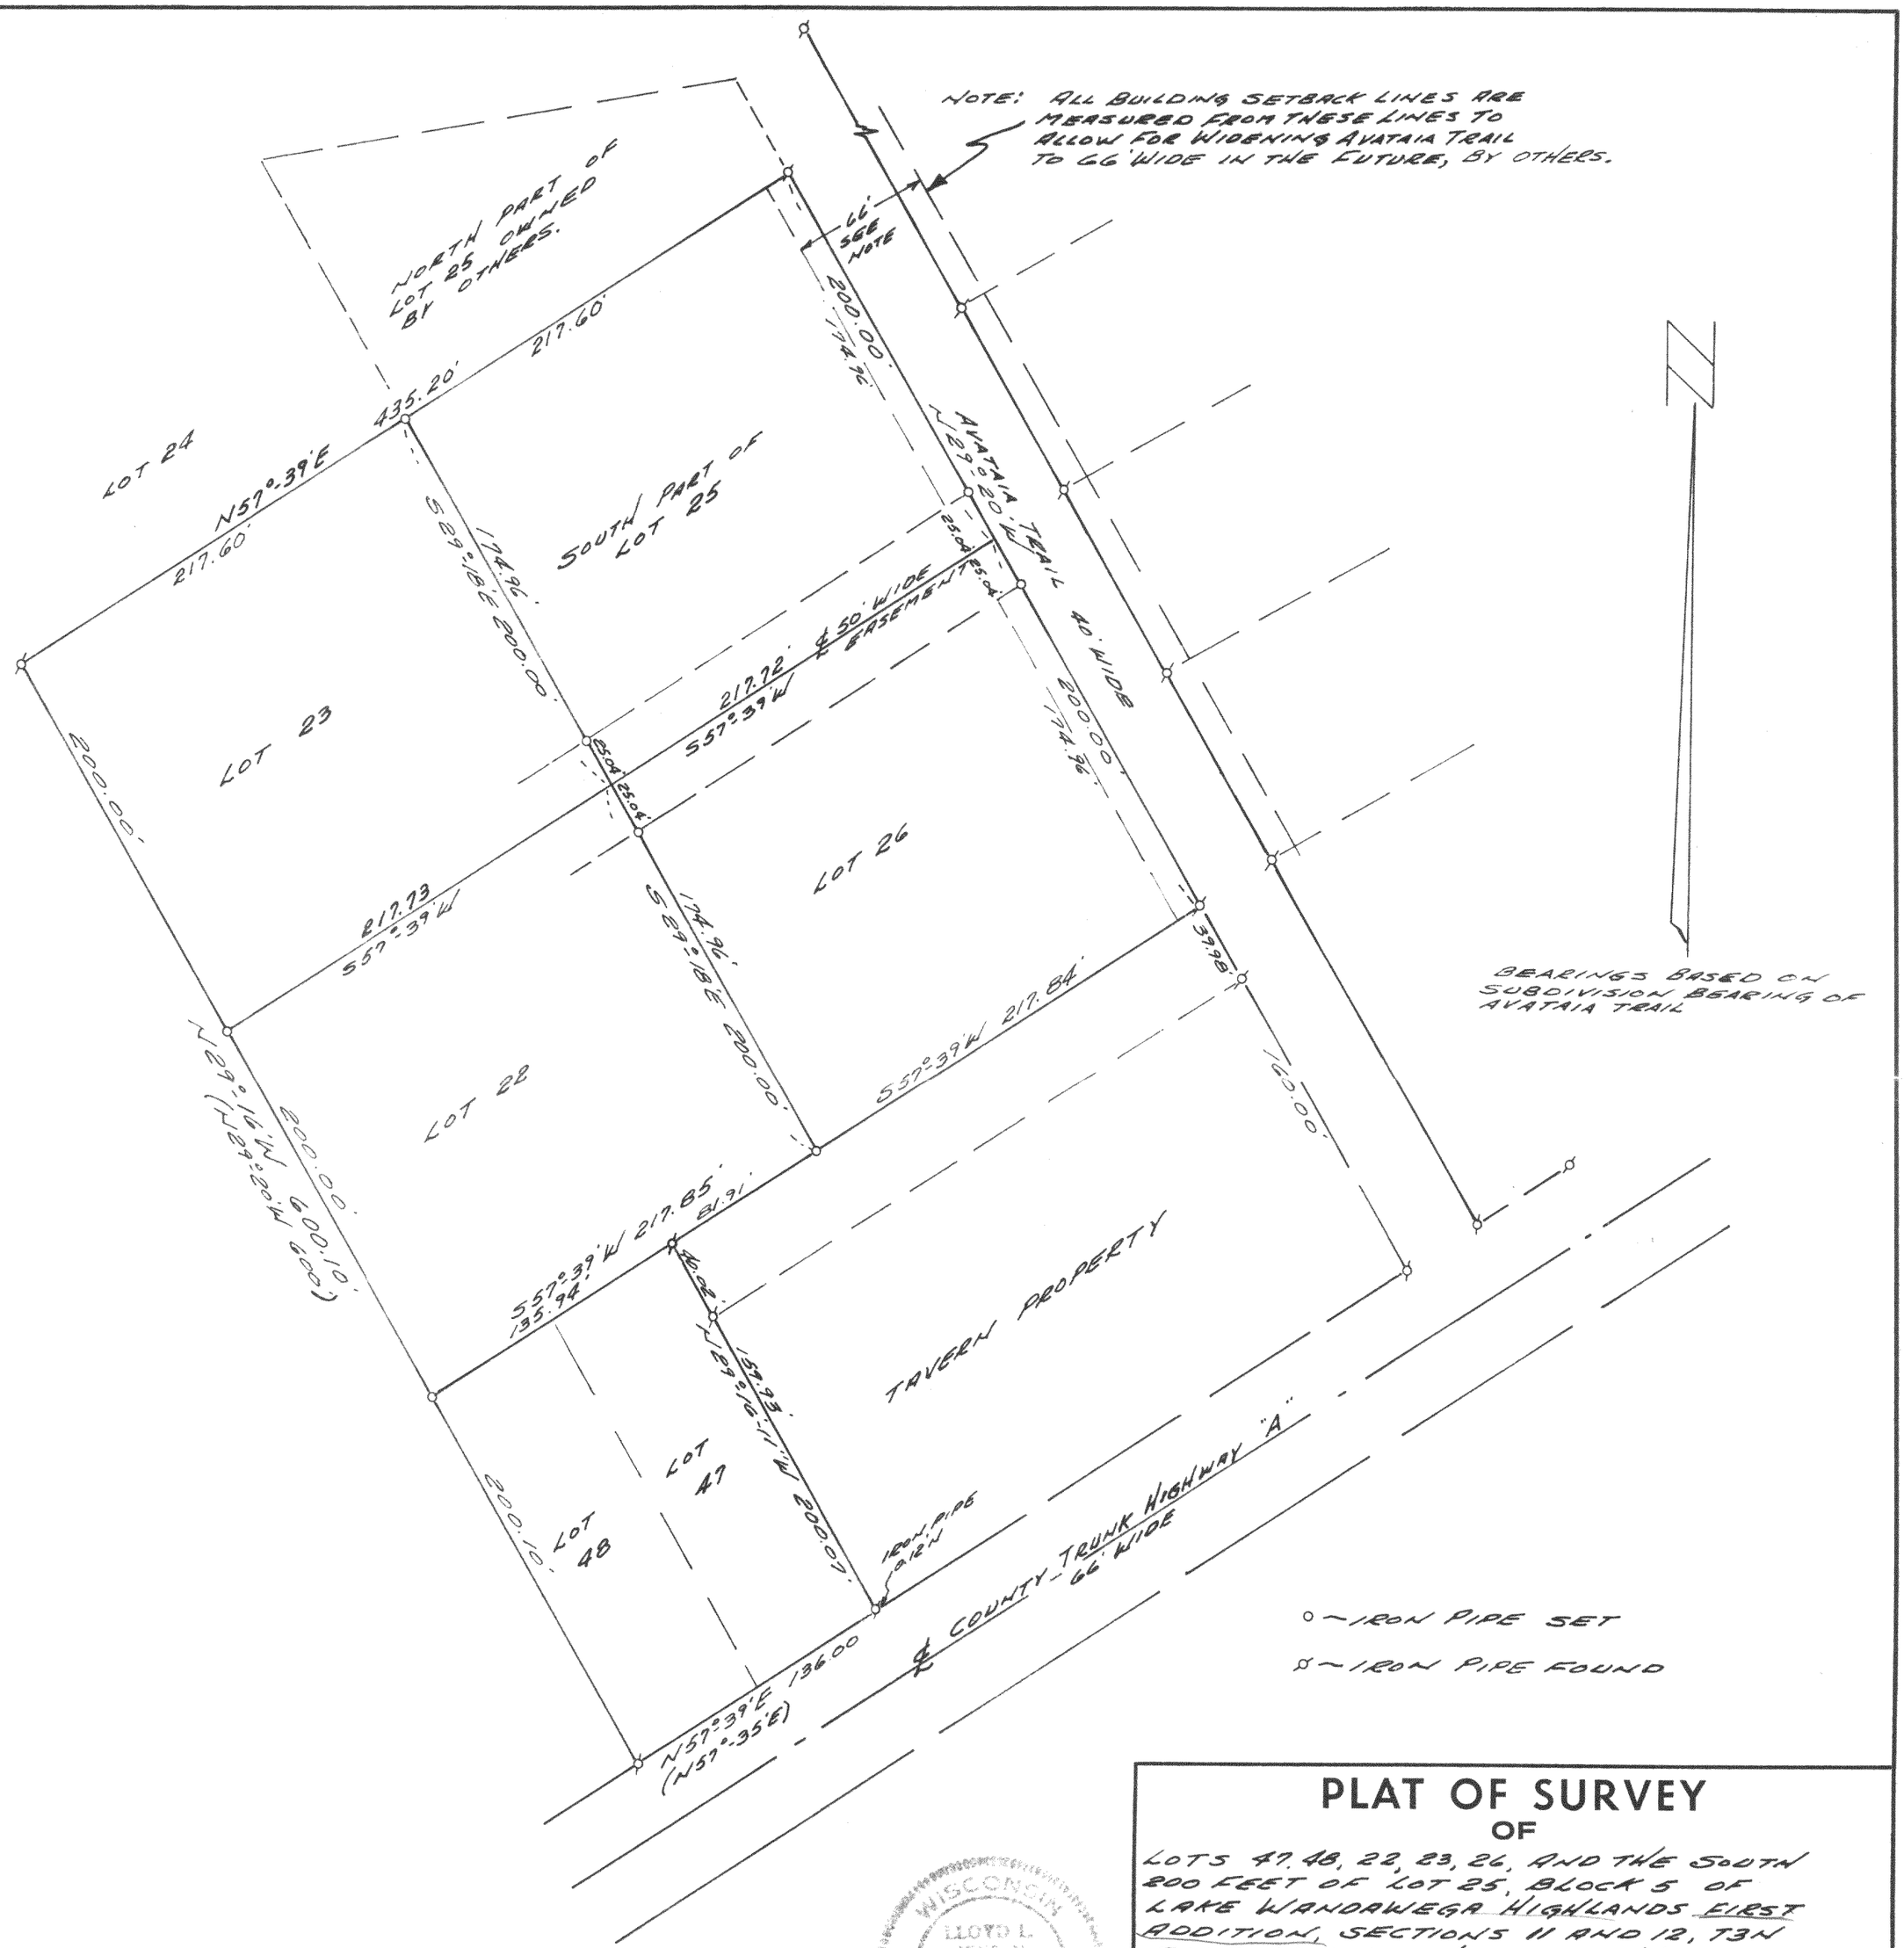

PLAT OF SURVEY

OF

LOTS 47, 48, 22, 23, 26, AND THE SOUTH 200 FEET OF LOT 25, BLOCK 5 OF LAKE WANDAWEGA HIGHLANDS FIRST ADDITION, SECTIONS 11 AND 12, T3N R16E, WALWORTH COUNTY, WISCONSIN.

WISCONSIN LLOYD L. JENSEN 9211 ELKHORN, WIS. LAND SURVEYOR

Lloyd L. Jensen
SURVEYOR

SCALE 1" = 60'

DATE APRIL 20, 1971

GWHA - 103, 93A, 94, 97, 98

POST NO. 175H 300 9-68

316-39.1