
59-52

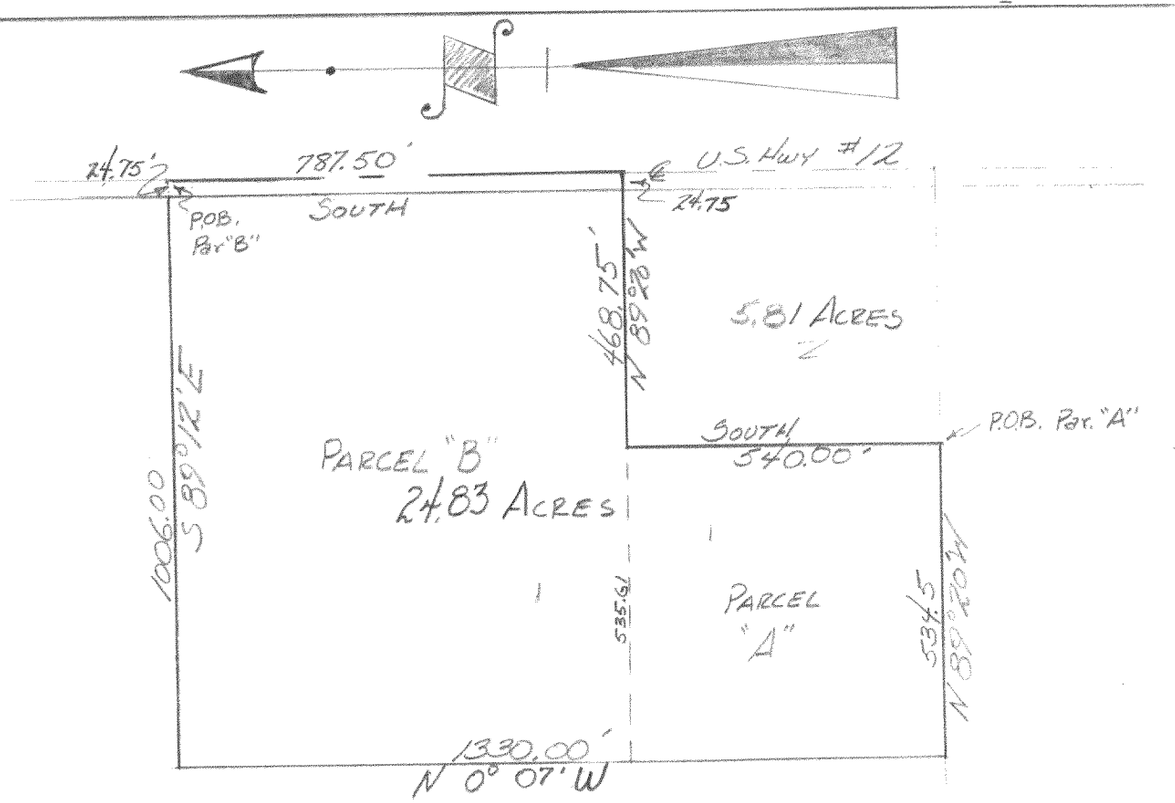

DESCRIPTION: Parcel "A"
Commencing at a point that is 468.75 feet N. 89° 20' West of the South East corner of the North East ¼ of the North East ¼ of Section 25 Town 3 North, Range 16, East, Walworth County, Wisconsin, thence North 89° 20' West 534.50 feet to a point, thence North 0° 07' West 540.00 feet to a point, thence South 89° 20' East 535.61 feet to a point thence South 540.00 feet to the P.O.B.(6.626 acres.)
Parcel "B"
Commencing at the North East corner of the North East ¼ of Section 25, Town 3 North, Range 16 East, Walworth County, Wisconsin, thence South 787.50 feet to a point, thence N 89° 20' West 1004.36 feet to a point, thence North 0° 07' West 790.00 feet to a point, thence South 89° 12' East 1006.00 feet to the P.O.B. (18.201 acres)

CERTIFICATE: I, James F. Biagi, surveyor do hereby certify that I have on this 26th day of August, 1959, surveyed the above described property.

Signed and Sealed this 27th day of August, 1959.

James F. Biagi
Land Surveyor (272)

SC-25-1
25-1A
316-40B