
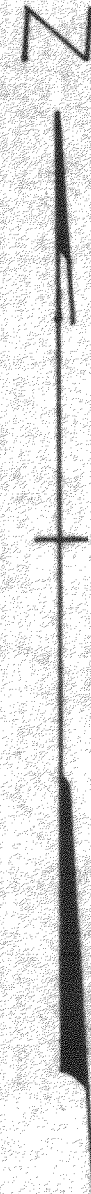


DUNHAM SURVEYING, S.C.  
SURVEYING & SUBDIVIDING  
DELAVER, WISCONSIN 53115

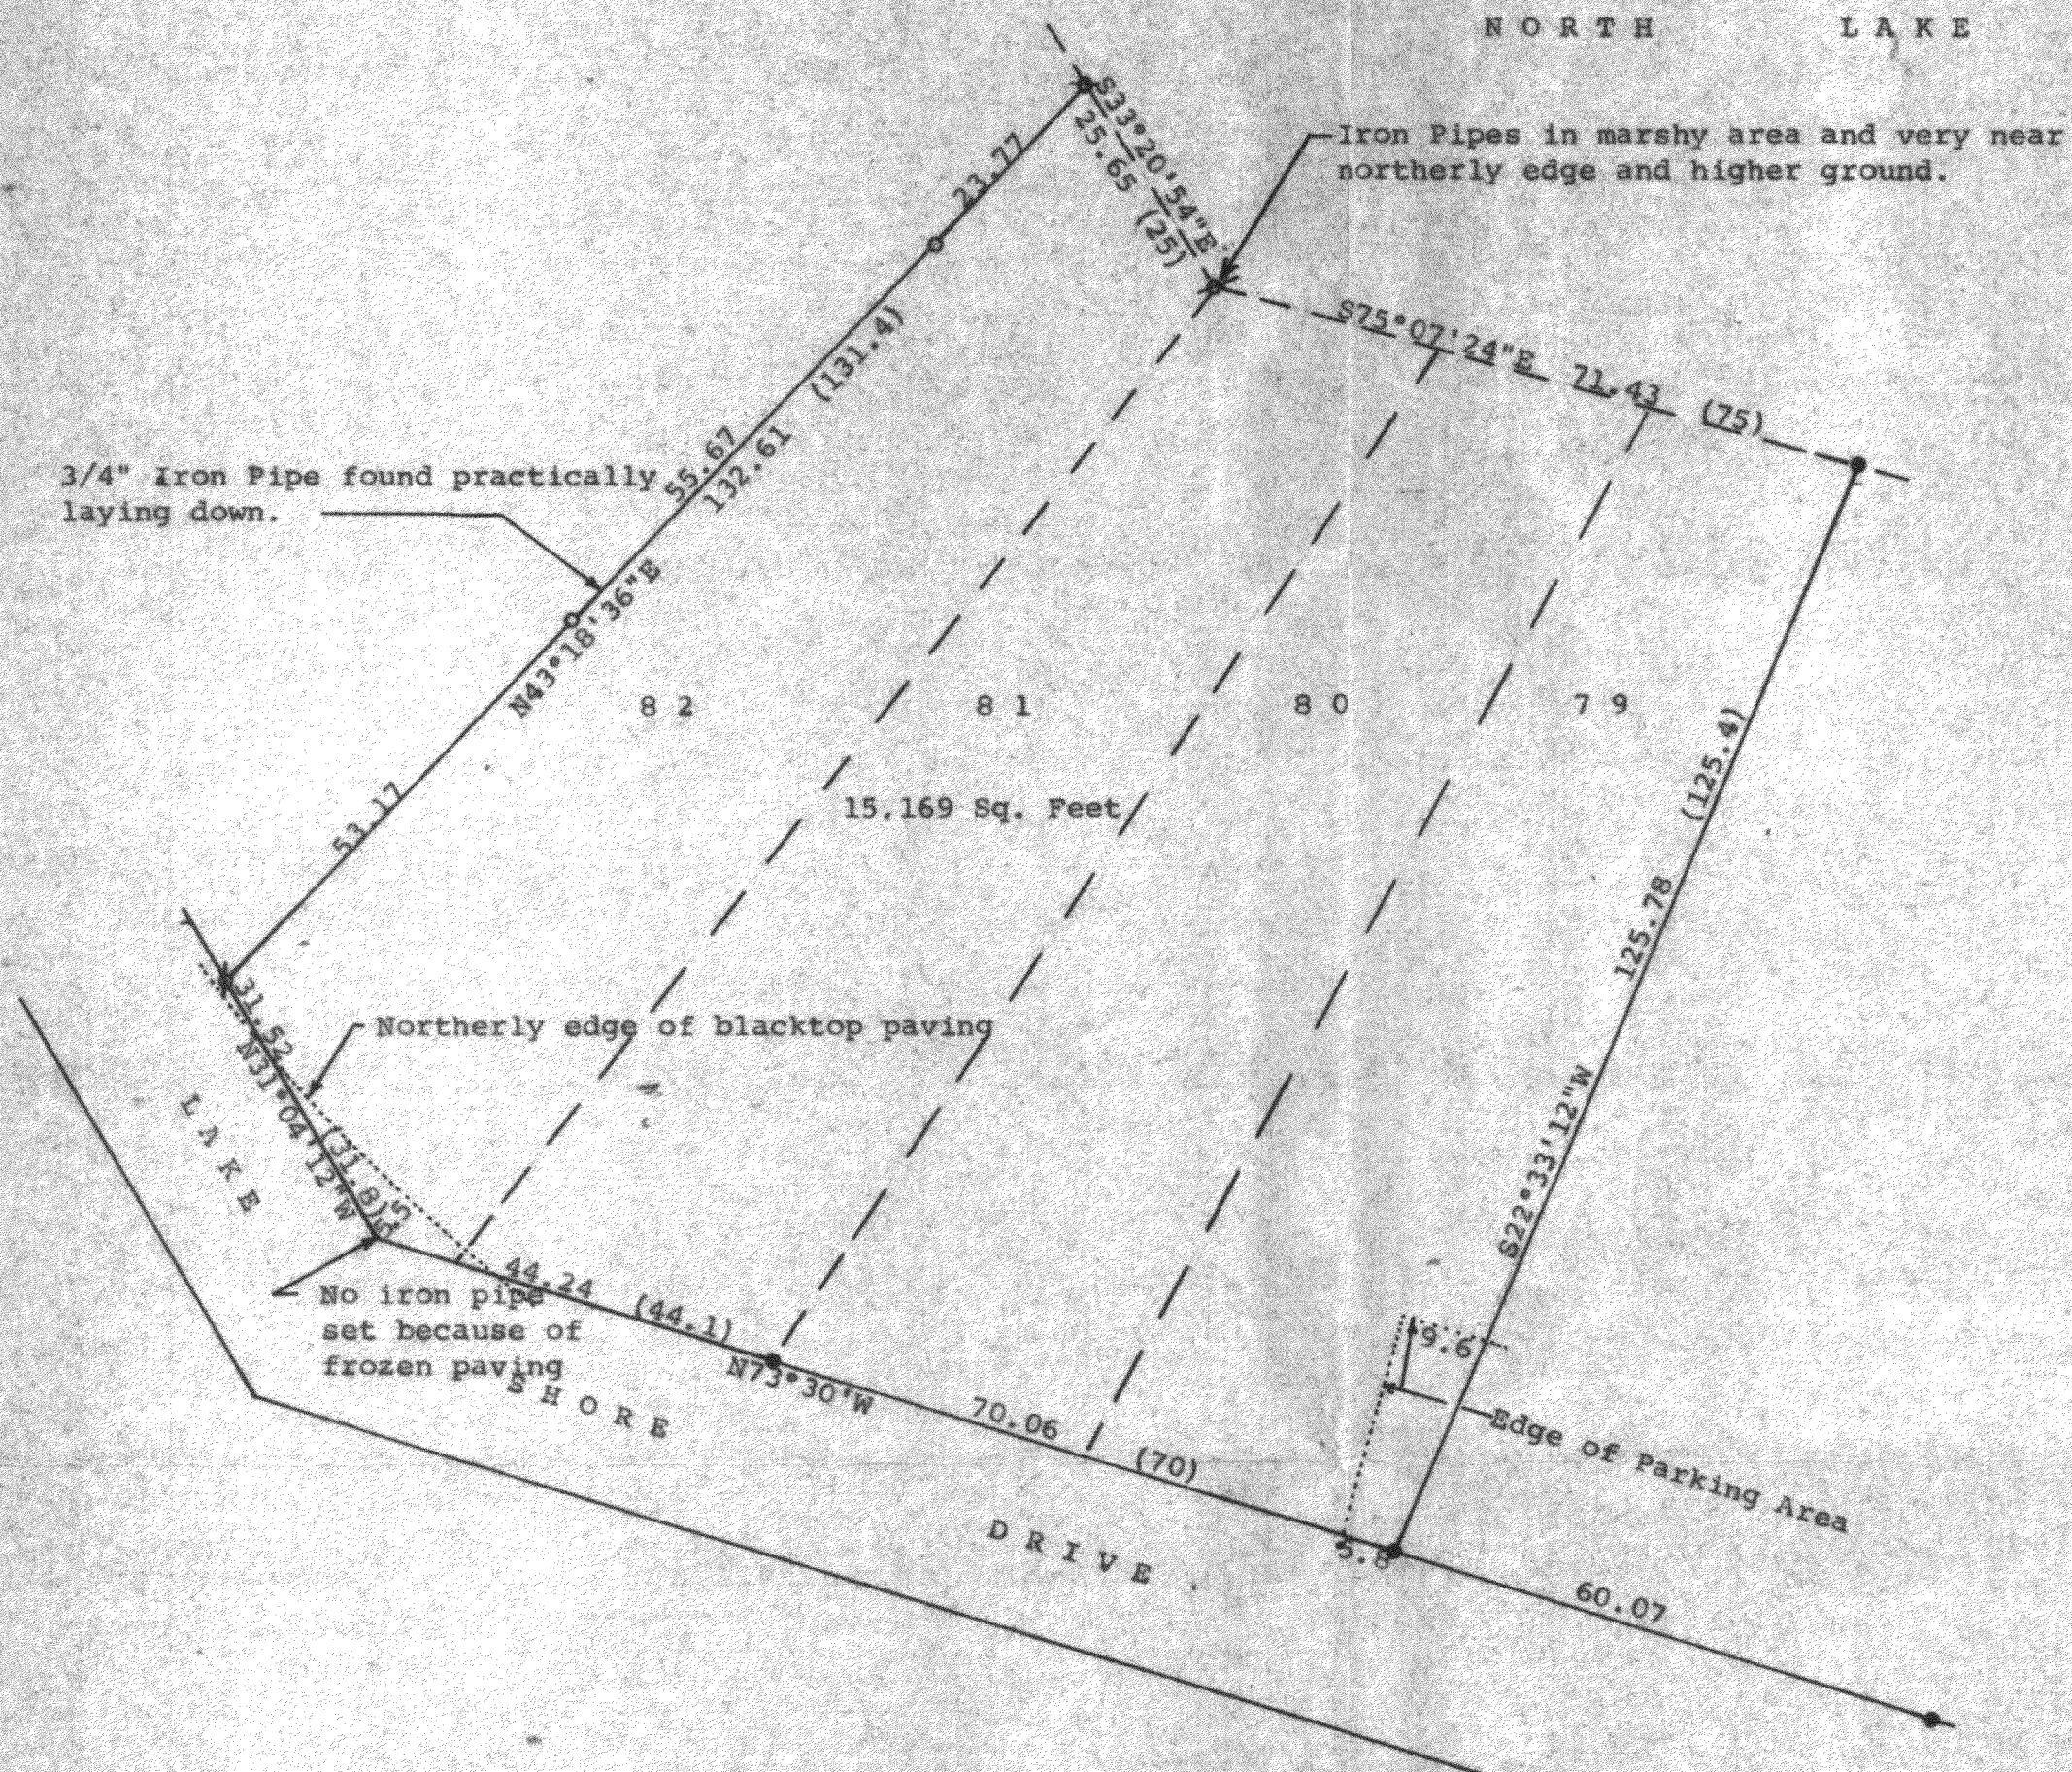


Scale - 1" = 20'

- = 1" Iron Pipe Found
- ◆ = Badly bent 3/4" Iron pipe found, pulled and reset 3/4" X 24" iron pipe
- = 1/2" Iron Pipe Found down 1'
- = Set 1 1/4" X 24" Iron Pipe over it
- ◆ = 3/4" Iron Pipe Found
- = 3/4" X 24" Iron Pipe Set

Bearings referenced to the assumed bearing of N73°30'W along the northerly line of Lake Shore Drive (0.00) = distance as shown on the recorded plat.

Survey ordered by:  
Realty World, Carmin Realtors  
811 East Geneva Street  
Delavan, WI 53115

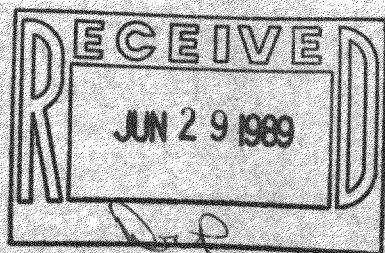

STATE OF WISCONSIN)  
COUNTY OF WALWORTH)

I, George T. Dunham, Surveyor, certify that I have surveyed the property described as follows:

Lots 79, 80, 81, and 82 in Block A in North Lake Beach Tract No. 3, a subdivision located in Sections 5 and 8, T 3 N, R 16 E, Walworth County, Wisconsin.

and that the plat shown hereon is a correct representation thereof and shows the size and location of the property, its exterior boundaries, the location of all visible structures and dimensions of all principal buildings thereon, boundary fences, apparent easements, roadways and visible encroachments, if any, and that I have surveyed the property hereon described, according to the official records, to the best of my knowledge and belief.

February 23, 1989

316-434

*George T. Dunham*  
George T. Dunham, Surveyor

