Reduced

D D Cooper & CO., INC
Rt 4 Box 508B * Elkhorn WI 53121

Plat of Survey of
Lots 5-9 & Lots
38-42, Blk 98 of
Lake Wandawega Sub.
T3N, R16E, Walworth
County, WI

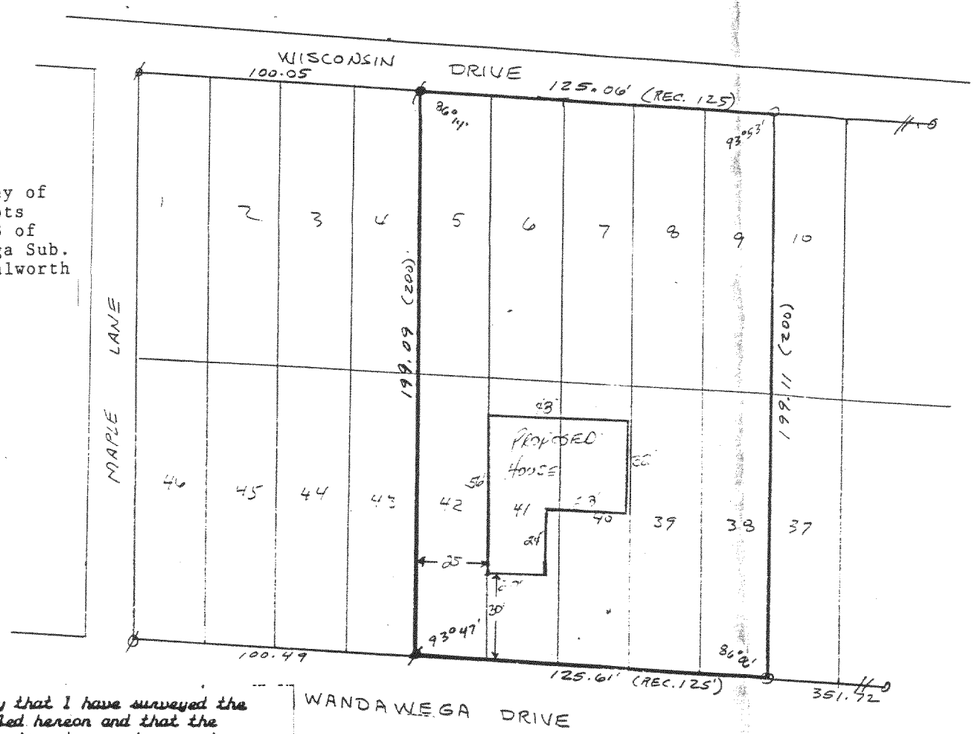

N

Legend

- ☐ Indicates county monument
- ⊘ Indicates iron pipe found
- ● Indicates 5/8" di. x 24" iron rod set
- ● Indicates iron rod found

Scale: 1" = 40'

Date: Sept. 17, 1990

Drawing No: 3686

I hereby certify that I have surveyed the property described hereon and that the map shown hereon is a true and accurate representation thereof to the best of my professional knowledge and belief.

Dated this 17 day of Sept, 1990

Daniel D. Cooper, RLS No. S-1464

RECEIVED FEB 20 1991

TAX KEY # GLW 00181 & GLW 00187

316-485