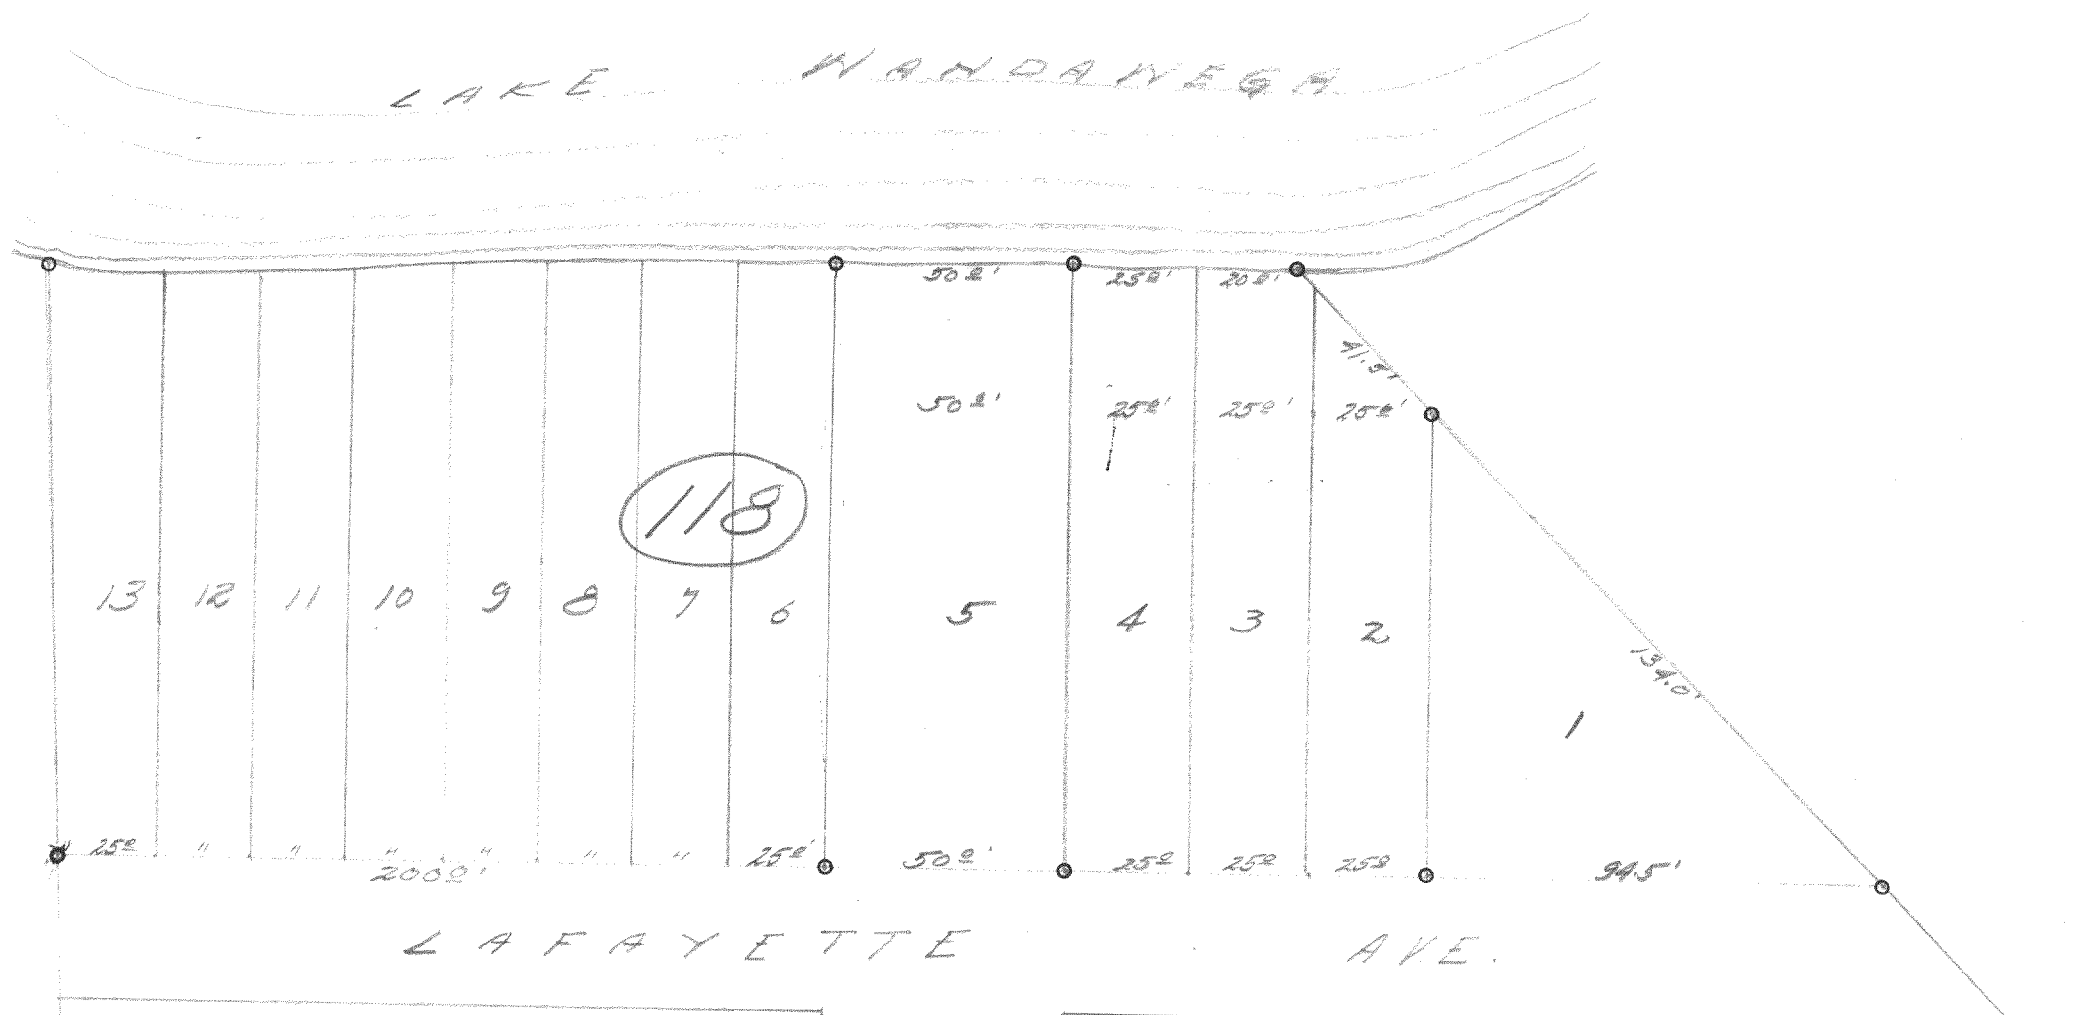


IRON STAKE

DESCRIPTION:

Lot 5, Block 118 Lake Wandawega Subdivision of a portion of Section 1, Town 3 north, Range 16 east of the 4th Principal Meridian.

CERTIFICATE:

I, hereby certify that I have on this the 28th day of August 1950, surveyed the above described property, according to the official records on file in the office of the Recorder of Deeds in and for Walworth County, Wisconsin, and find that the measurements and bearings of the boundary lines of said property as taken at the site on this day, substantially agree with those in said official record and that no encroachments exist.
SIGNED AND SEALED ON THIS THE 30TH DAY OF AUGUST 1950.

Joseph M. Biagi. Professional Engineer.
Elkhorn Wisconsin.

GLW-359

316-59B