
Plat of Survey

of

LOTS 14, 15, 41, AND 42 OF BLOCK 7 OF NORTH LAKE SHORE-WOODS, A SUBDIVISION LOCATED IN THE EAST 1/2 OF SECTION 5, T 3 N, R 16 E, TOWN OF SUGAR CREEK WALWORTH COUNTY, WISCONSIN

Surveyed for: DAVID CARLSON
RT 2, BOX 156
ELKHORN, WI 53121

BEARINGS REFERENCED TO THE WEST LINE OF MAPLE DRIVE ASSUMED AS NORTH

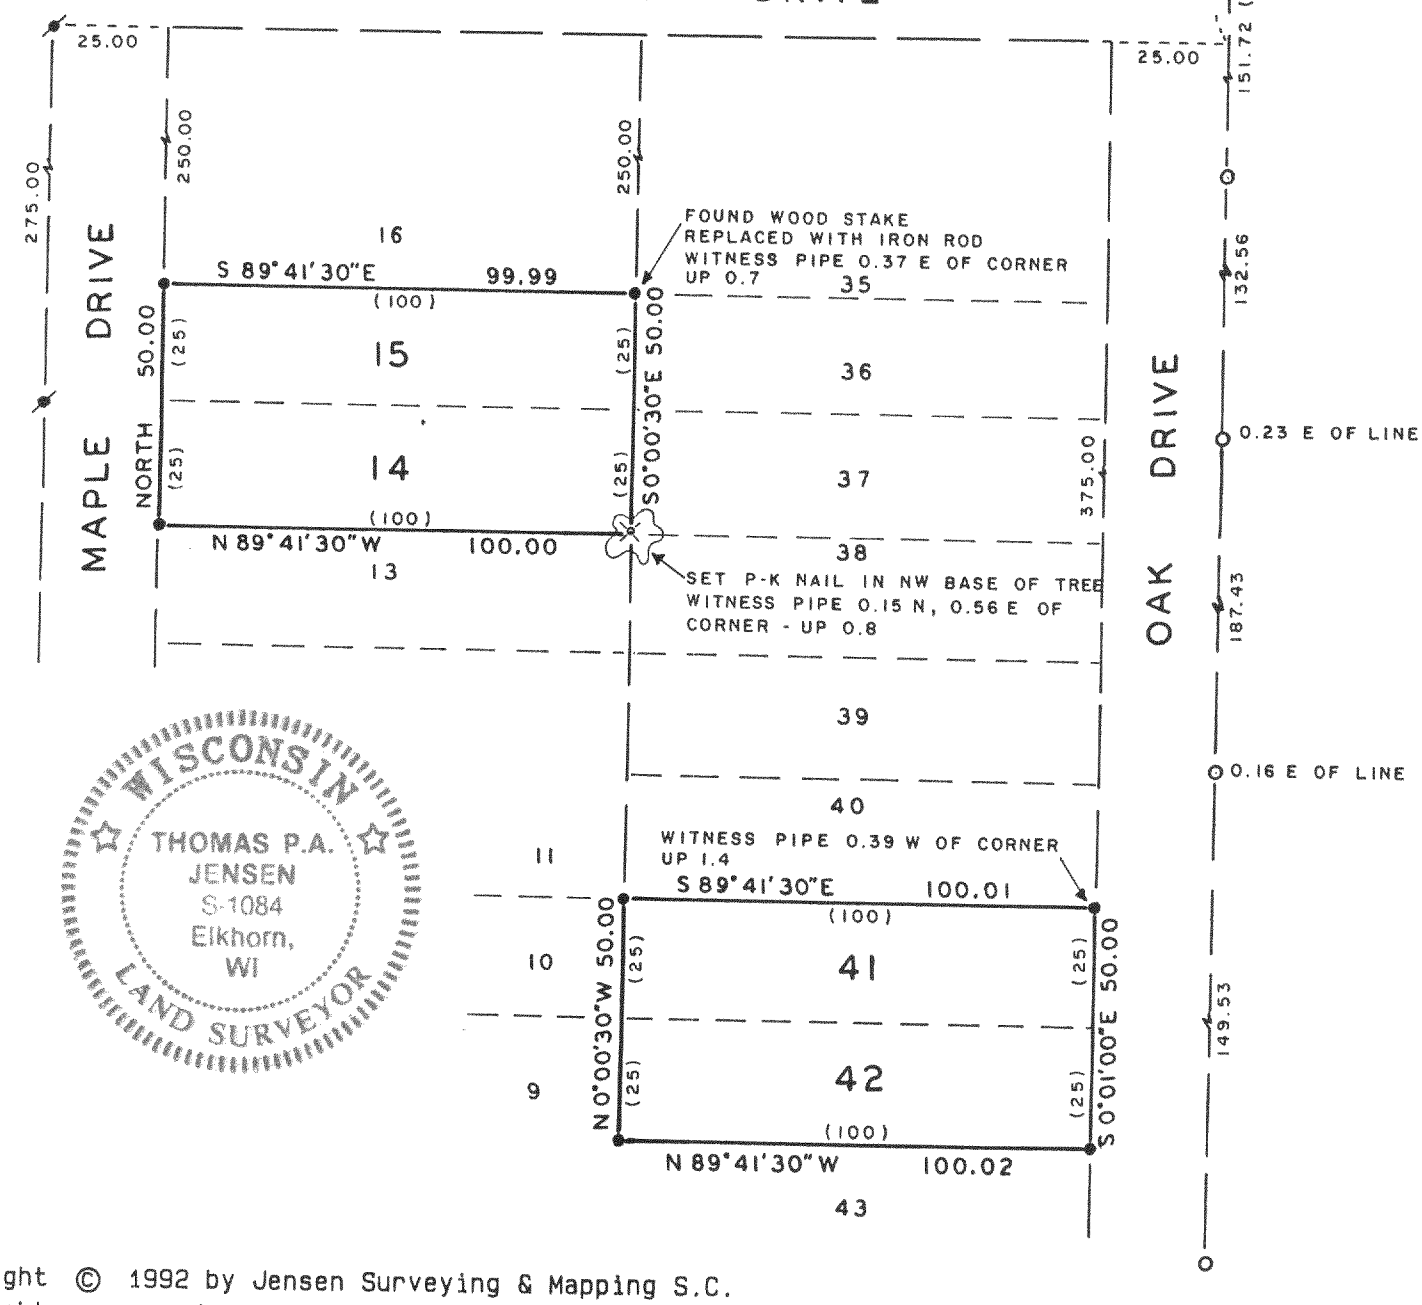

WISCONSIN
THOMAS P.A. JENSEN
S-1084
Elkhorn, WI
LAND SURVEYOR

Copyright © 1992 by Jensen Surveying & Mapping S.C.
All rights reserved. No part of this survey plat may be reproduced or transmitted in any form by any means - graphic, electronic, or mechanical, including photocopying, tracing, or information storage and retrieval systems - without permission in writing from Thomas P.A. Jensen.

I, Thomas P.A. Jensen, Wisconsin Registered Land Surveyor, do hereby certify that this survey was performed by me, or under my direction, in full compliance with the owner's/agent's instructions and Chapter A-E 7 of the Wisconsin Administrative Code ' Minimum Standards For Property Surveys ', and that this map is an accurate representation thereof to the best of my knowledge and belief.

Note: This survey plat is not certified unless signed and sealed in red ink.

RECEIVED
FEB 1 0 1993

Thomas P.A. Jensen R.L.S. 1084

Legend

- o Found iron pipe
- ✓ Found iron rod, 3/4' dia.
- • Set iron rod 3/4 dia.
- X Set P.K. nail
- Deciduous tree
- ( ) Recorded as dimension

S-74, 80, 81

Jensen Surveying & Mapping S.C.
45 South Wisconsin Street P.O. Box 322
Elkhorn, Wisconsin. 53121.
(414) 723-3434

Scale: 1 = 40'

0 20 40 80 120

Mapping date: JANUARY 14, 1992
Revisions: _____

Sheet 1 of 1 Sheets

Job reference number:
1991.210 316-603