


HAROLD H. KOLB

REGISTERED PROFESSIONAL LAND SURVEYOR
LAKE GENEVA, WISCONSIN

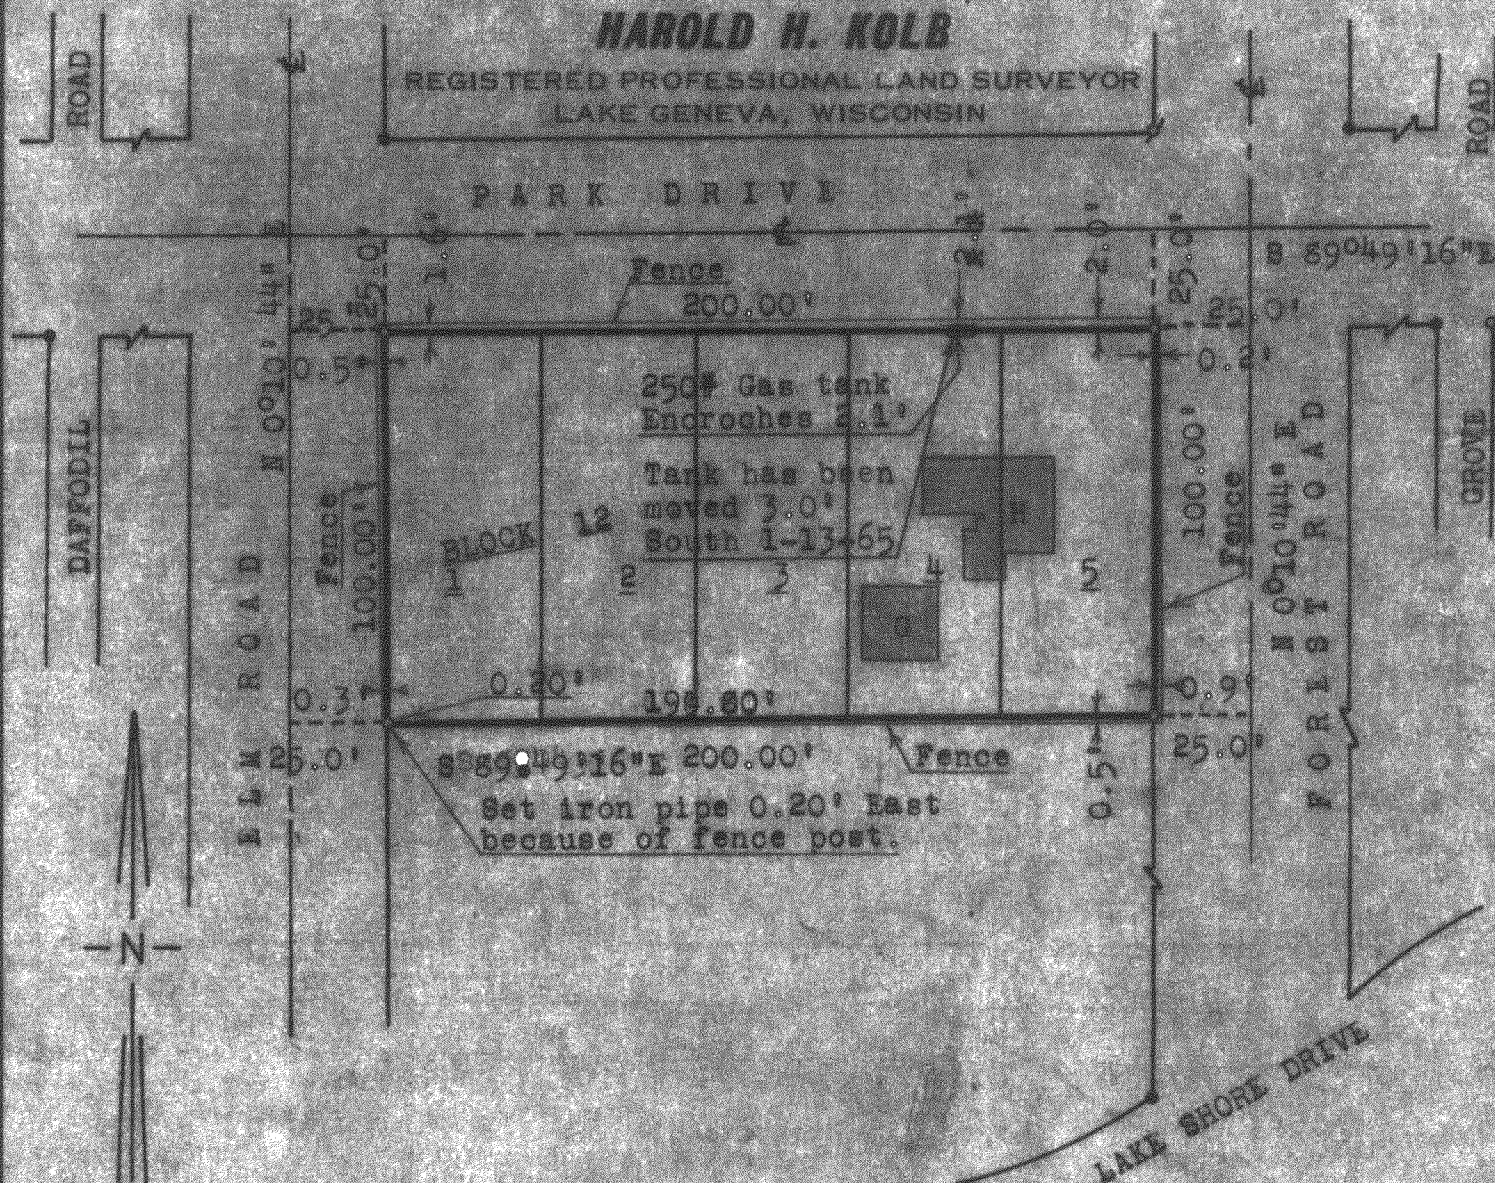

SCALE:
1" = 50'

LEGEND

- ⊙ - IRON PIPE FOUND
- - IRON PIPE PLACED
- - CONCRETE MONUMENT
- ✕ - SPIKE

PLAT OF SURVEY OF

Lots 1-5, Block 12, Interlaken, a sub-division located in Section 11, T 3 N, R 16 E, Walworth County, Wisconsin, as recorded on the Map of Interlaken as recorded in Volume 8 of Plat on Page 147.

I, HAROLD H. KOLB, DO HEREBY CERTIFY THAT I HAVE SURVEYED THE PROPERTY HEREON DESCRIBED ACCORDING TO THE OFFICIAL RECORDS, AND THAT THE PLAT HEREON IS A CORRECT REPRESENTATION OF THE LOT LINES, AND the principle line of the buildings thereon.

Harold H. Kolb

HAROLD H. KOLB
WISCONSIN REGISTERED LAND SURVEYOR, S-187
DATE January 7, 1965

REVISED: January 13, 1965

61-114

316-64