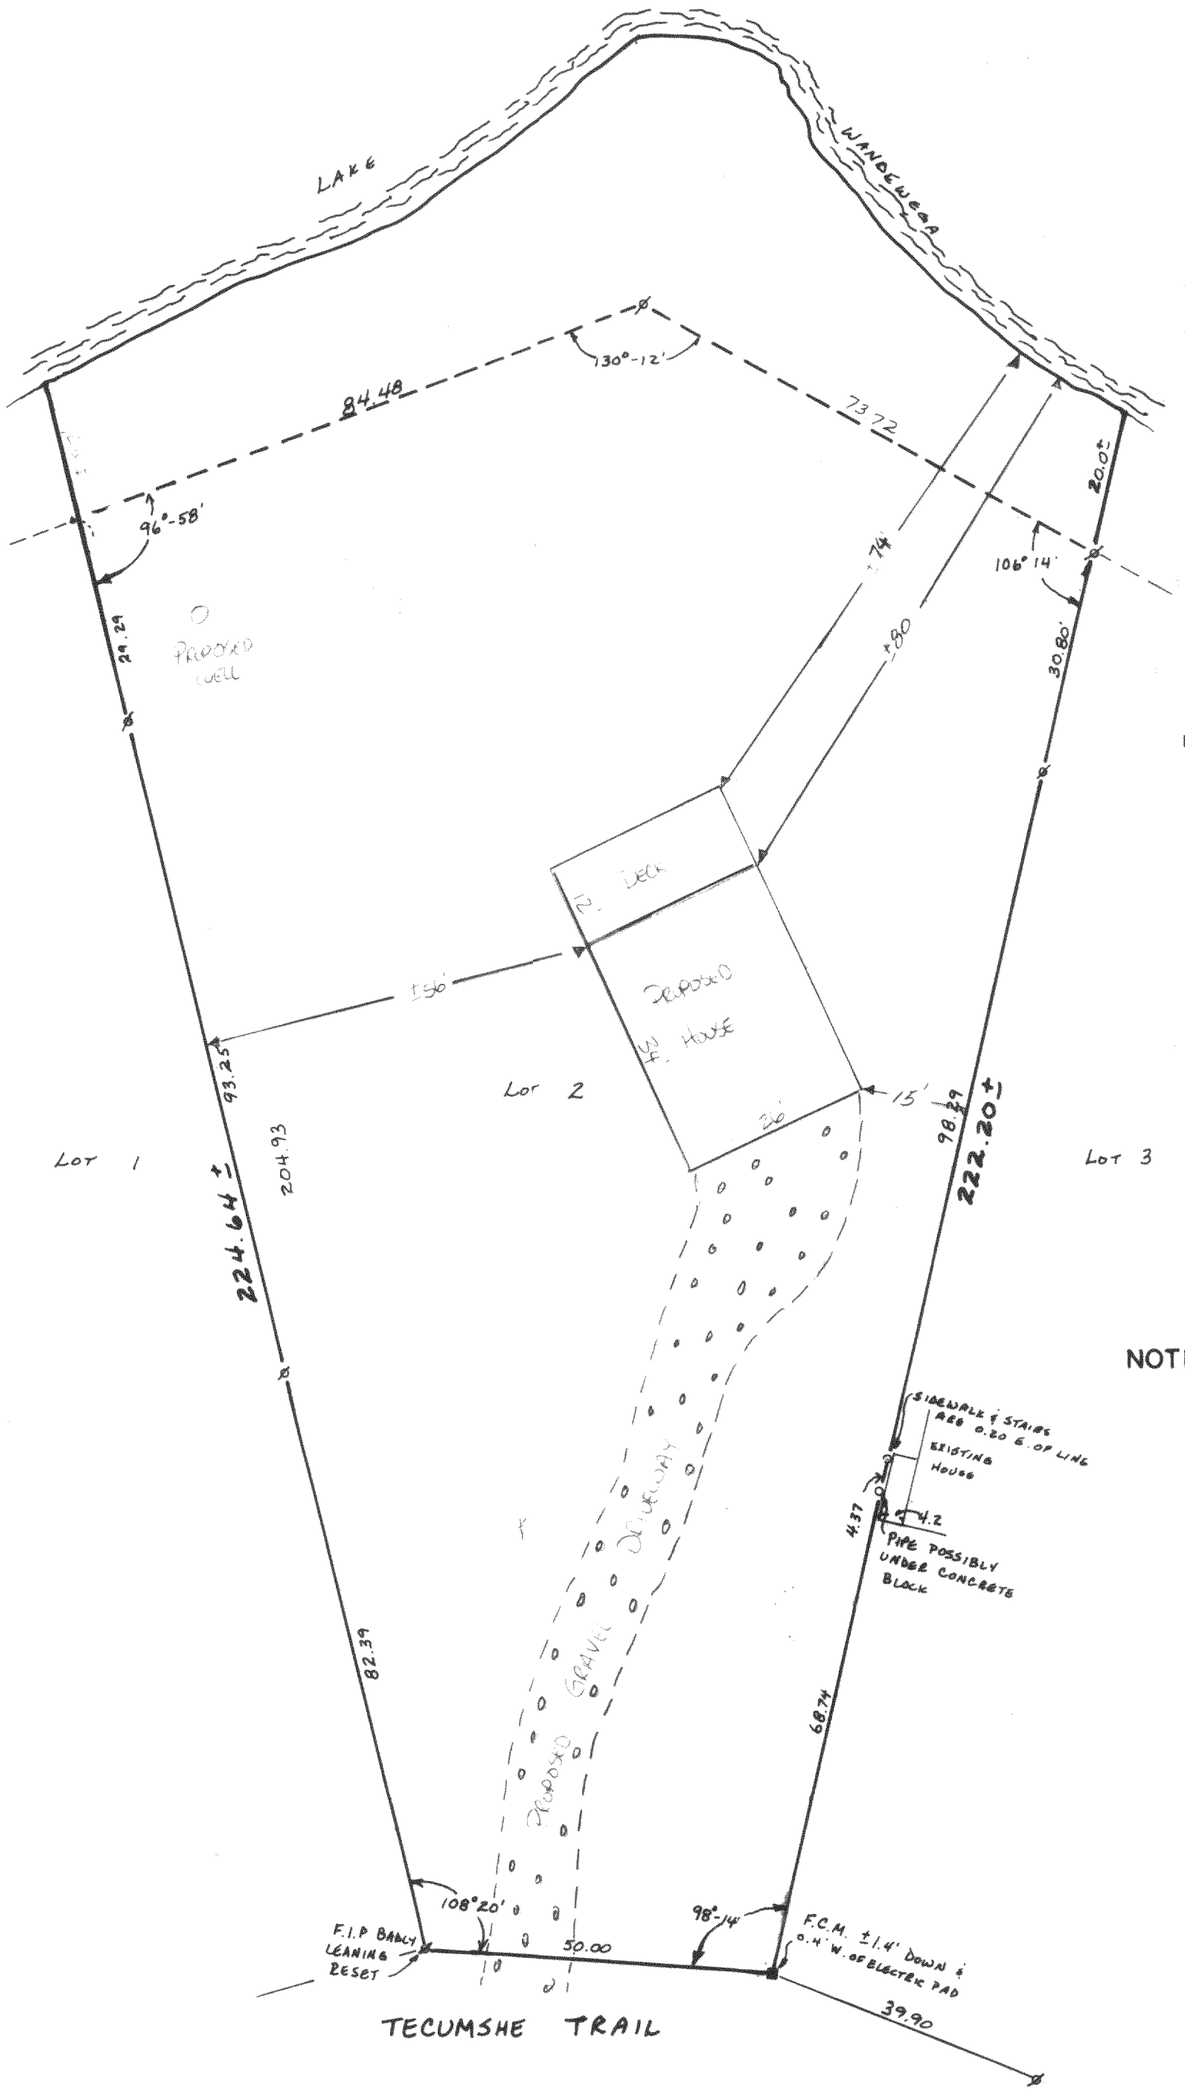


PLAT OF SURVEY
of
Lot 2, Block 2 of Lake Wandewega Highlands located in the NE 1/4 of Section 11 and the NW 1/4 of Section 12, T3N, R16E, Town of Sugar Creek, Walworth County, Wisconsin.

SURVEYED FOR: Thomas & Mary Krenzel
3651 S. Paulina
Chicago, Il. 60609

SURVEYED BY: Jensen Surveying & Mapping S.C.
45 S. Wisconsin Street
Elkhorn, Wisconsin 53121
(414) 723-3434

RECERTIFIED 8-11-92 FOR: MODERN REALTY, INC.
102 N. WISCONSIN ST.
ELKHORN, WI 53121

REVISED IN APRIL 1993 FOR: CARMEN CONSOLINO
N6899 LAKESHORE DRIVE
ELKHORN, WISCONSIN. 53121
TO SHOW PROPOSED HOUSE LOCATION.

NOTE: PROPOSED HOUSE LOCATION TAKEN FROM SKETCH PROVIDED BY OWNER. NO FIELD MEASUREMENTS WERE TAKEN TO CONFIRM THIS LOCATION.

N

SCALE - 1" = 20'

LEGEND
■ Found Concrete Monument
⚷ Found iron pipe
○ Set iron pipe

WISCONSIN
THOMAS P.A. JENSEN
S-1084
Elkhorn, WI
LAND SURVEYOR

RECEIVED
AUG 2 1993

Copyright © 1993 by Jensen Surveying & Mapping S.C.

All rights reserved. No part of this survey plat may be reproduced or transmitted in any form by any means - graphic, electronic, or mechanical, including photocopying, tracing, or information storage and retrieval systems - without permission in writing from Thomas P. A. Jensen, Jensen Surveying & Mapping S.C..

Note: This survey plat is not certified unless signed and sealed in red ink.

I, Thomas P.A. Jensen, Wisconsin Registered Land Surveyor, do hereby certify that this survey was performed by me, or under my direction, in full compliance with the owner's/agent's instructions and Chapter A-E 7 of the Wisconsin Administrative Code "Minimum Standards For Property Surveys"; and that this map is an accurate representation thereof to the best of my knowledge and belief.

Thomas P.A. Jensen R.L.S. 1084

GWH-33

RECERTIFIED 8-11-92 1992.101 ✓ 316-656

1993.018 1992.119