
LEGEND
● – INDICATES IRON PIPE FOUND
○ – INDICATES IRON PIPE SET
SCALE: 1" = 20'

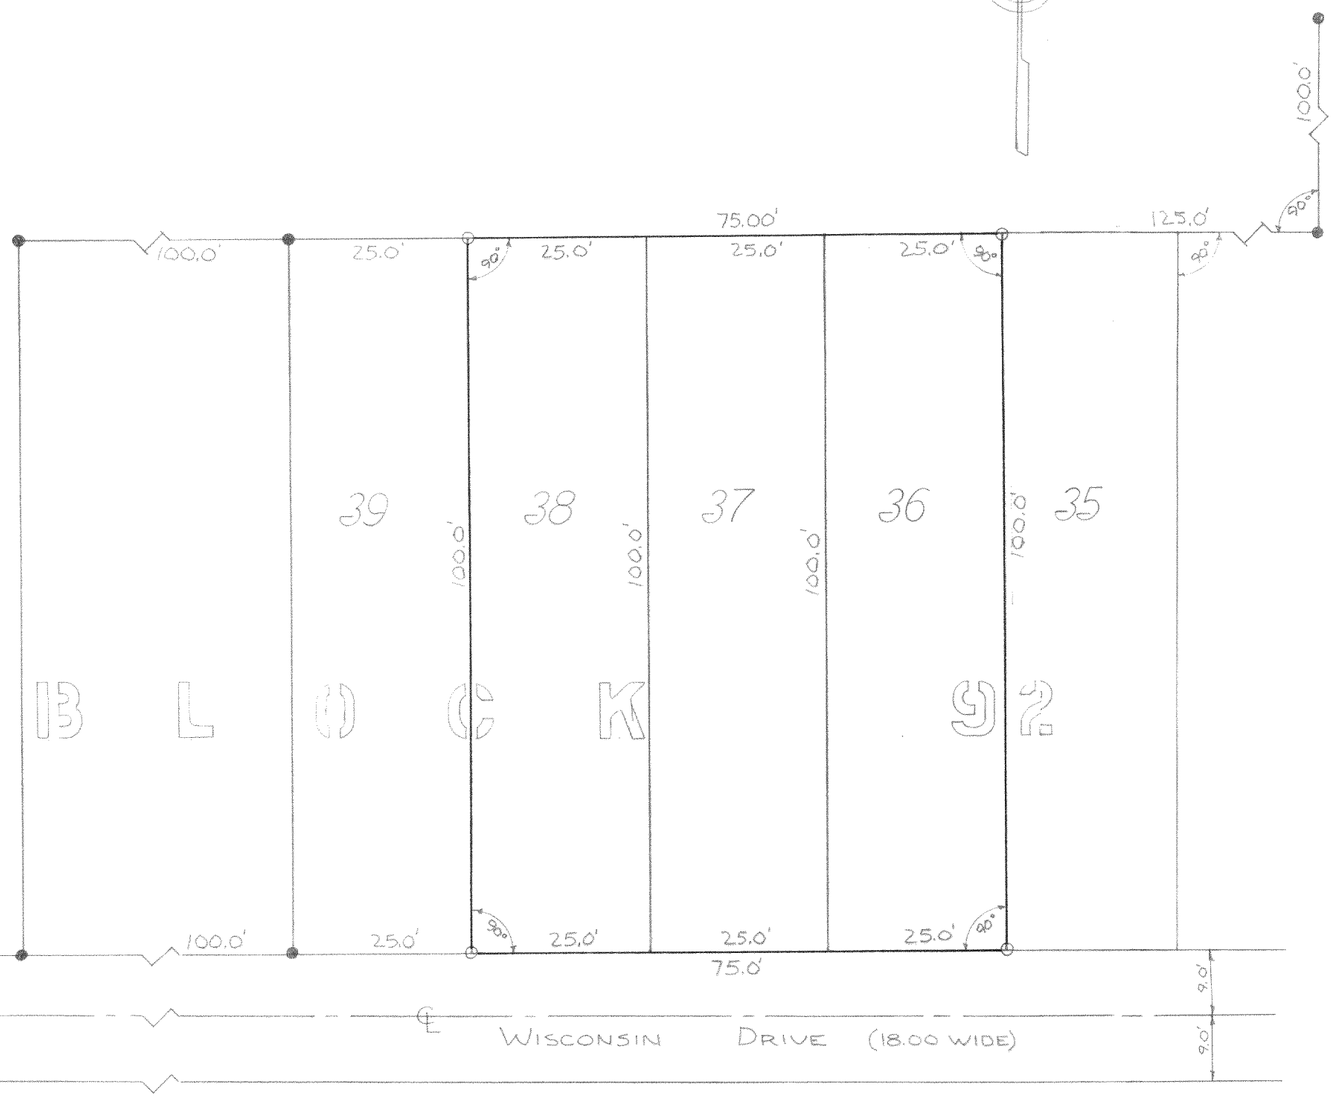

DESCRIPTION:
LOTS 36, 37, 38, BLOCK 92 OF LAKE WANDAWEGA SUBDIVISION, LOCATED IN SECTION 1, T.3N, R.16E., WALWORTH COUNTY, WISCONSIN.

CERTIFICATE:
I, JOSEPH M. BIAGI, SURVEYOR, DO HEREBY CERTIFY THAT I HAVE SURVEYED THE PROPERTY HEREON DESCRIBED.

DATED: JULY 26, 1974

Joseph M. Biagi

JOSEPH M. BIAGI R.L.S. #12
ELKHORN, WISCONSIN

WISCONSIN
JOSEPH M. BIAGI S-12 ELKHORN WIS.
LAND SURVEYOR

REVISIONS		
NO.	DATE	BY
1		
2		
3		
4		
5		

MR. KY KLATZ SURVEY

LOTS 36-38, BLK 92 - WANDAWEGA

DRAWN BY JHR	SCALE 1" = 20'	MATERIAL
CHK'D	DATE 7-26-74	DRAWING NO. # 86-74
TRACED	APP'D	


#86-74

GLW-166

TELEDYNE POST 18AE-10E—12X18

316-683

LEGEND
● – INDICATES IRON PIPE FOUND
o – INDICATES IRON PIPE SET
SCALE: 1" = 20'

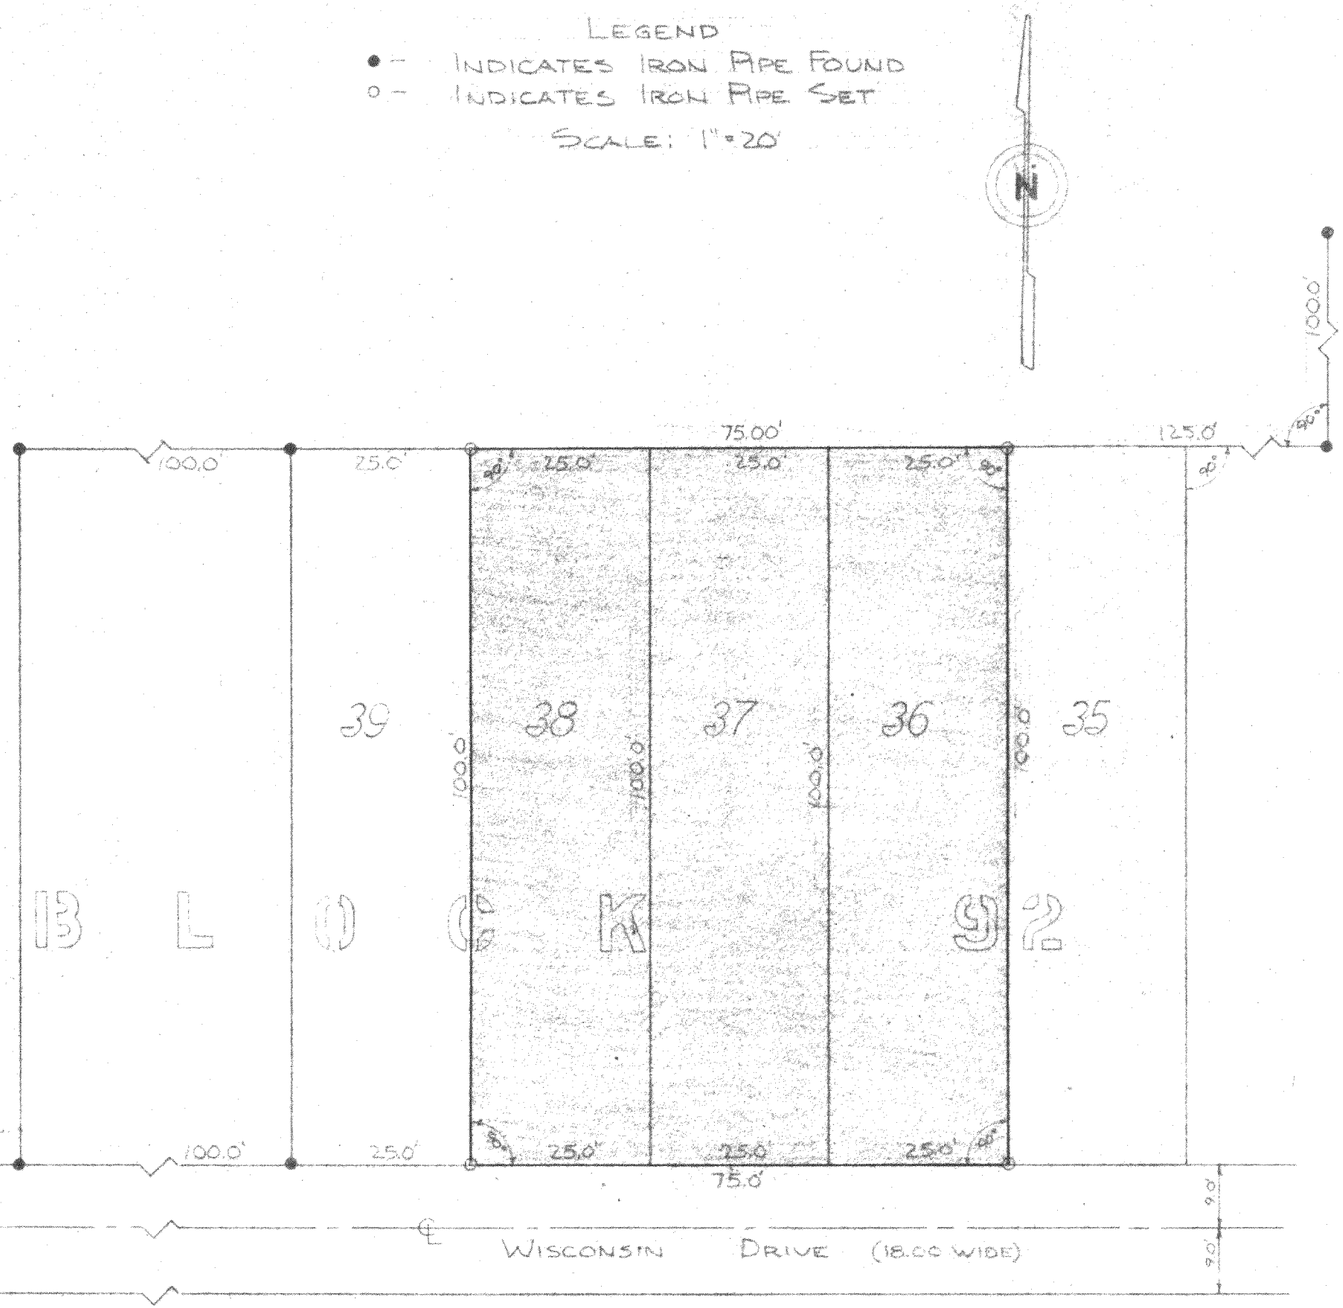

DESCRIPTION:
LOTS 36, 37, 38, BLOCK 92 OF LAKE WANDAWEGA SUBDIVISION, LOCATED IN SECTION 1, T3N, R16E, WALWORTH COUNTY, WISCONSIN.

CERTIFICATE:
I, JOSEPH M. BIAGI, SURVEYOR, DO HEREBY CERTIFY THAT I HAVE SURVEYED THE PROPERTY HEREON DESCRIBED

DATED: JULY 26, 1974

Joseph M. Biagi

JOSEPH M. BIAGI R[illegible]12
ELKHORN WIS[illegible]

WISCONSIN
JOSEPH M.
BIAGI
S-12
ELKHORN
WIS.
LAND SURVEYOR

REVISIONS			MR. KY KLATZ SURVEY		
NO.	DATE	BY	LOTS 36-38, BLK 92 - WANDAWEGA		
1					
2					
3			DRAWN BY JPR	SCALE 1" = 20'	MATERIAL
4			CHK'D	DATE 7-26-74	DRAWING NO. # 36-74
5			TRACED	APP'D	

#36-74

GLW-166

TELEDYNE POST 18AE-10E—12X18

316-[redacted]-6878