
#130-67

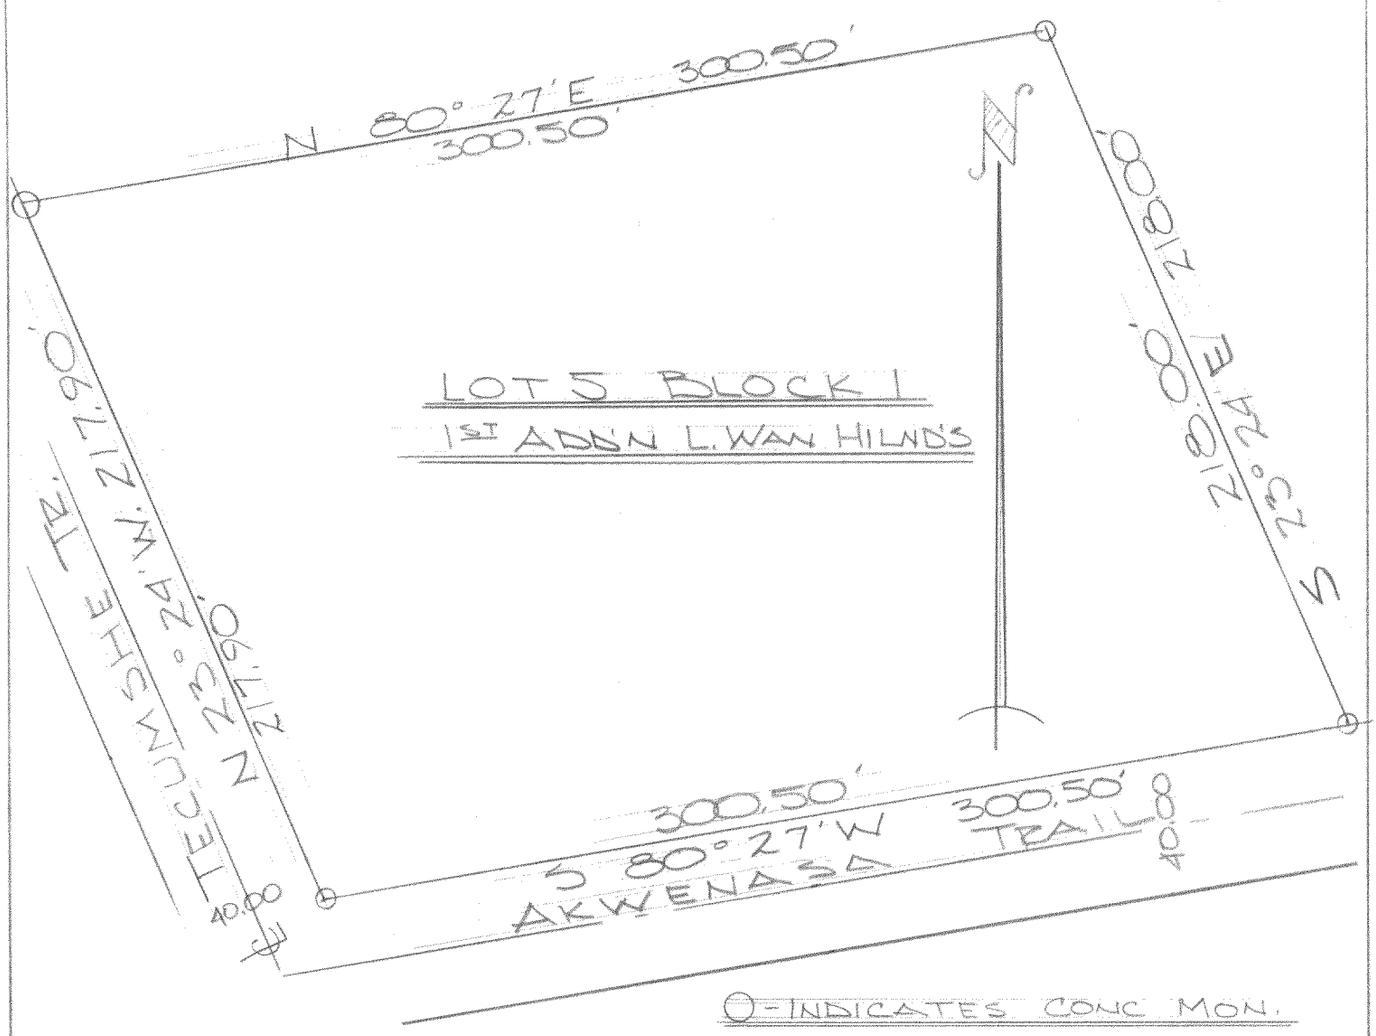

DESCRIPTION:

Lot 5, Block 1; Lake Wandawega Highlands, First Addition, a subdivision of a portion ofthe N.E.¼ of Section 11, Town 3 north, Range 16 east, Sugar Creek, Walworth County, Wisconsin.

Certificate:

I, James F. Biagi, surveyor, do hereby certify that I have surveyed the property hereon described

Signed:
August 15th 1967.

WISCONSIN
JAMES F.
BIAGI
MILWAUKEE,
WIS.
LAND SURVEYOR

James F. Biagi.

James F. Biagi. RLS 272
Elkhorn, Wisconsin.

GWHA-91

316-72B