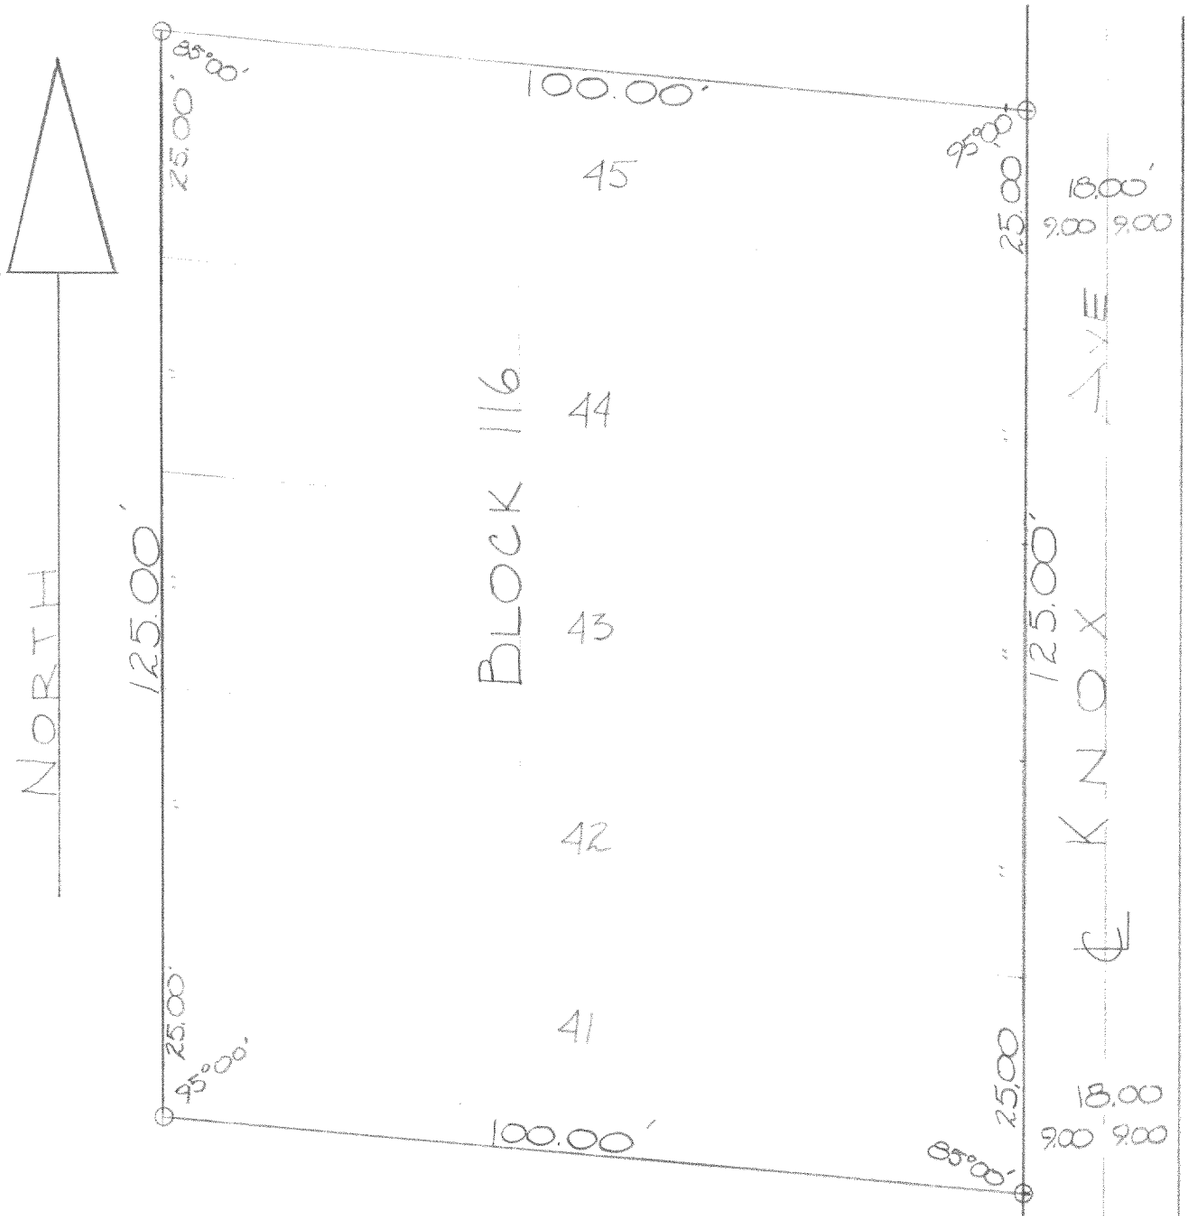


DESCRIPTION:

Lots 41, 42, 43, 44, 45, Block 116, Lake Wandawega Subdivision of a portion of Section 1, Township 3 north, Range 16 east of the 4th Principal Meridian, Sugar Creek Township, Walworth County Wisconsin.

CERTIFICATE:

I, James F. Biagi, Surveyor, do hereby certify that I have on this the 20th day of June 1962. surveyed the above described property.

SIGNED AND SEALED ON THIS THE 21st DAY OF JUNE, 1962.

James F. Biagi

James F. Biagi. R.L.S. 272
Elkhorn, Wisconsin.

WISCONSIN
JAMES F. BIAGI
MILWAUKEE, WIS.
LAND SURVEYOR

6LO 346

314-755