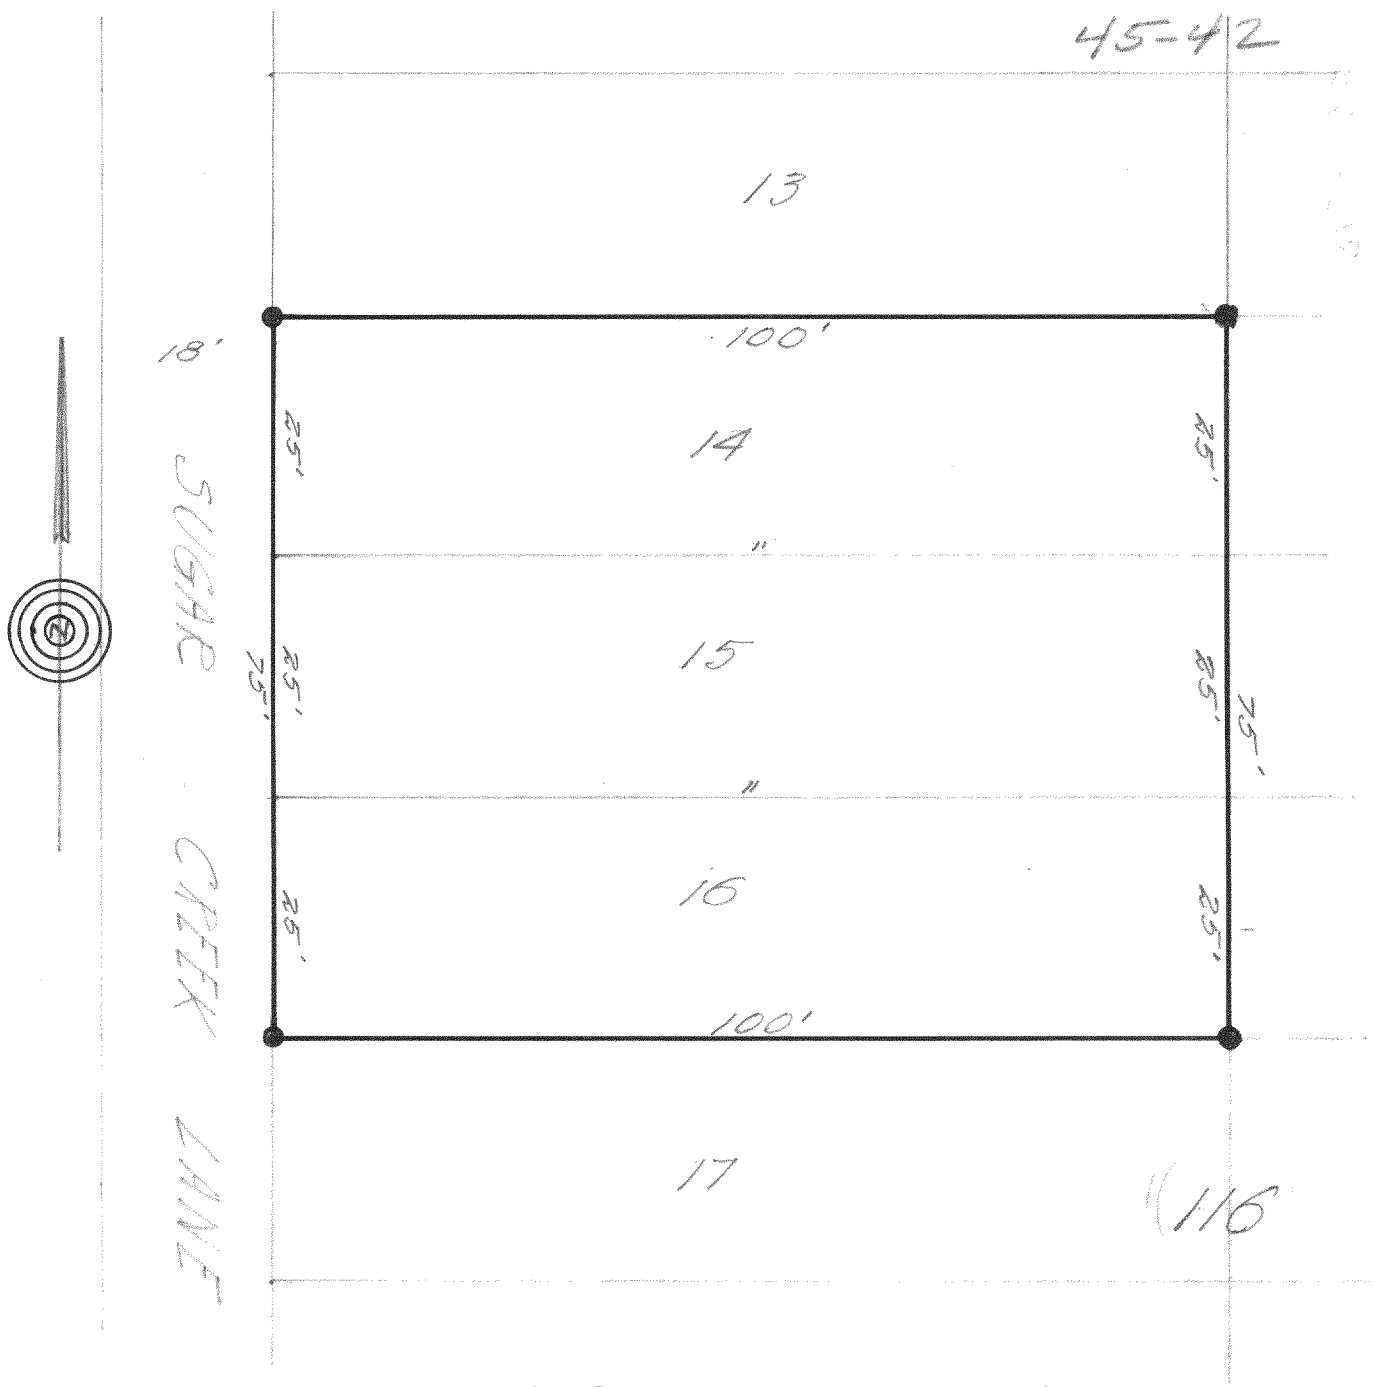


DESCRIPTION: Lots 14, 15, and 16, Lake Wandawega Subdivision of Sections 1 and 2, Town 3 north Range16 east of the 4th P. M.
CERTIFICATE: I hereby certify that I have on this the30th day of June 1945 surveyed the above described property according to the official records on file in the office of the Recorder of Deeds in and for Walworth County Wisconsin and find that no encroachments exist and thet the plat hereon portrayed is an exact reproduction of the conditions found at the site on this day.
SIGNED AND SEALED THIS 31st DAY OF JUNE 1945.

Joseph M. Biagi Professional Engine er.
Elkhorn Wisconsin.

GLW 342

316-77B