
#28-73

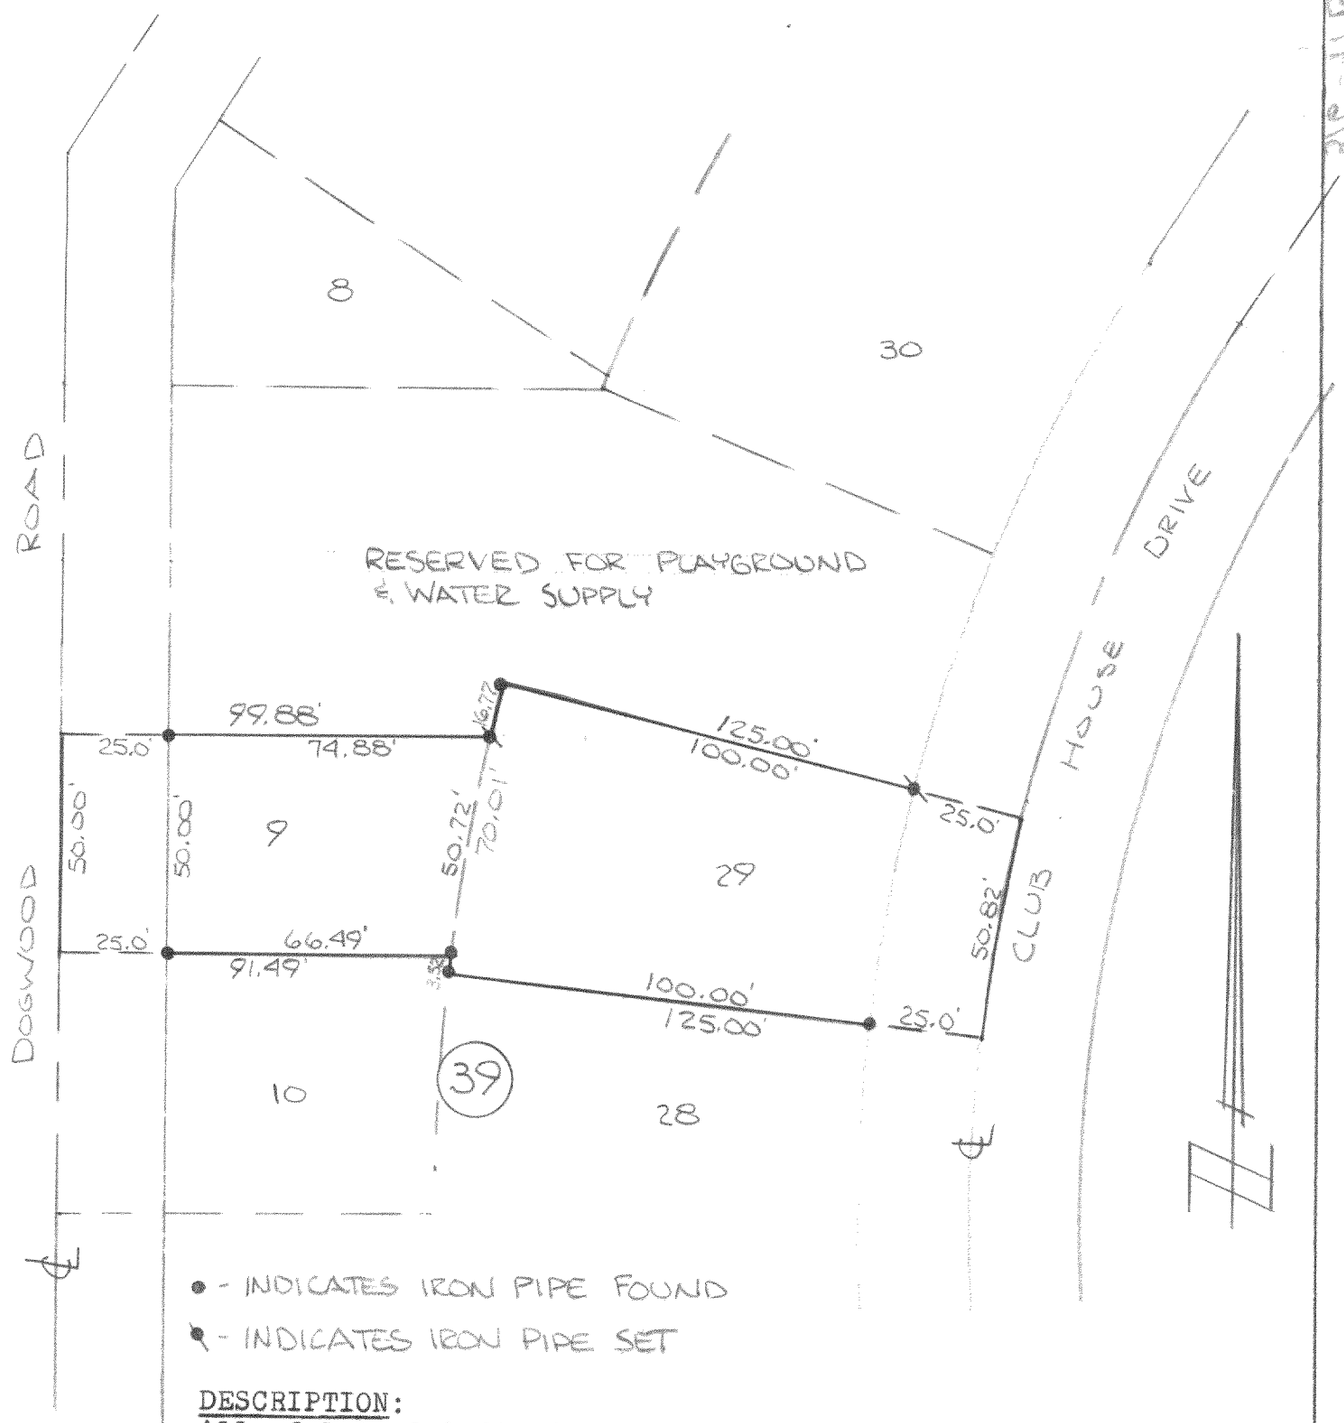

● - INDICATES IRON PIPE FOUND

✎ - INDICATES IRON PIPE SET

DESCRIPTION:
All of lots 9 & 29 of block 39 of Interlaken a subdivision located in Section 11, T3N, R16E, Walworth County, Wisconsin.

CERTIFICATE:
I, Joseph M. Biagi, surveyor, do hereby certify that I have surveyed the lands hereon described.

DATE:
April 19, 1973

Joseph M. Biagi
Joseph M. Biagi RLS #12
Elkhorn, Wisconsin

G1-341 B. 349

316-91B