
FARRIS, HANSEN & ASSOCIATES, INC.

ENGINEERING, ARCHITECTURE, SURVEYING
7 RIDGEWAY COURT – P.O. BOX 437, ELKHORN, WISCONSIN, 53121
PHONE: (414) 723–2098 FAX: (414) 723–5886

PLAT OF SURVEY

THE NW'LY 1/2 OF LOT 4
LOTS 5, 6, 7, 8
THE SE'LY 1/2 OF LOT 9
OF BLOCK 50 OF THE FOURTH
MAP OF INTERLAKEN

TOWN 3 NORTH, RANGE 16 EAST
WALWORTH COUNTY, WISCONSIN

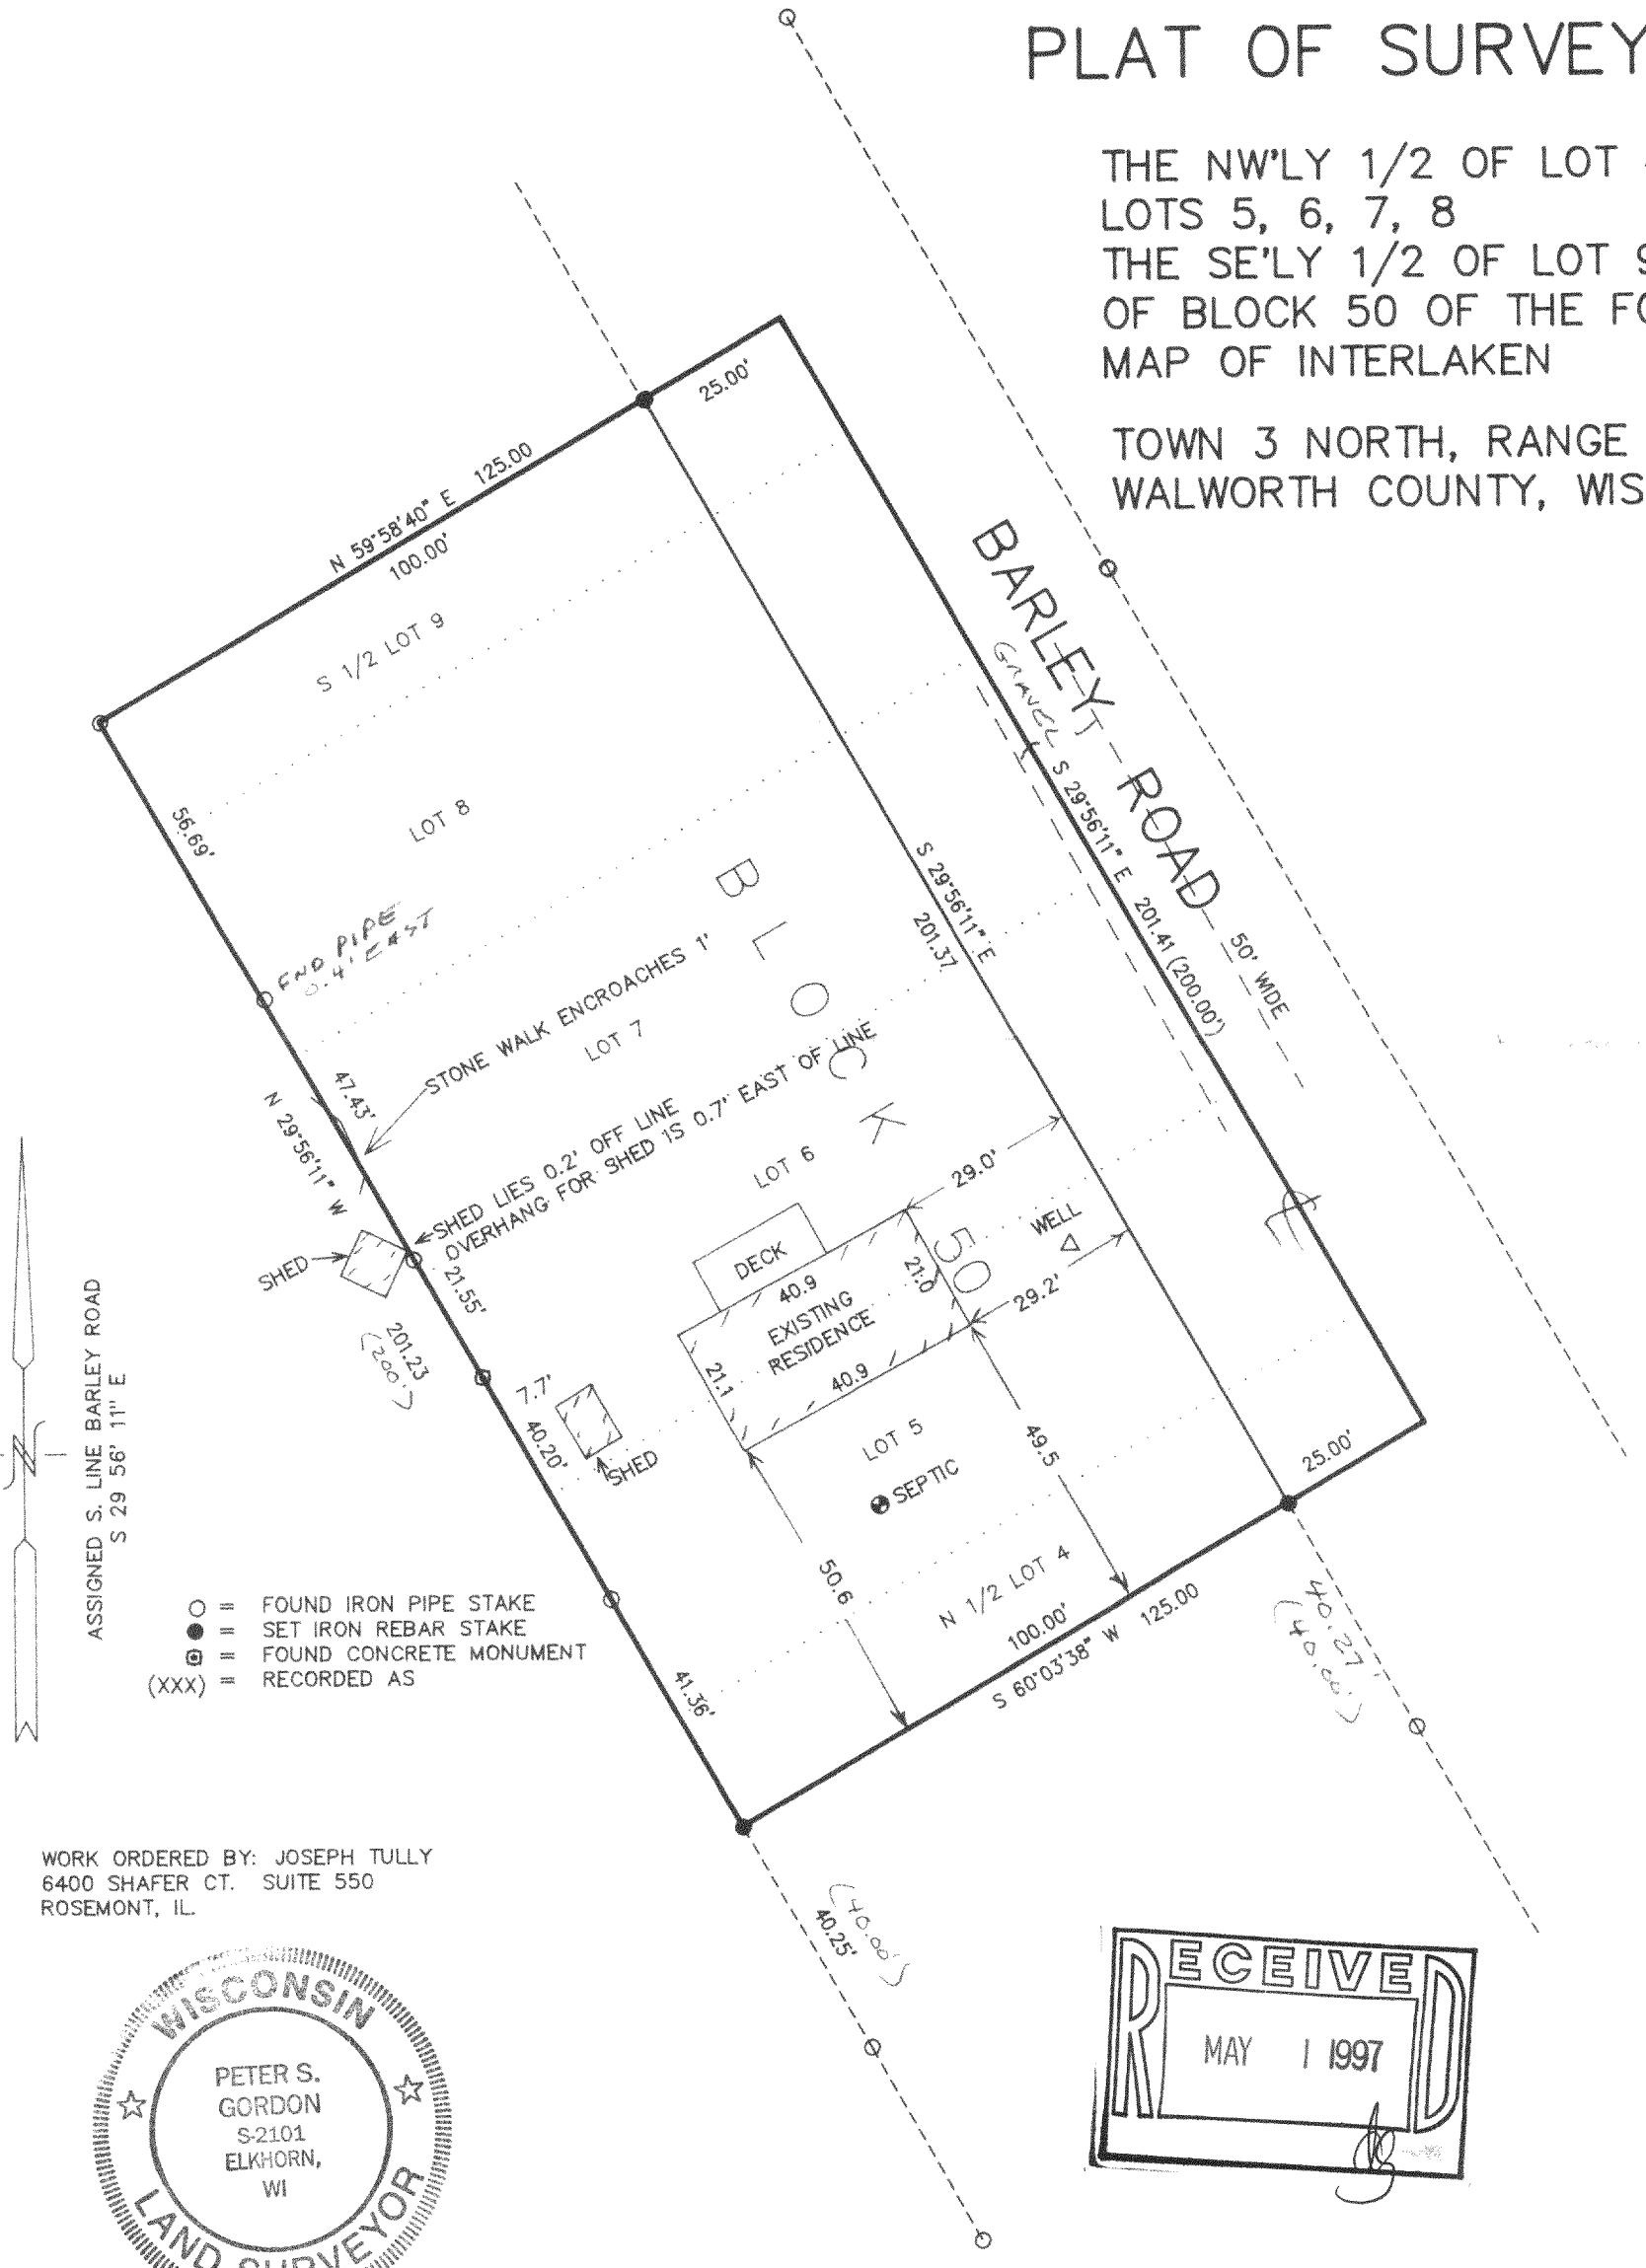

WORK ORDERED BY: JOSEPH TULLY
6400 SHAFER CT. SUITE 550
ROSEMONT, IL.

WISCONSIN
PETER S. GORDON
S-2101
ELKHORN, WI
LAND SURVEYOR

RECEIVED
MAY 1 1997

NOTE: COPIES OF THIS MAP TO WHICH THE FOLLOWING CERTIFICATE WILL APPLY ARE BLUE LINE PRINTS SHOWING SURVEYOR'S ORIGINAL SEAL AND SIGNATURE IN BLACK INK. COPIES BY ANY OTHER MEANS MAY HAVE ALTERATIONS WHICH DO NOT REPRESENT THE SURVEYOR'S WORK PRODUCT.

I HEREBY CERTIFY THAT THE ABOVE DESCRIBED PROPERTY HAS BEEN SURVEYED UNDER MY DIRECTION AND THAT THE ABOVE MAP IS A TRUE REPRESENTATION THEREOF AND SHOWS THE SIZE AND LOCATION OF THE PROPERTY AND ITS EXTERIOR BOUNDARIES. THIS SURVEY IS MADE FOR THE USE OF THE PRESENT OWNERS OF THE PROPERTY, AND ALSO THOSE WHO PURCHASE, MORTGAGE, OR GUARANTEE THE TITLE THERETO WITHIN ONE YEAR FROM THE DATE HEREOF.

DATED: 4-15-97

GI-452
GI-454
GI-455

PETER S. GORDON R.L.S. 2101

PROJECT 4738

SHEET 1 OF 1

316-930