
ABELL
SURVEYING & MAPPING

1140 SEQUOIA STREET • DELAVAN, WISCONSIN 53115
414-728-6737

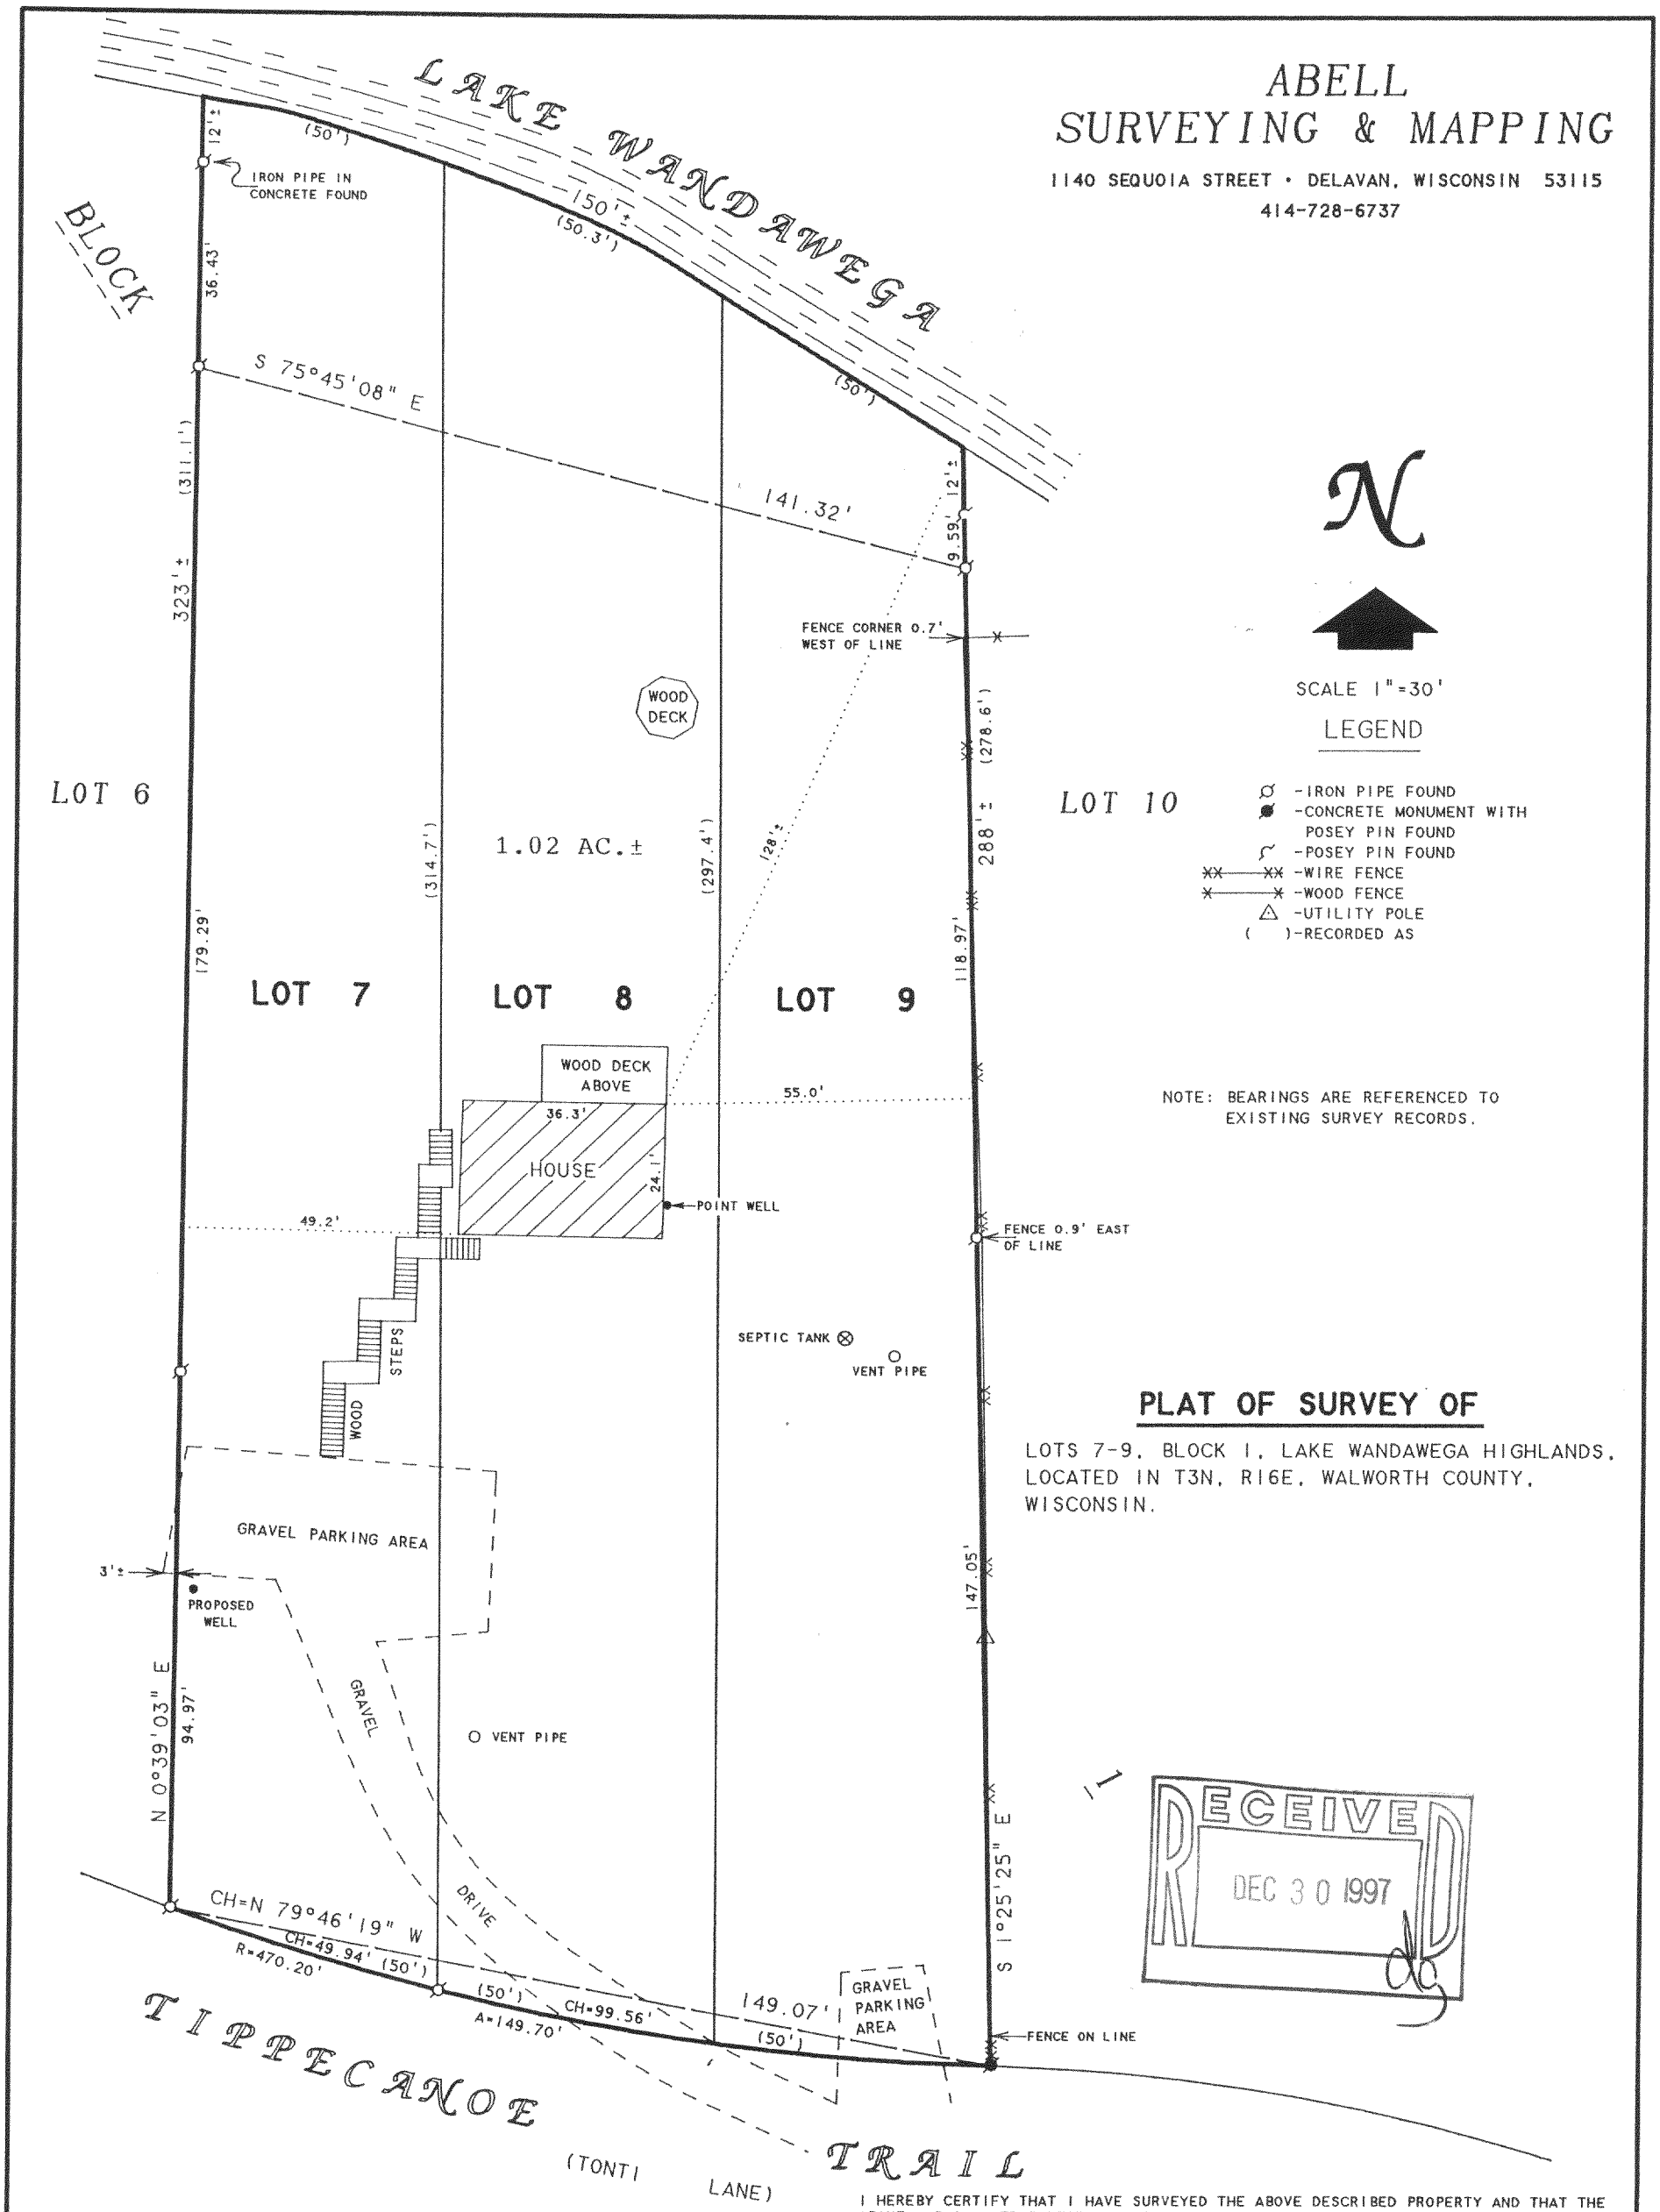

N

SCALE 1"=30'

LEGEND

- ø -IRON PIPE FOUND
- ● -CONCRETE MONUMENT WITH POSEY PIN FOUND
- ⌐ -POSEY PIN FOUND
- XX——XX -WIRE FENCE
- X——X -WOOD FENCE
- △ -UTILITY POLE
- ( )-RECORDED AS

NOTE: BEARINGS ARE REFERENCED TO EXISTING SURVEY RECORDS.

PLAT OF SURVEY OF

LOTS 7-9, BLOCK 1, LAKE WANDAWEGA HIGHLANDS, LOCATED IN T3N, R16E, WALWORTH COUNTY, WISCONSIN.

RECEIVED
DEC 30 1997

ORDERED BY: RE/MAX - HEARTLAND REALTY
239 E. MILWAUKEE STREET
WHITEWATER, WI 53190

I HEREBY CERTIFY THAT I HAVE SURVEYED THE ABOVE DESCRIBED PROPERTY AND THAT THE ABOVE MAP IS A TRUE REPRESENTATION THEREOF AND SHOWS THE SIZE AND LOCATION OF THE PROPERTY, ITS EXTERIOR BOUNDARIES, THE LOCATION OF ALL VISIBLE STRUCTURES AND DIMENSIONS OF ALL PRINCIPAL BUILDINGS THEREON, BOUNDARY FENCES, APPARENT EASEMENTS, ROADWAYS AND VISIBLE ENCROACHMENTS, IF ANY, TO THE BEST OF MY KNOWLEDGE AND BELIEF.

THIS SURVEY IS MADE FOR THE USE OF THE PRESENT OWNERS OF THE PROPERTY, AND ALSO THOSE WHO PURCHASE, MORTGAGE, OR GUARANTEE THE TITLE THERETO WITHIN ONE (1) YEAR FROM DATE HEREON.

David F. Abell

DAVID F. ABELL
WISCONSIN REGISTERED LAND SURVEYOR, S-1596

December 10, 1997

DATE JOB NUMBER - 97222

NOTE: THIS IS NOT A CERTIFIED COPY UNLESS SEALED.

GWH-3
GWH-4

316-963