
LOCATION OF NEW RESIDENCE ON CSM NO. 1412

LOCATED IN NE ¼ OF SE ¼ OF SEC 8, T. 3N, R. 17E.
WALWORTH COUNTY, WISCONSIN

RECEIVED
OCT 30 1985

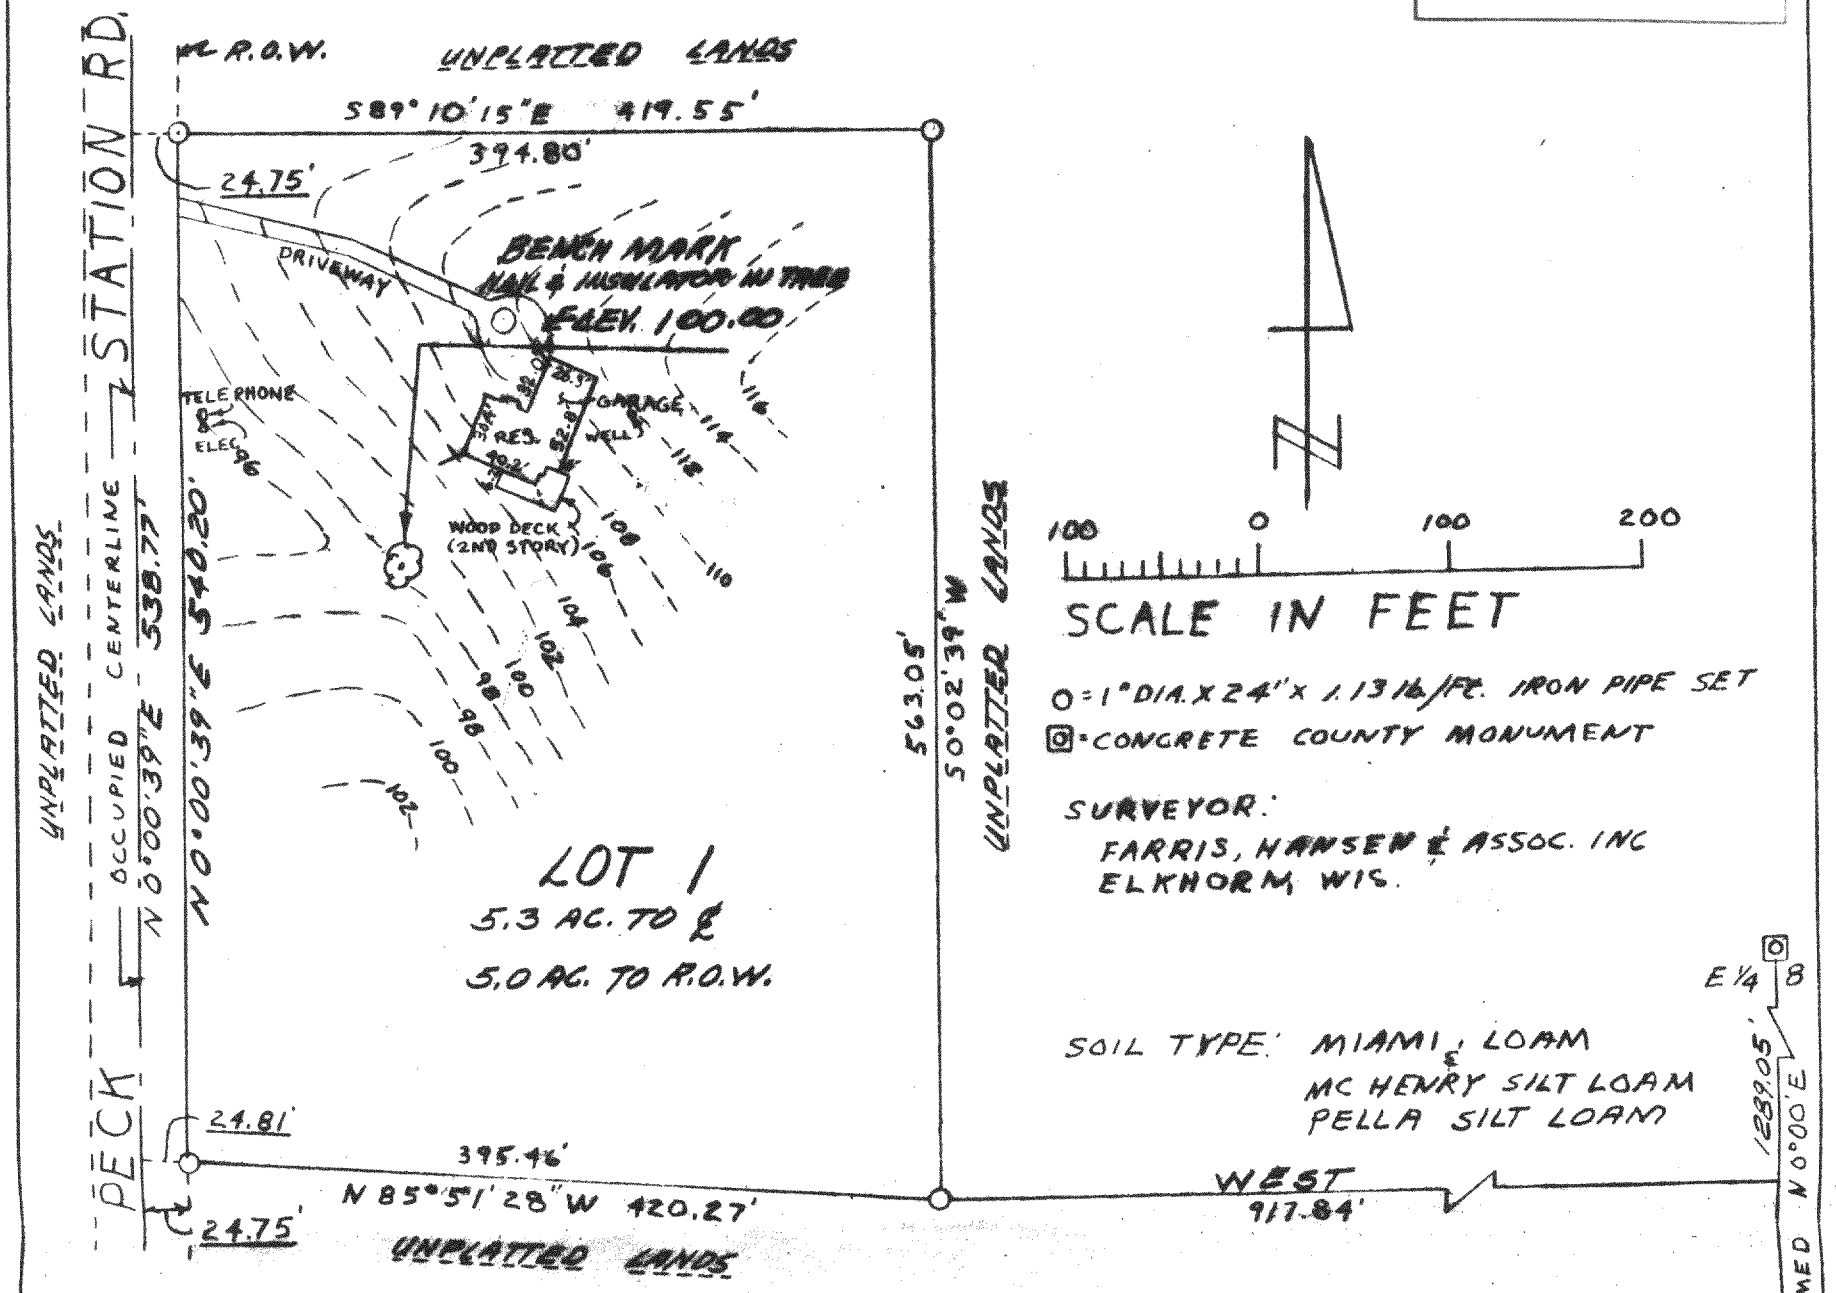

○ = 1" DIA. X 24" x 1.13 lb/ft. IRON PIPE SET
◎ = CONCRETE COUNTY MONUMENT

SURVEYOR:
FARRIS, HANSEN & ASSOC. INC
ELKHORN, WIS.

SOIL TYPE: MIAMI & LOAM
MC HENRY SILT LOAM
PELLA SILT LOAM

I HEREBY CERTIFY THAT THIS MAP IS A TRUE AND ACCURATE REPRESENTATION OF THE LOCATION OF A NEW RESIDENCE ON CERTIFIED SURVEY MAP NO. 1412, DESCRIBED AS FOLLOWS:

PART OF THE NORTHEAST 1/4 OF THE SOUTHEAST 1/4 OF SECTION 8, TOWN 3 NORTH, RANGE 17 EAST, WALWORTH COUNTY, WISCONSIN, COMMENCING AT THE SOUTHEAST CORNER OF SAID SECTION 8; THENCE NORTH 1357.94 FEET ALONG THE EAST LINE OF SAID SECTION 8; THENCE WEST 917.84 FEET (AT RIGHT ANGLES TO THE SECTION LINE) TO THE POINT OF BEGINNING THENCE N 85 51'28" W 420.27 FEET TO THE CENTER OF PECK STATION ROAD; THENCE N 0 00'39" E 538.77 FEET ALONG THE CENTER OF SAID ROAD; THENCE S 89 10'15" E 419.55 FEET; THENCE S 0 02' 39" W 563.05 FEET TO THE POINT OF BEGINNING, CONTAINING 5.30 ACRES OF LAND MORE OR LESS.

Robert A. Farris

ROBERT A FARRIS RLS

DATED 10/14/85

WISCONSIN
ROBERT A FARRIS
S-1412
LAND SURVEYOR

PROJECT # 2343W-1

317-120

KA-1413-1