
PLAT OF SURVEY

OF

Lot 4 in ALPINE TOWER ESTATES, being a subdivision located in part of the Northeast 1/4 of Section 13, Town 3 North, Range 17 East of the Fourth Principal Meridian, Town of Lafayette, Walworth County, Wisconsin.

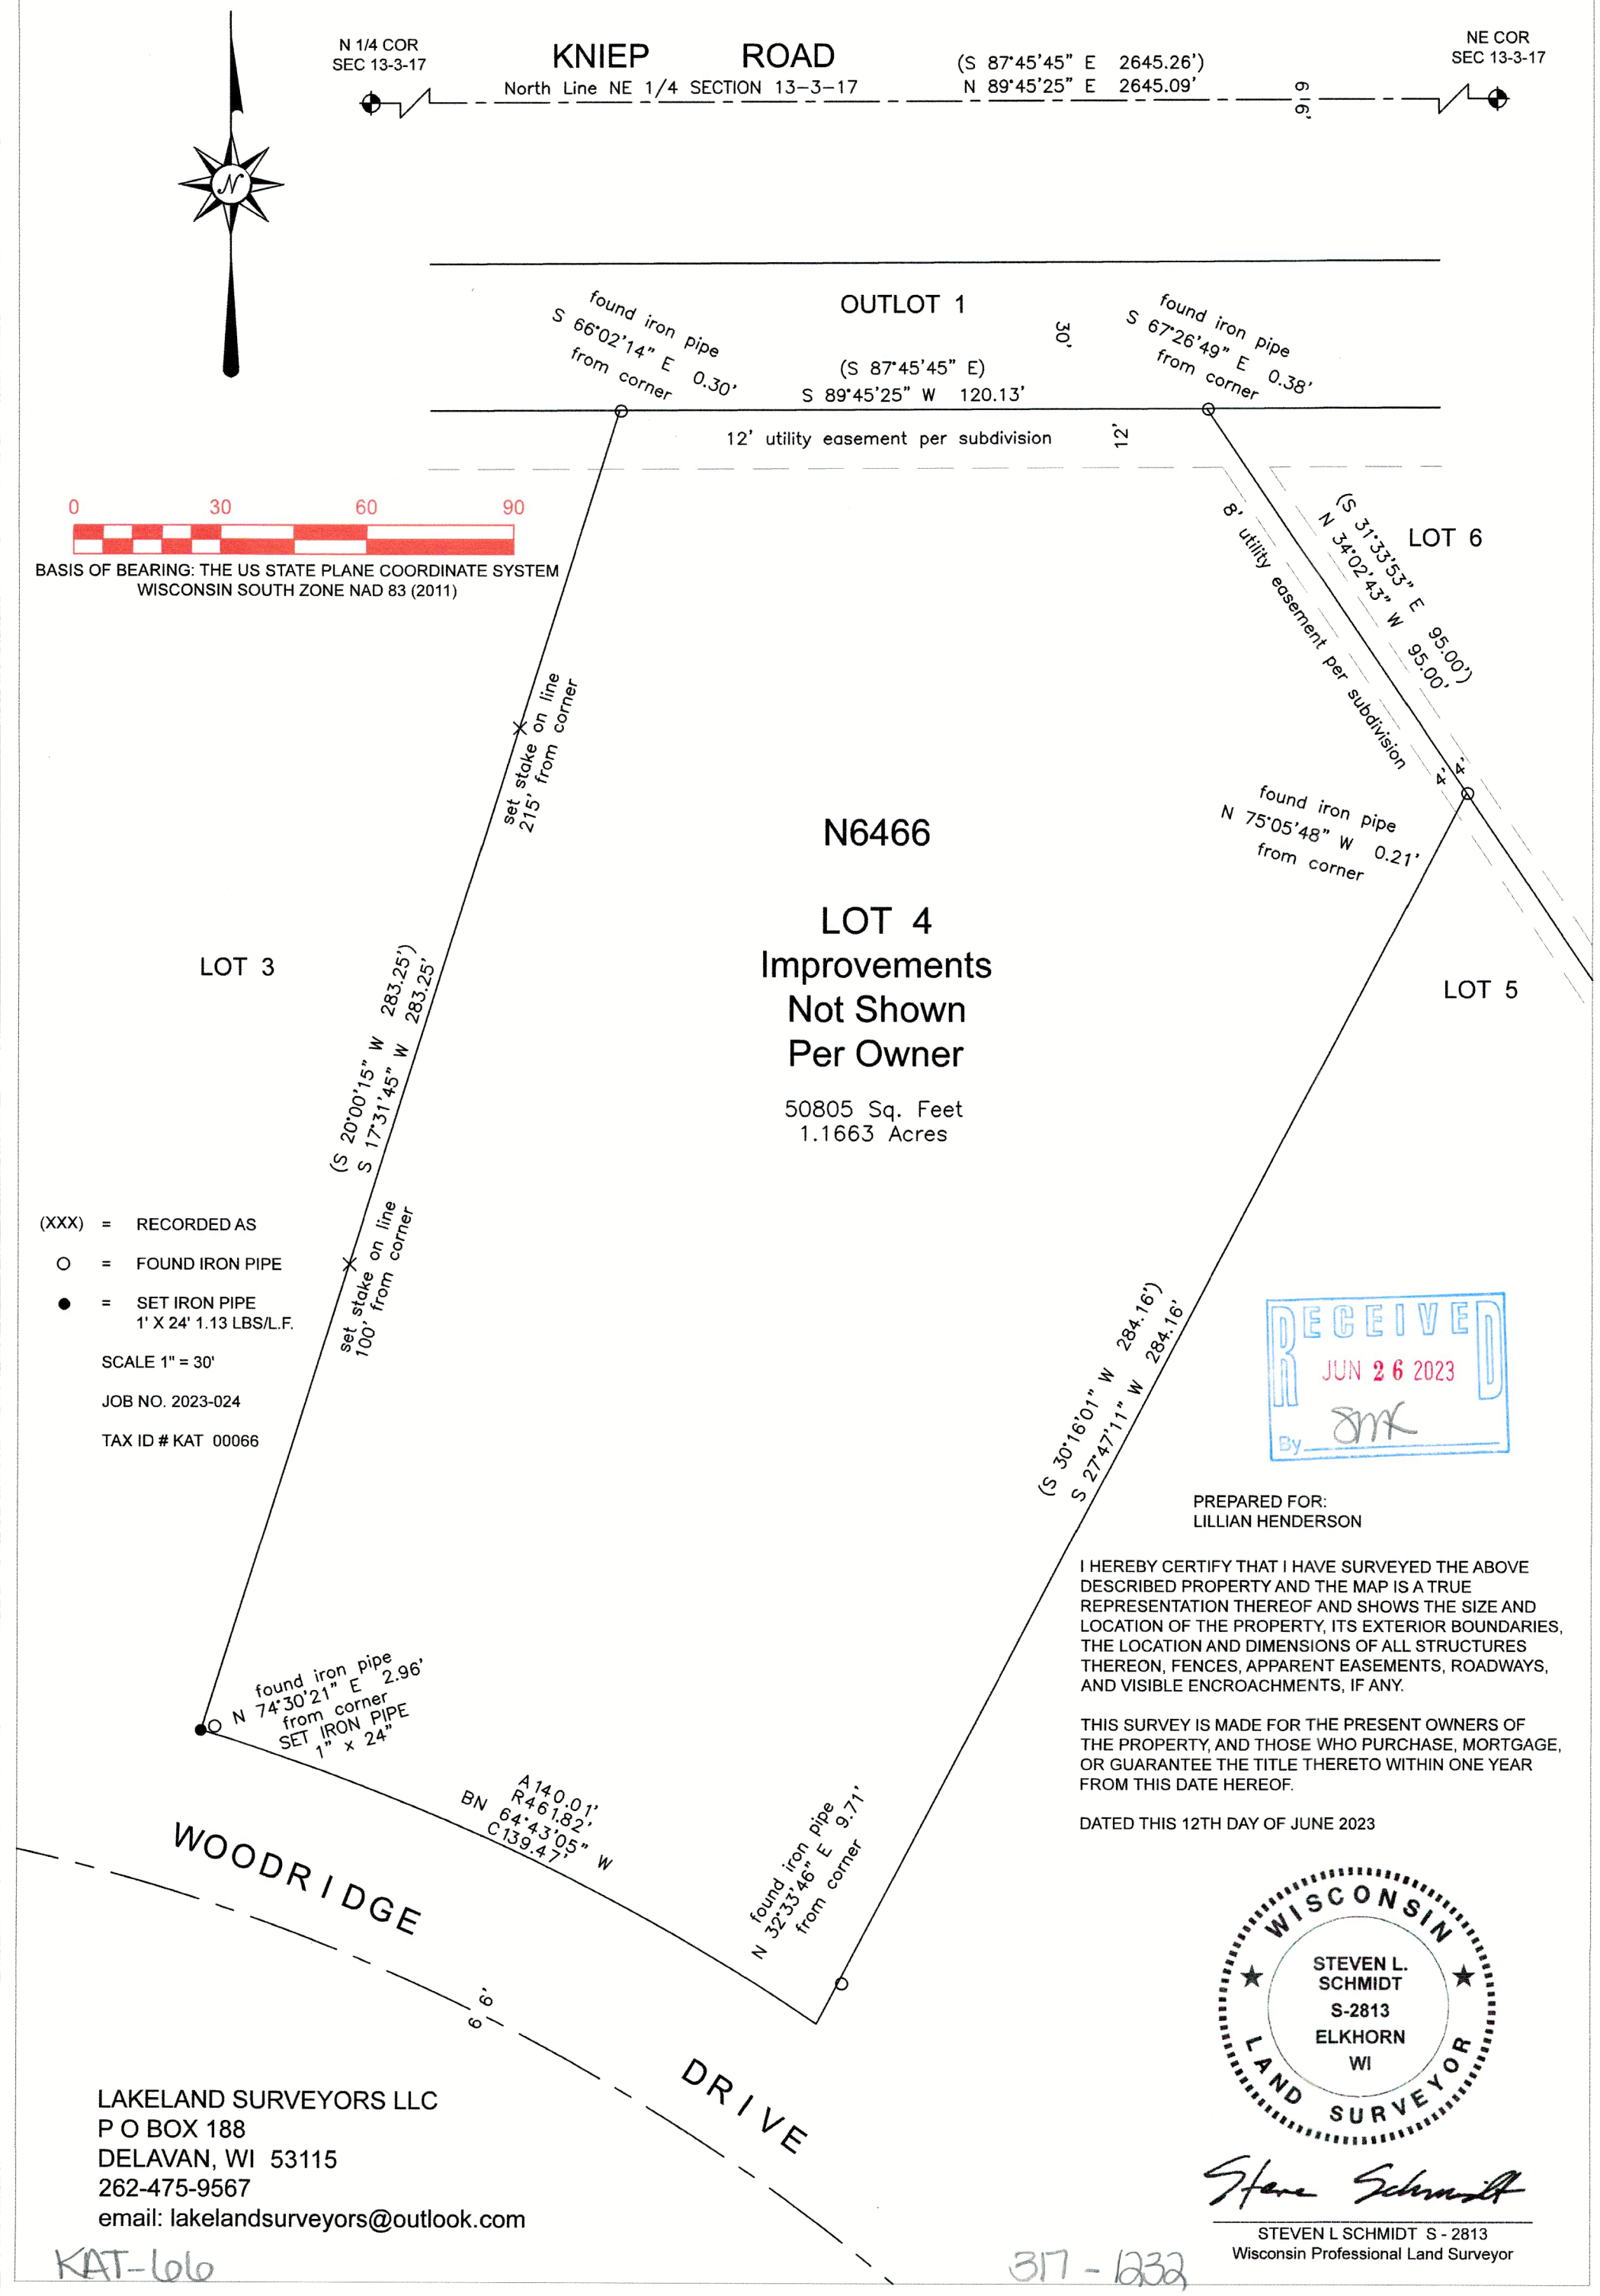

(XXX) = RECORDED AS

O = FOUND IRON PIPE

● = SET IRON PIPE 1' X 24' 1.13 LBS/L.F.

SCALE 1" = 30'

JOB NO. 2023-024

TAX ID # KAT 00066

RECEIVED
JUN 26 2023
By

PREPARED FOR:
LILLIAN HENDERSON

I HEREBY CERTIFY THAT I HAVE SURVEYED THE ABOVE DESCRIBED PROPERTY AND THE MAP IS A TRUE REPRESENTATION THEREOF AND SHOWS THE SIZE AND LOCATION OF THE PROPERTY, ITS EXTERIOR BOUNDARIES, THE LOCATION AND DIMENSIONS OF ALL STRUCTURES THEREON, FENCES, APPARENT EASEMENTS, ROADWAYS, AND VISIBLE ENCROACHMENTS, IF ANY.

THIS SURVEY IS MADE FOR THE PRESENT OWNERS OF THE PROPERTY, AND THOSE WHO PURCHASE, MORTGAGE, OR GUARANTEE THE TITLE THERETO WITHIN ONE YEAR FROM THIS DATE HEREOF.

DATED THIS 12TH DAY OF JUNE 2023

WISCONSIN
STEVEN L. SCHMIDT
S-2813
ELKHORN
WI
LAND SURVEYOR

STEVEN L SCHMIDT S - 2813
Wisconsin Professional Land Surveyor

LAKELAND SURVEYORS LLC
P O BOX 188
DELAVAN, WI 53115
262-475-9567
email: lakelandsurveyors@outlook.com

KAT-66

317 - 1232