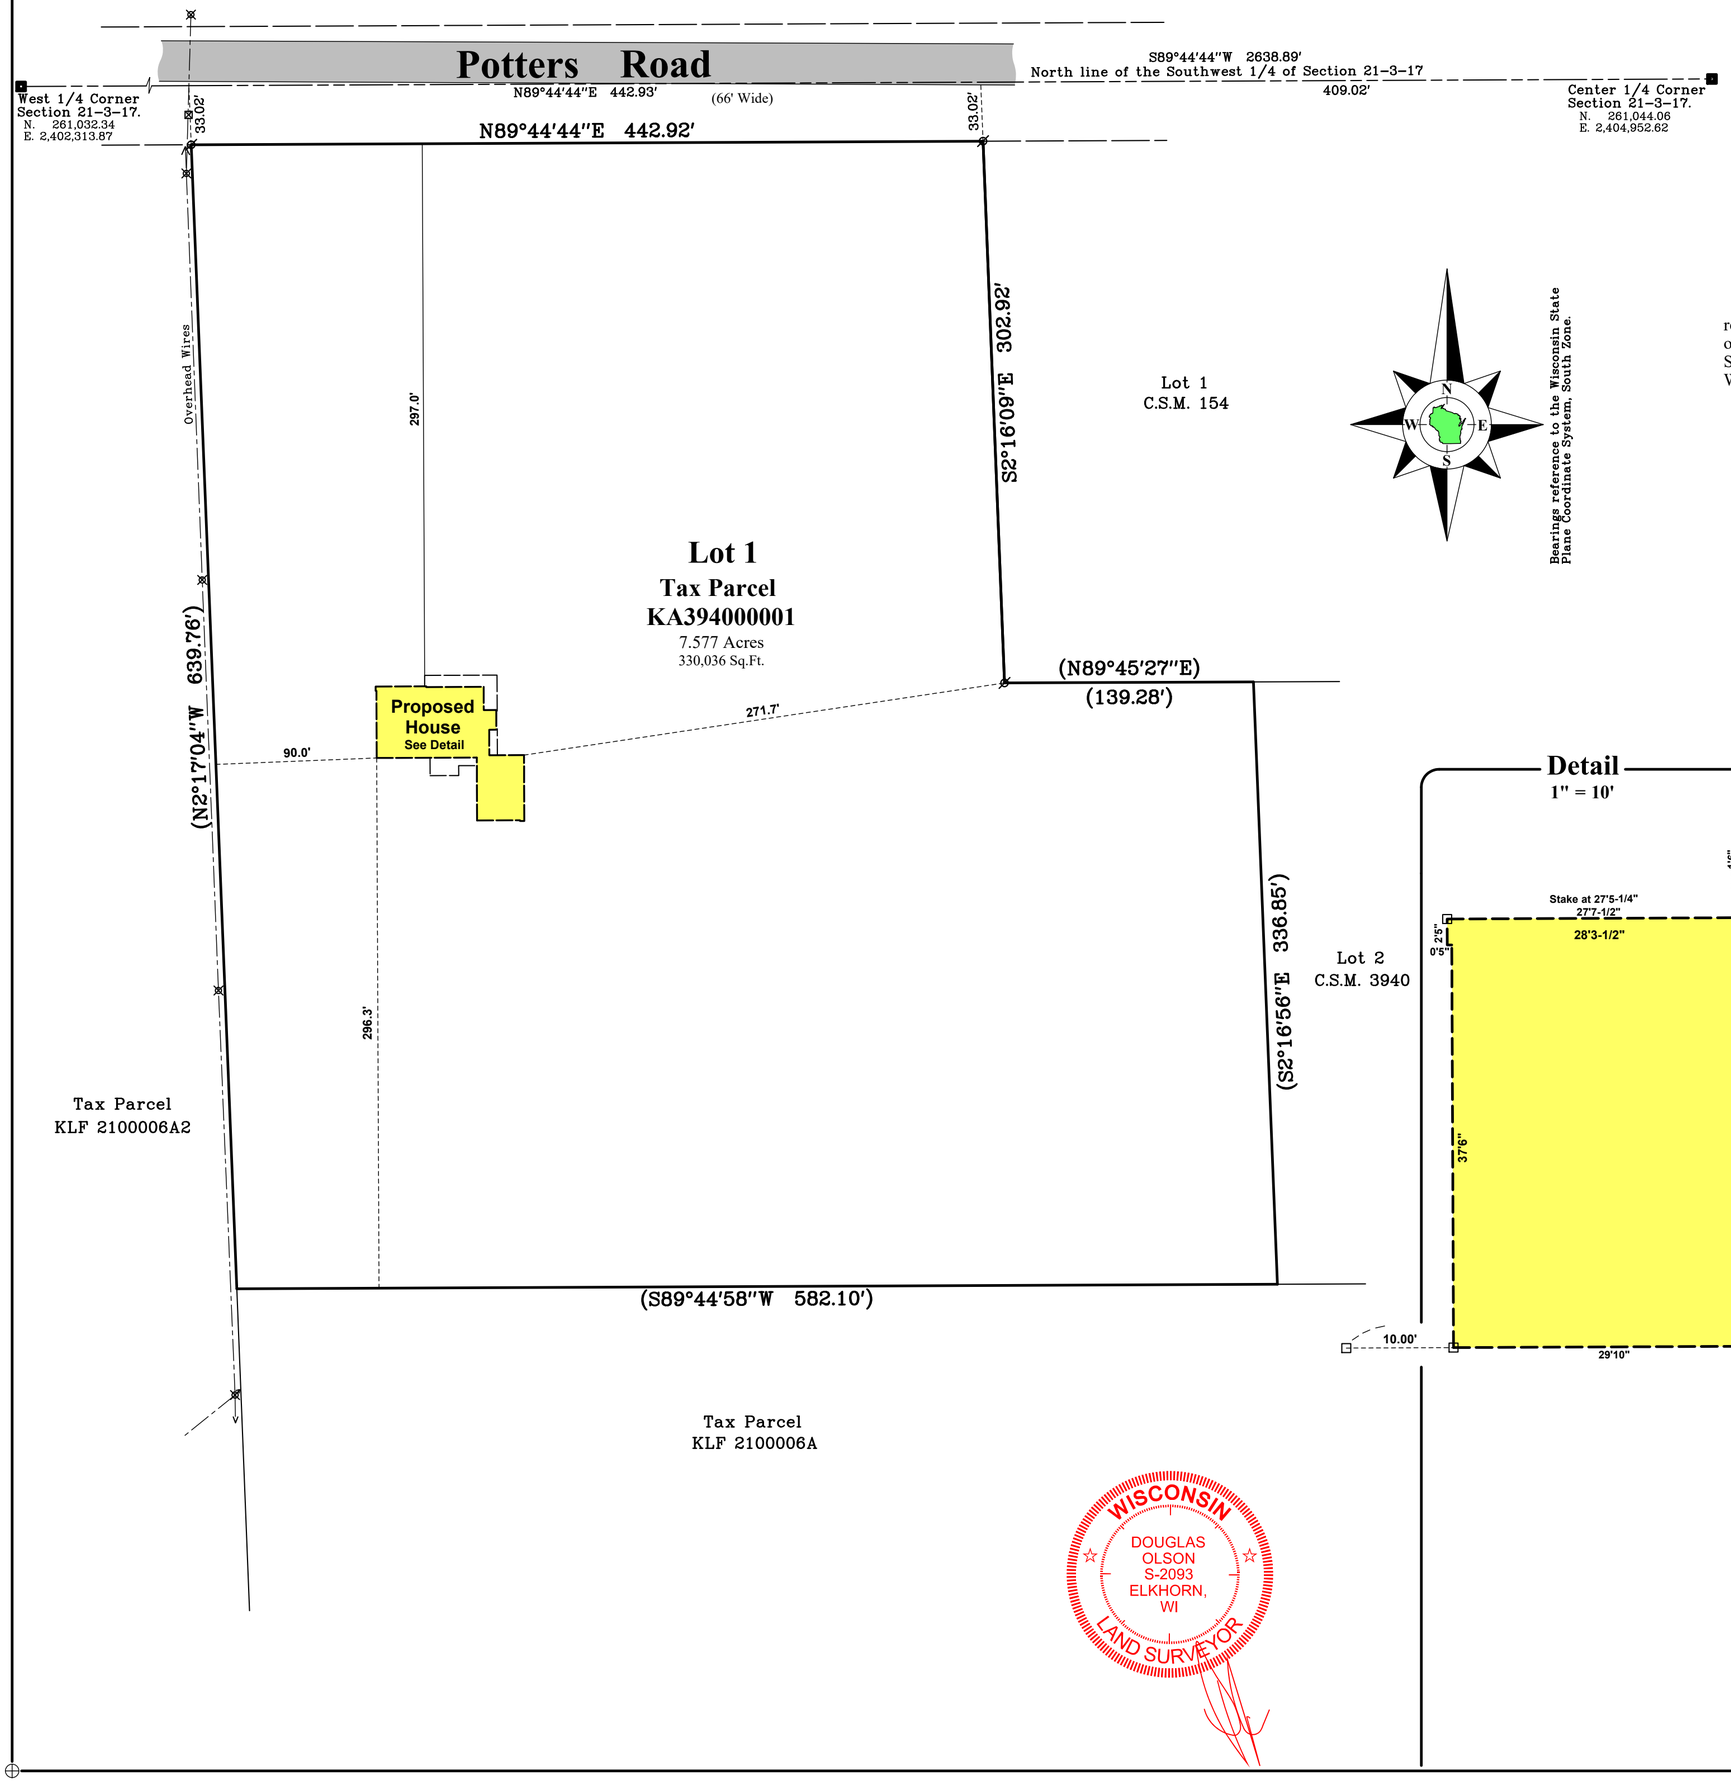


Property Exhibit

of


Lot 1 of Certified Survey Map No. 3940,

recorded May 26, 2006 in Vol. 24 of Certified Survey Maps of Walworth County on Page 124 as Document Number 677562 and located in the Northeast 1/4 of the Southwest 1/4 of Section 21, Town 3 North, Range 17 East, Town of LaFayette, Walworth County, Wisconsin.

Prepared for:

Kerkman Bros. Construction Co., Inc.
P.O. Box 923
New Munster, Wisconsin. 53152

Detail
1" = 10'

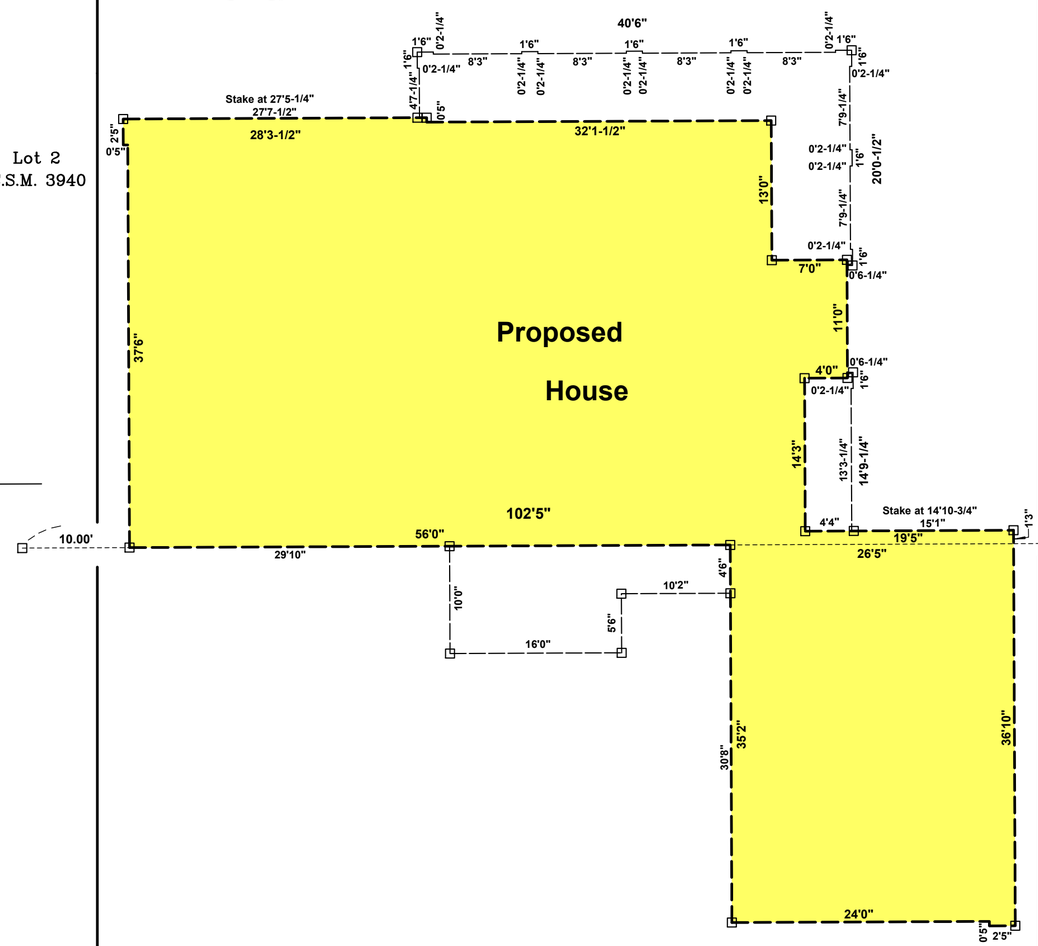

Survey Date: May 13, 2025.
Revisions: No. 1 – Set 2 Offset Stakes

Scale in Feet
1" = 60'
0' 30' 60' 120' 180'

45 South Wisconsin Street | P.O. Box 322
Elkhorn, Wisconsin 53121
Telephone: (262) 723-3434
Facsimile: (262) 723-8044
Email: doug@olsonsurveying.com
Website: www.olsonsurveying.com

OLSON
LAND SURVEYING, LLC
Rural | Residential | Commercial

Table of Symbols & Abbreviations
N North
S South
E East
W West
In. Bearings
° Degrees
' Minutes
" Seconds
In. Distances
Ft. Feet
" Inches

Legend
Found County Section Corner
Found Iron Pipe
Set Wood Stake
( ) Recorded Information
Utility Pole
Asphalt Surface

WISCONSIN
DOUGLAS OLSON
S-2093
ELKHORN, WI
LAND SURVEYOR

Sheet 1 of 1 Sheets
Drawing Name:
Job Reference Number
2025.052

2025.052