
D. D. COOPER & CO., INC.
Daniel D. Cooper
Rt. 4 Box 508B
Elkhorn, WI 53121

Plat of Survey of Lot 58 of Evergreen Estates Subdivision, T3N, R17E, Walworth County, Wisconsin

RECEIVED
APR 19 1988

Bearings referenced to the Southerly line of said lot which was assumed to bear N79 19'35"E

Survey ordered by Century-21 Elkhorn

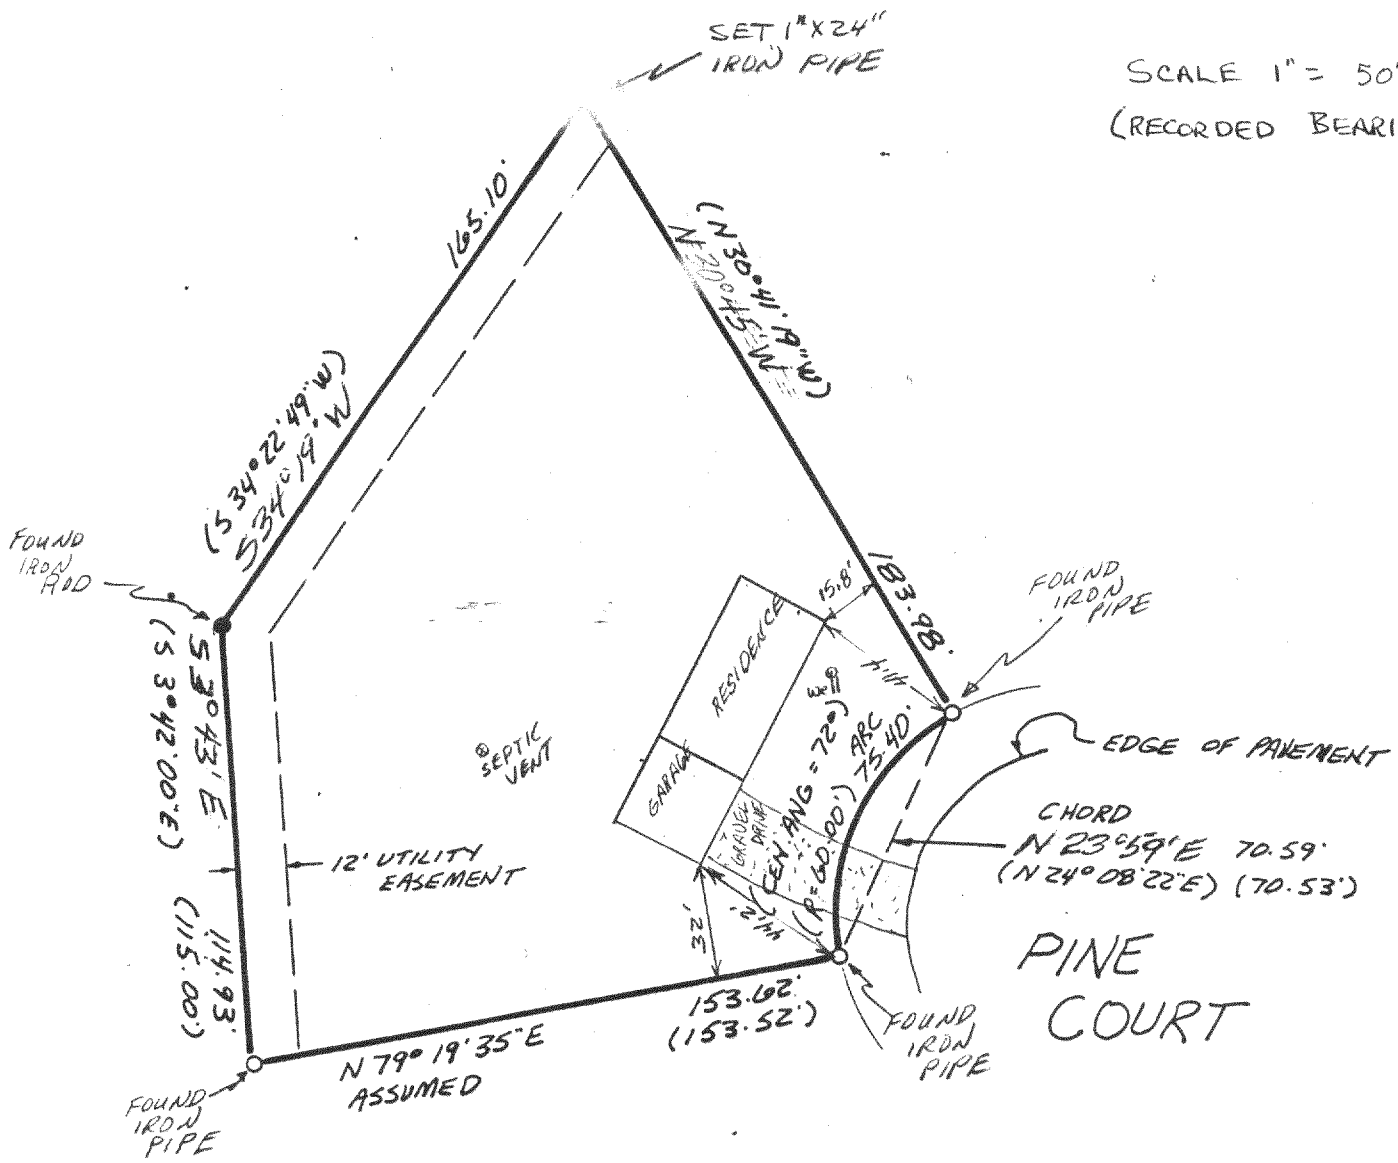

SCALE 1" = 50'
(RECORDED BEARINGS)

WISCONSIN
DANIEL D. COOPER
S-1464
WIS.
LAND SURVEYOR

I hereby certify that I have surveyed the property described hereon and that the above map is a true and accurate representation thereof to the best of my professional knowledge and belief.

Dated this 29 day of April, 1987

Daniel D. Cooper RLS No. S-1464

DRAWING NO 3090-S

317-153