RECEIVED
MAY 19 [redacted]

FARRIS, HANSEN & ASSOCIATES, INC.
7 RIDGEWAY COURT ELKHORN, WI
414-723-2098

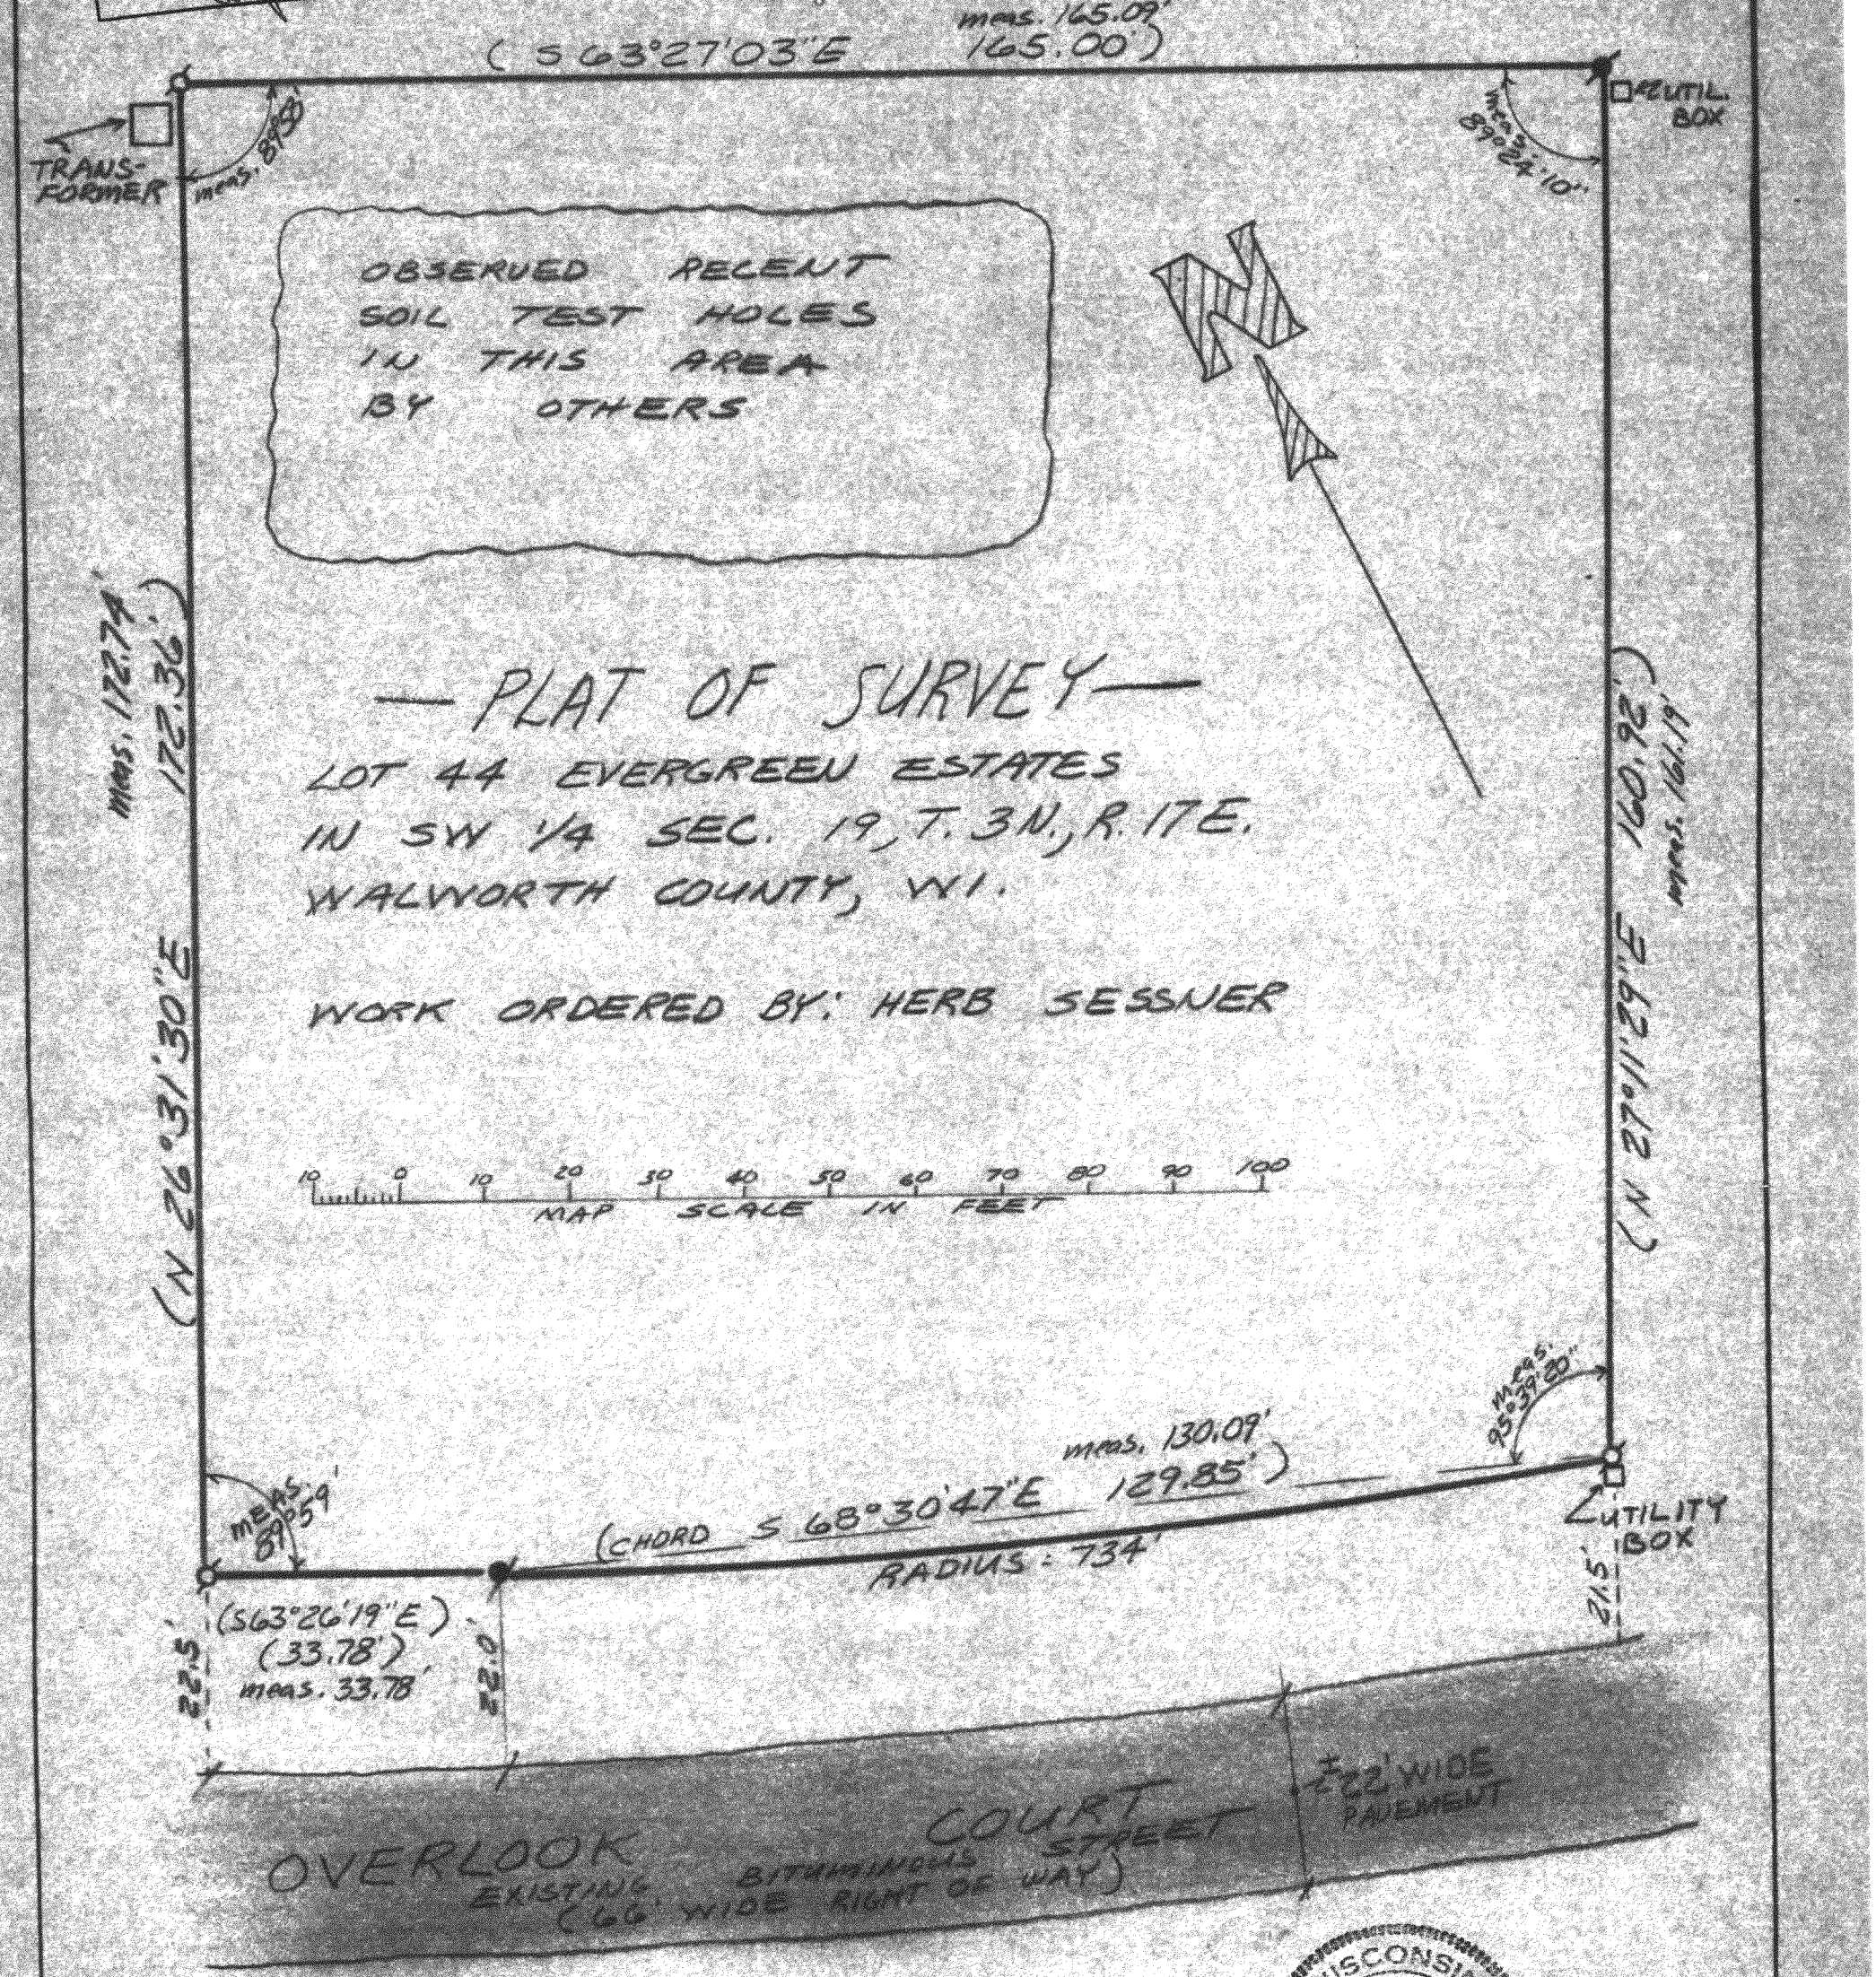

— PLAT OF SURVEY —

LOT 44 EVERGREEN ESTATES
IN SW 1/4 SEC. 19, T. 3N., R. 17E.
WALWORTH COUNTY, WI.

WORK ORDERED BY: HERB SESSNER

WISCONSIN ROBERT A. FARRIS S-2295 ELKHORN WIS. LAND SURVEYOR

LEGEND

Ø = Iron Pipe Survey Stake Found
● = Iron Rod Survey Stake Found
(XXX)= Record Dimension

CERTIFICATE

I hereby certify that the above described property has been surveyed under my direction and that the above map is a true representation thereof and shows the size and location of the property, its exterior boundaries, the location of all visible structures and dimensions of all principal buildings thereon, boundary fences, apparent easements, roadways and visible encroachments, if any.
This survey is made for the use of the present owners of the property, and also for those who purchase, mortgage, or guarantee the title thereto within one (1) year from the date hereof.

Robert A. Farris, R.L.S.

Dated this 15 day of APR., 1988

PROJECT NO. 2988

317-156