
DUNHAM SURVEYING, S. C.

SURVEYING & SUBDIVIDING
DELAVAN, WISCONSIN 53115

S12-916

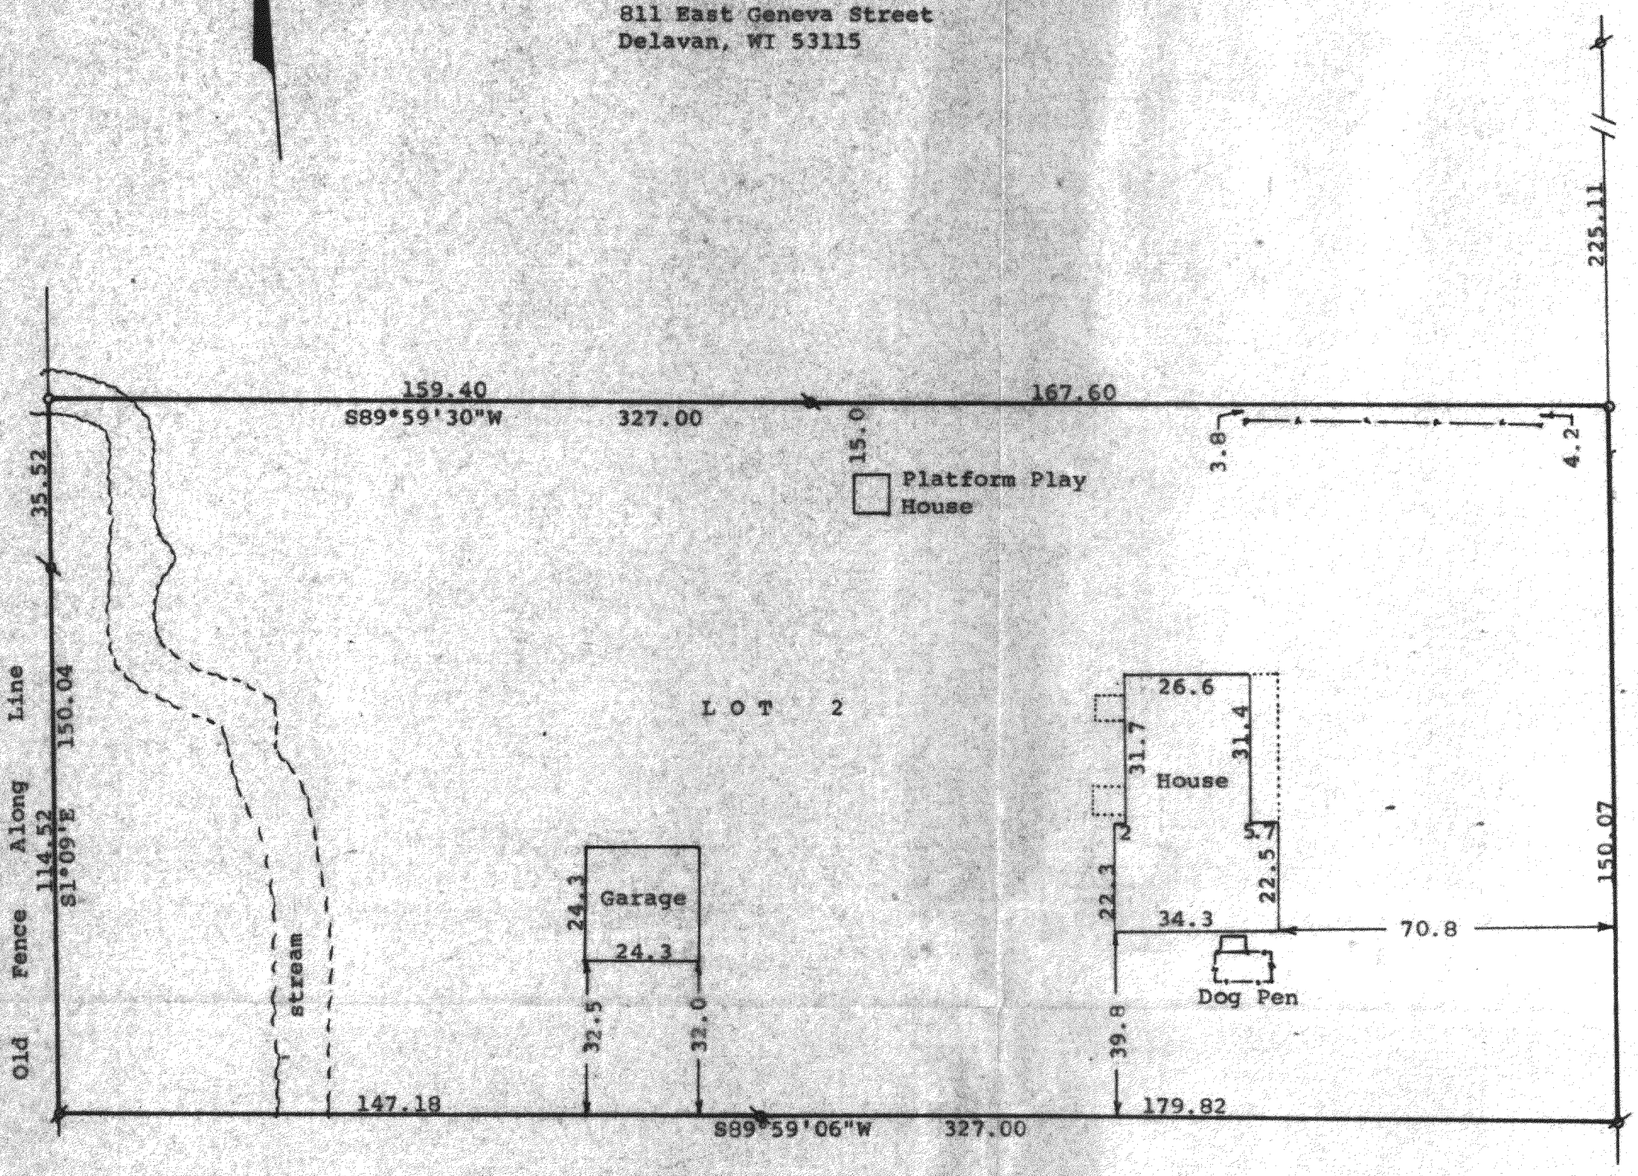

Scale - 1" = 30'
= 1" Iron Pipe Found
o= 1½" X 24" Iron Pipe Set
= ½" X 24" Iron Pipe Set
-·—·-·— = Decorative Fence
Bearings referenced to the previously recorded bearing of S1°09'E along the west line of Oak Creek Drive
Survey ordered by: Realty World, Carmin Realtors
811 East Geneva Street
Delavan, WI 53115



STATE OF WISCONSIN) SS
COUNTY OF WALWORTH)

I, George T. Dunham, Surveyor, certify that I have surveyed the property described as follows:

Lot 2 of Certified Survey No. 112 recorded in Volume No. 1 of Certified Surveys on Page 112, in the Office of the Register of Deeds, Walworth County, Wisconsin, and being a parcel of land located in the Northeast ¼ of the Southwest ¼ of Section 19, T 3 N, R 17 E, Walworth County, Wisconsin,

and that the plat shown hereon is a correct representation thereof and shows the size and location of the property, its exterior boundaries, the location of all visible structures and dimensions of all principal buildings thereon, boundary fences, apparent easements, roadways and visible encroachments, if any, and that I have surveyed the property hereon described, according to the official records, to the best of my knowledge and belief.

May 17, 1990

George T. Dunham, Surveyor

WISCONSIN LAND SURVEYOR
GEORGE T. DUNHAM
S-306
DELAVAN WIS.

RECEIVED
AUG 16 1990

Survey # 317-208

TAX KEY # KA1120002

5133439
GMB 1020