

WALWORTH COUNTY
SURVEYING & MAPPING
727 HENRY STREET
LAKE GENEVA, WISCONSIN
414-248-0505

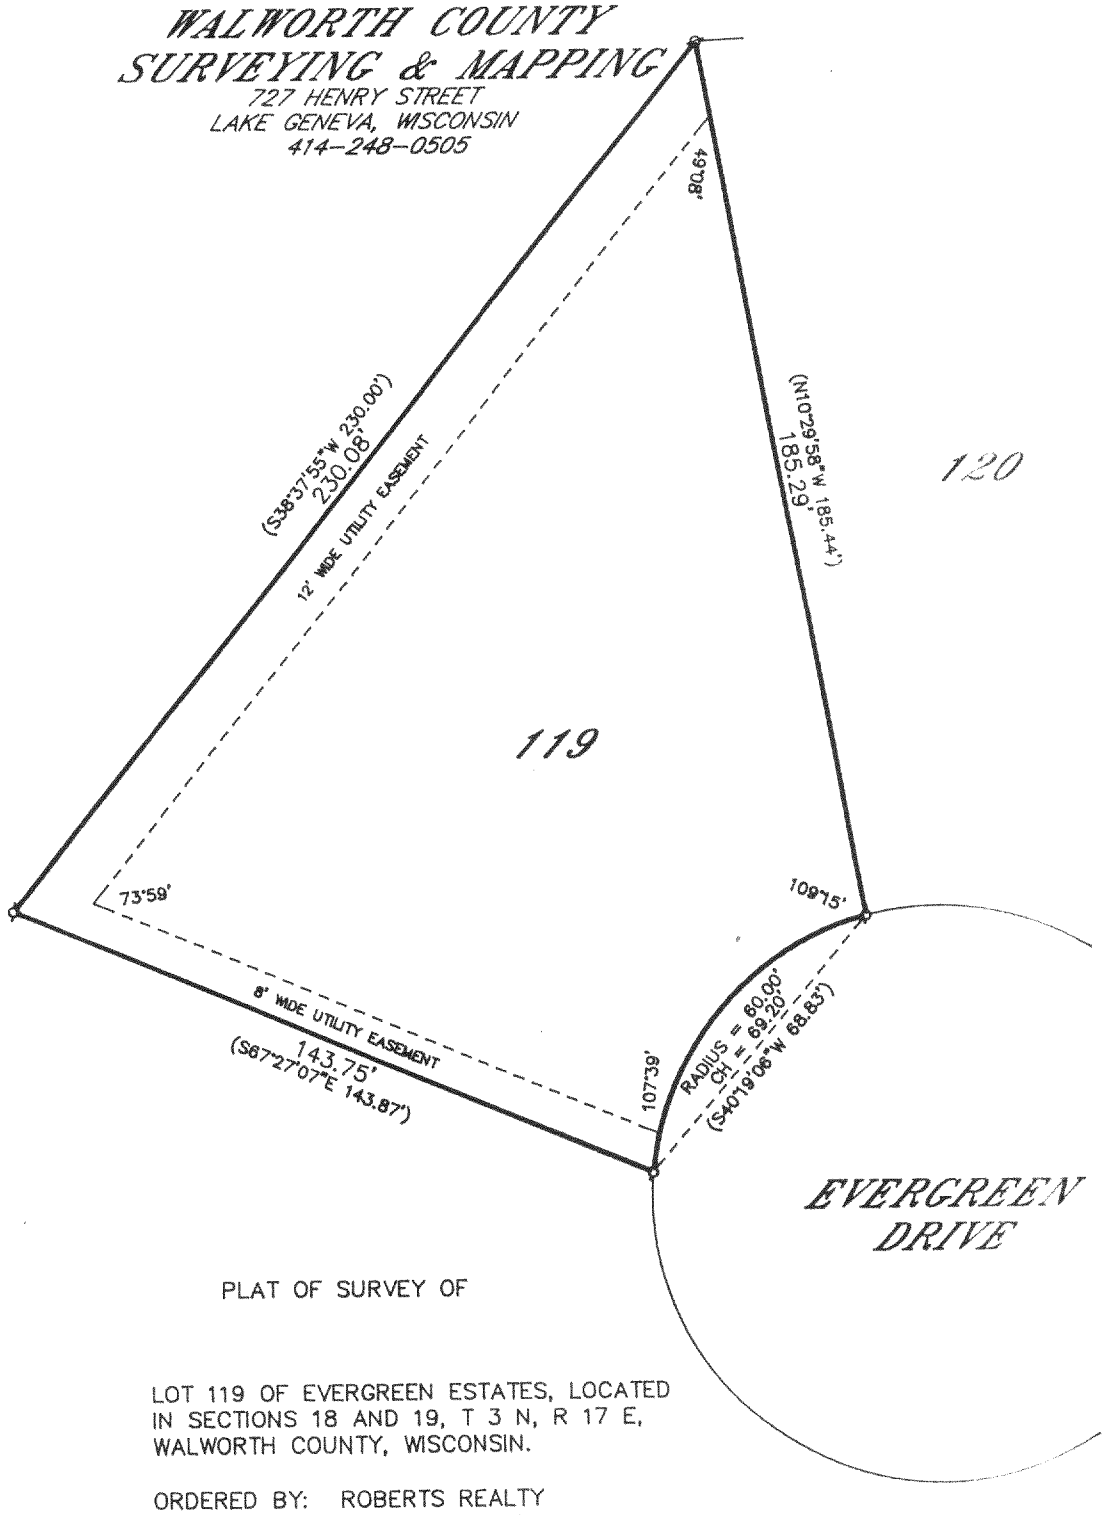

PLAT OF SURVEY OF

LOT 119 OF EVERGREEN ESTATES, LOCATED IN SECTIONS 18 AND 19, T 3 N, R 17 E, WALWORTH COUNTY, WISCONSIN.

ORDERED BY: ROBERTS REALTY
P. O. BOX 1078
WILLIAMS BAY, WISCONSIN 53191

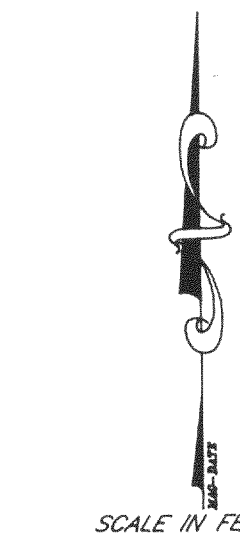

SCALE IN FEET
0 40 80

LEGEND
- ○—IRON PIPE FOUND
- ⊗—IRON ROD FOUND
- ●—CONCRETE MONUMENT FOUND
- ○—IRON PIPE PLACED
- ()—RECORDED AS

RECEIVED
JAN 2 1991

I HEREBY CERTIFY THAT I HAVE SURVEYED THE ABOVE DESCRIBED PROPERTY AND THAT THE ABOVE MAP IS A TRUE REPRESENTATION THEREOF AND SHOWS THE SIZE AND LOCATION OF THE PROPERTY, ITS EXTERIOR BOUNDARIES, THE LOCATION OF ALL VISIBLE STRUCTURES AND DIMENSIONS OF ALL PRINCIPAL BUILDINGS THEREON, BOUNDARY FENCES, APPARENT EASEMENTS, ROADWAYS AND VISIBLE ENCROACHMENTS, IF ANY, TO THE BEST OF MY KNOWLEDGE AND BELIEF.

THIS SURVEY IS MADE FOR THE USE OF THE PRESENT OWNERS OF THE PROPERTY AND ALSO THOSE WHO PURCHASE, MORTGAGE OR GUARANTEE THE TITLE THERETO WITHIN ONE (1) YEAR FROM DATE HEREOF.

Robert M. Baerenwald
ROBERT M. BAERENWALD
WISCONSIN REGISTERED LAND SURVEYOR, S-1508

Feb. 21, 1990
DATE JOB NO. 2368

NOTE: THIS IS NOT A CERTIFIED COPY UNLESS SEALED.

317-215

KE 00 119