
WALWORTH COUNTY
SURVEYING & MAPPING
727 HENRY STREET
LAKE GENEVA, WISCONSIN
414-248-0505

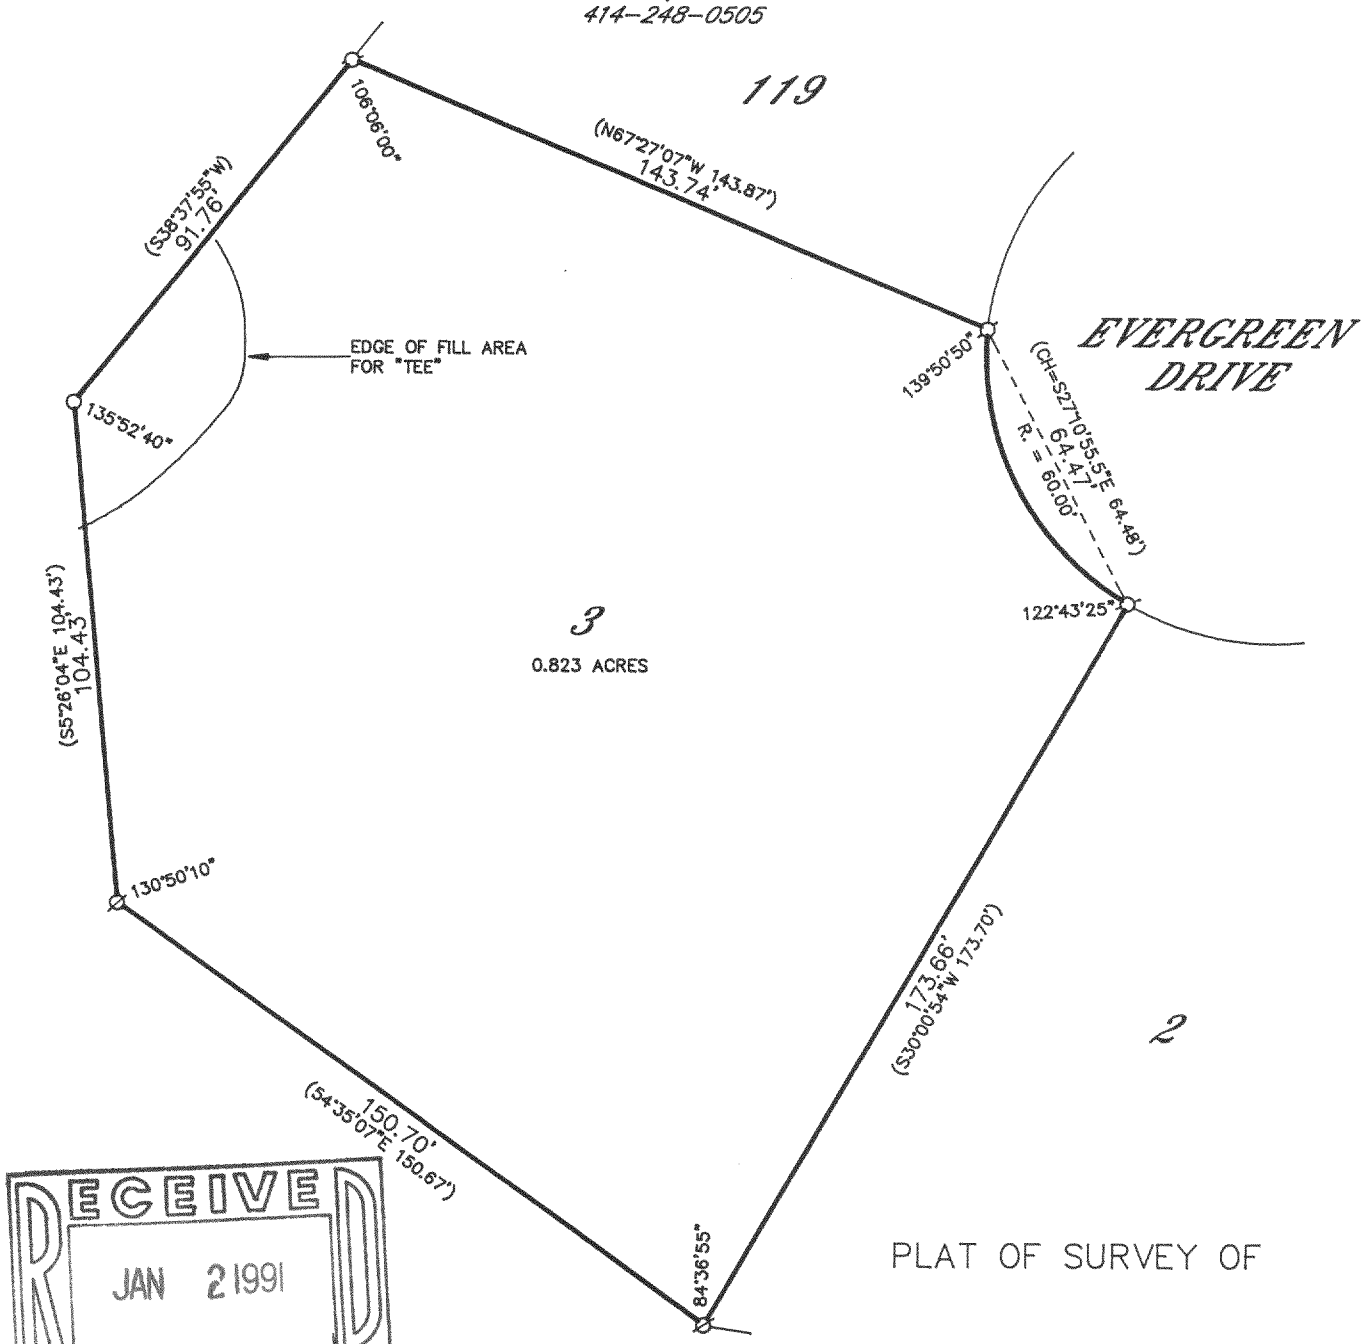

RECEIVED
JAN 2 1991

SCALE IN FEET
0 40 80

LEGEND
- ○—IRON PIPE FOUND
- Ø—IRON ROD FOUND
- ●—CONCRETE MONUMENT FOUND
- ○—IRON PIPE PLACED
- ()—RECORDED AS

PLAT OF SURVEY OF

LOT 3 OF CERTIFIED SURVEY MAP NO. 837, LOCATED IN SECTION 18, T 3 N, R 17 E, WALWORTH COUNTY, WISCONSIN.

ORDERED BY: ROBERTS REALTY
BOX 1078
WILLIAMS BAY, WISCONSIN

I HEREBY CERTIFY THAT I HAVE SURVEYED THE ABOVE DESCRIBED PROPERTY AND THAT THE ABOVE MAP IS A TRUE REPRESENTATION THEREOF AND SHOWS THE SIZE AND LOCATION OF THE PROPERTY, ITS EXTERIOR BOUNDARIES, THE LOCATION OF ALL VISIBLE STRUCTURES AND DIMENSIONS OF ALL PRINCIPAL BUILDINGS THEREON, BOUNDARY FENCES, APPARENT EASEMENTS, ROADWAYS AND VISIBLE ENCROACHMENTS, IF ANY, TO THE BEST OF MY KNOWLEDGE AND BELIEF.

THIS SURVEY IS MADE FOR THE USE OF THE PRESENT OWNERS OF THE PROPERTY AND ALSO THOSE WHO PURCHASE, MORTGAGE OR GUARANTEE THE TITLE THERETO WITHIN ONE (1) YEAR FROM DATE HEREOF.

Robert M. Baerenwald

ROBERT M. BAERENWALD
WISCONSIN REGISTERED LAND SURVEYOR, S-1508

March 3, 1990
DATE JOB NO. 2421

NOTE: THIS IS NOT A CERTIFIED COPY UNLESS SEALED.

317-217

KA 83700003