FARRIS, HANSEN & ASSOCIATES, INC.

7 RIDGEWAY COURT, P.O. BOX 437
ELKHORN, WISCONSIN 53121


PLAT OF SURVEY

PHONE: (414) 723-2098
FAX: (414) 723-5886

LOCATION : LOT 74 OF EVERGREEN ESTATES,
SEC.' S 18 & 19, T. 3 N., R. 17 E.
WALWORTH COUNTY, WI.

WORK ORDERED BY:
THELEN TOTAL CONSTRUCTION
PO BOX 17
ELKHORN, WI.

MAP LEGEND
○ = IRON PIPE STAKE FOUND
= IRON PIPE STAKE SET
= IRON ROD STAKE FOUND
= IRON ROD STAKE SET
= CONCRETE MONUMENT FOUND
(XXXXX) = RECORD DIMENSION
● = SET WOOD HUB STAKE

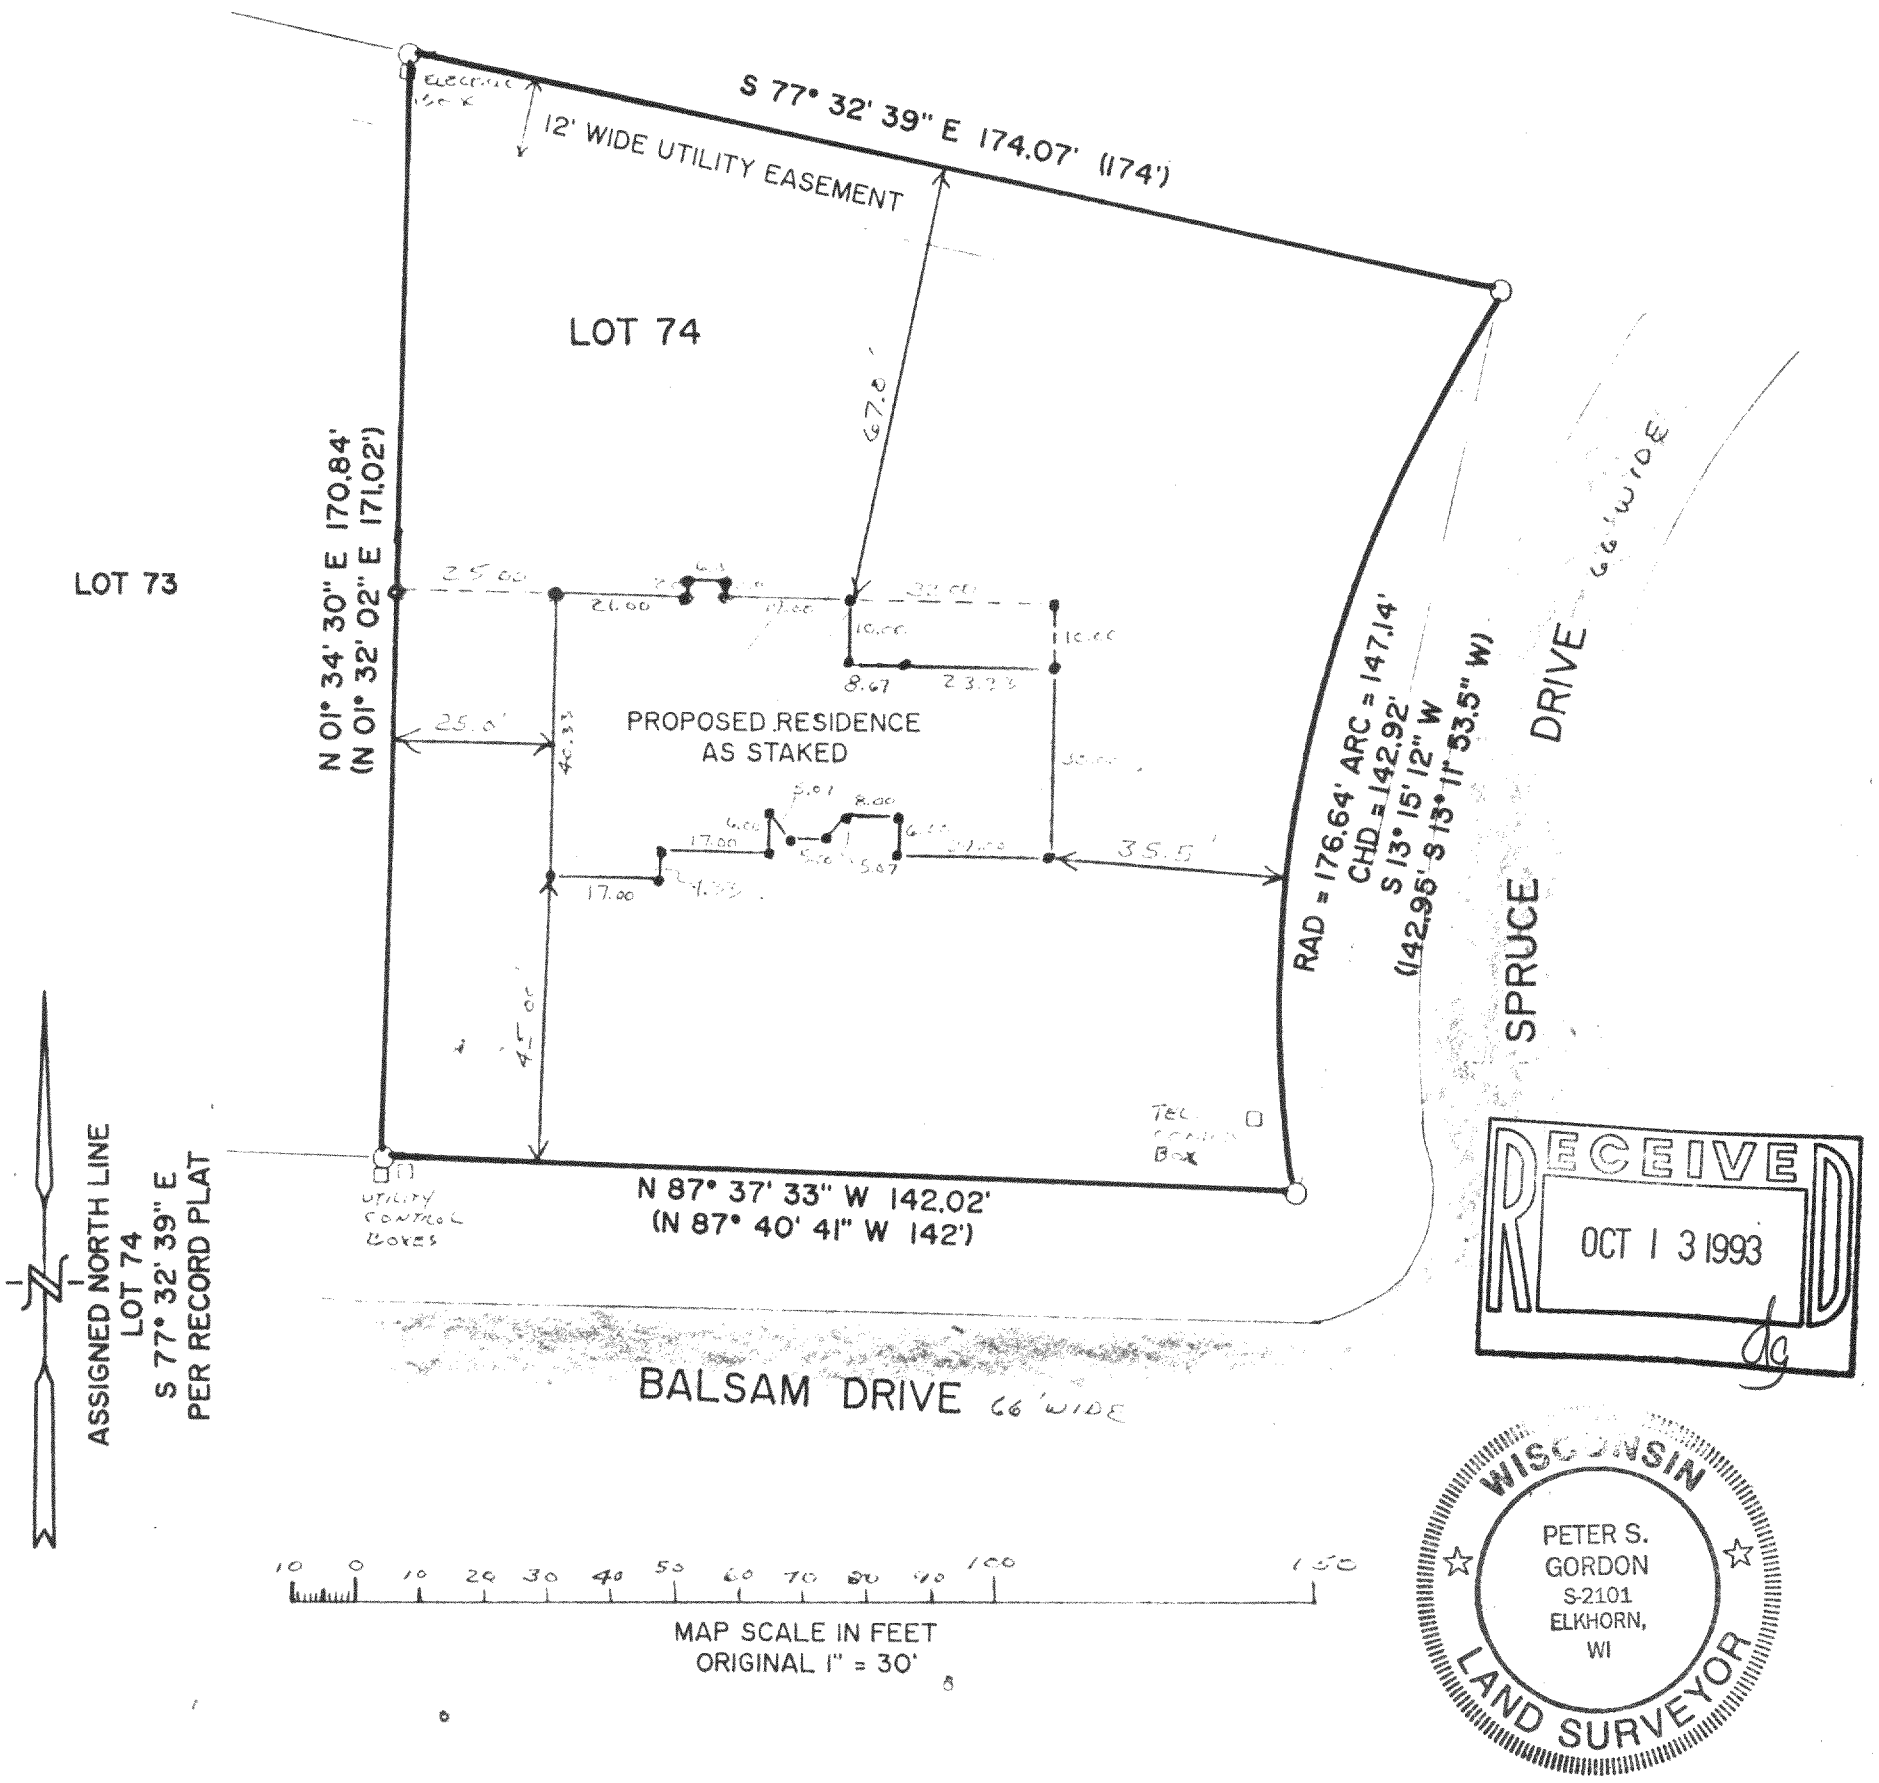

RECEIVED
OCT 13 1993

WISCONSIN
PETER S. GORDON
S-2101
ELKHORN, WI
LAND SURVEYOR

NOTE: COPIES OF THIS MAP TO WHICH THE FOLLOWING CERTIFICATE WILL APPLY ARE BLUE LINE PRINTS SHOWING SURVEYOR'S ORIGINAL SEAL AND SIGNATURE IN BLACK INK. COPIES BY ANY OTHER MEANS MAY HAVE ALTERATIONS WHICH DO NOT REPRESENT THE SURVEYOR'S WORK PRODUCT.

I HEREBY CERTIFY THAT THE ABOVE DESCRIBED PROPERTY HAS BEEN SURVEYED UNDER MY DIRECTION AND THAT THE ABOVE MAP IS A TRUE REPRESENTATION THEREOF AND SHOWS THE SIZE AND LOCATION OF THE PROPERTY AND ITS EXTERIOR BOUNDARIES. THIS SURVEY IS MADE FOR THE USE OF THE PRESENT OWNERS OF THE PROPERTY, AND ALSO THOSE WHO PURCHASE, MORTGAGE, OR GUARANTEE THE TITLE THERETO WITHIN ONE YEAR FROM THE DATE HEREOF.

DATED: 09/01/93 Peter S. Gordon PROJECT NO. 3914

KE-74

317-301