ABERNATHY and ASSOCIATES
Kenneth B. Abernathy Jr.
Wisconsin Registered Land Surveyor S-1594

Rt. 3, Box 273
Elkhorn, Wisconsin 53121
Phone: (414) 723-4260 (office)
(414) 723-7209 (FAX)

PLAT OF SURVEY


LOT 105 OF EVERGREEN ESTATES SUBDIVISION LOCATED IN SECTION 19, TOWN 3 NORTH, RANGE 17 EAST, WALWORTH COUNTY, WISCONSIN.

ORDERED BY: DAN FINKE CONSTRUCTION
5870 HWY 36
BURLINGTON, WI. 53105

OWNER: GROSS

NOTE:

THIS SURVEY RETRACES A PREVIOUS PLAT OF SURVEY PREPARED BY ROBERT M. BAERENWALD DATED AUGUST 10, 1993 AS JOB. NO. 3930 A COPY OF WHICH WAS RECEIVED FROM BUILDER AND OWNER TO AID IN THE PREPARATION OF THIS PLAT.

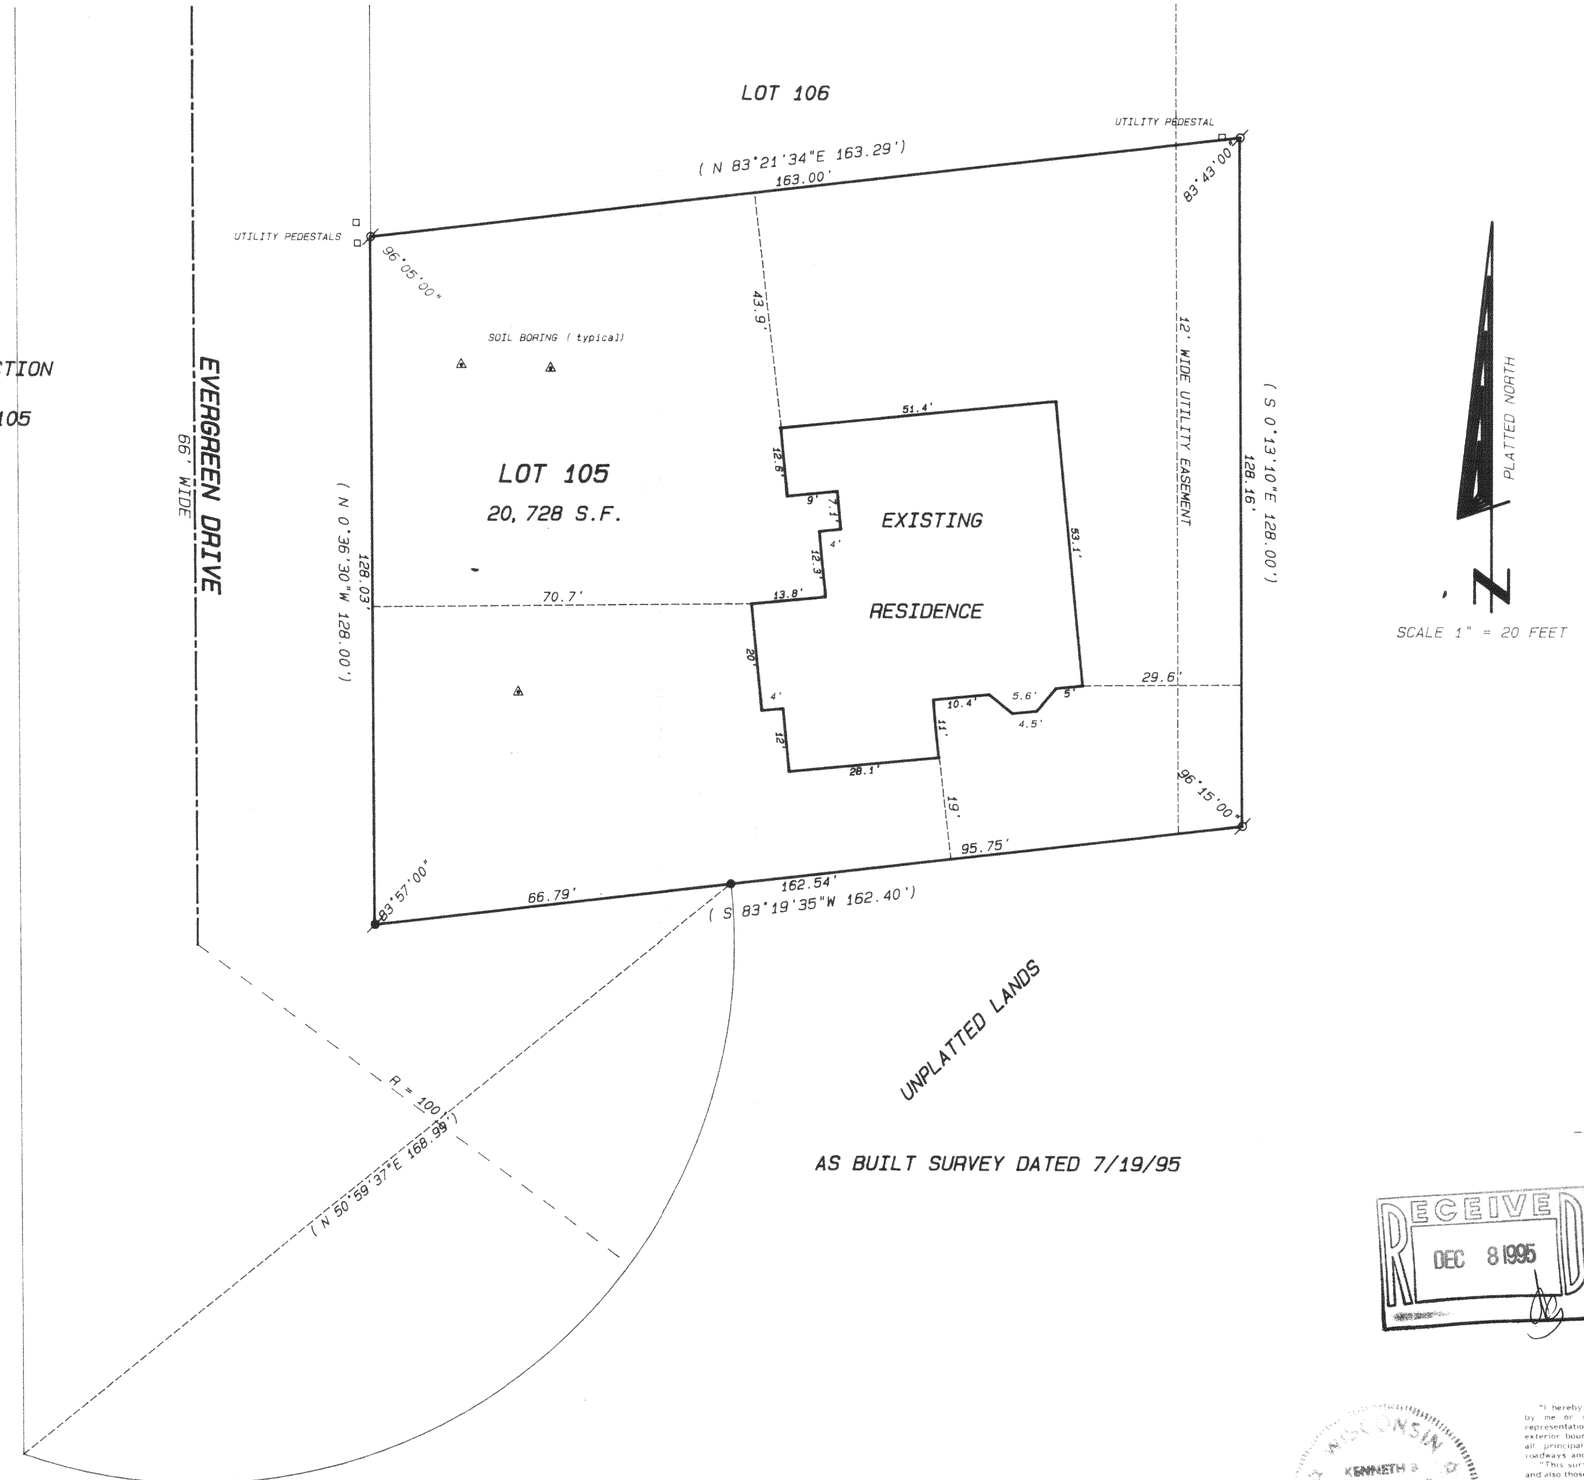

AS BUILT SURVEY DATED 7/19/95

Legend

- FOUND IRON PIPE
- FOUND IRON ROD
- FOUND BRASS CAPPED MONUMENT
- FOUND CONCRETE MONUMENT
- \+ CHISEL CUT IN CONCRETE
- SET IRON ROD, 24" LONG, WEIGHING 1.5 LBS./LINEAL FT., 3/4" DIA.
- SET IRON ROD, 30" LONG, WEIGHING 4.5 LBS./LINEAL FT., 1 1/16" DIA.
- (xx) RECORDED AS DIMENSION
- —x—x— EXISTING FENCE

RECEIVED
DEC 8 1995

SCALE: 1" = 20 FEET

"I hereby certify that the above described property has been surveyed by me or under my direction and that the above map is a true representation thereof and shows the size and location of the property, its exterior boundaries, the location of all visible structures and dimensions of all principal buildings thereon, boundary fences, apparent easements, roadways and visible encroachments, if any."

"This survey is made for the use of the present owners of the property, and also those who purchase, mortgage, or guarantee the title thereto within one year from date hereof."

KENNETH B. ABERNATHY, JR.
WISCONSIN REGISTERED LAND SURVEYOR,
S-1594

Date: 7/19/95 Job No. 95.520

DESIGN PRODUCTS (262)542

KE-105

317-365

315-365

TOPOGRAPHICAL MAP OF PROPOSED MINERAL EXTRACTION PROJECT LOCATED IN THE NORTHW
1/4 AND IN THE NORTH 1/2 OF THE SOUTHWEST 1/4 OF SECTION 33, TOWN 3 NORTH, RANGE
EAST, TOWN OF RICHMOND, WALWORTH COUNTY, WISCONSIN.

