
PLAT OF SURVEY

RSV ENGINEERING, INC
ENGINEERS, PLANNERS, SURVEYORS
CONSTRUCTION MANAGERS
545 BAY VIEW ROAD, MUKWONAGO, WISCONSIN 53149 (414) 363-2004

FOR: JOHN AND KRIS JENSWOLD

DATE: 9/25/95

DESCRIPTION: LOT 5 OF ALPINE TOWER ESTATES BEING A SUBDIVISION LOCATED IN PART OF THE NE¼ OF SECTION 13, TOWN 3 NORTH, RANGE 17 EAST, OF THE 4th PRINCIPAL MERIDIAN, TOWN OF LA FAYETTE, WALWORTH COUNTY, WISCONSIN.

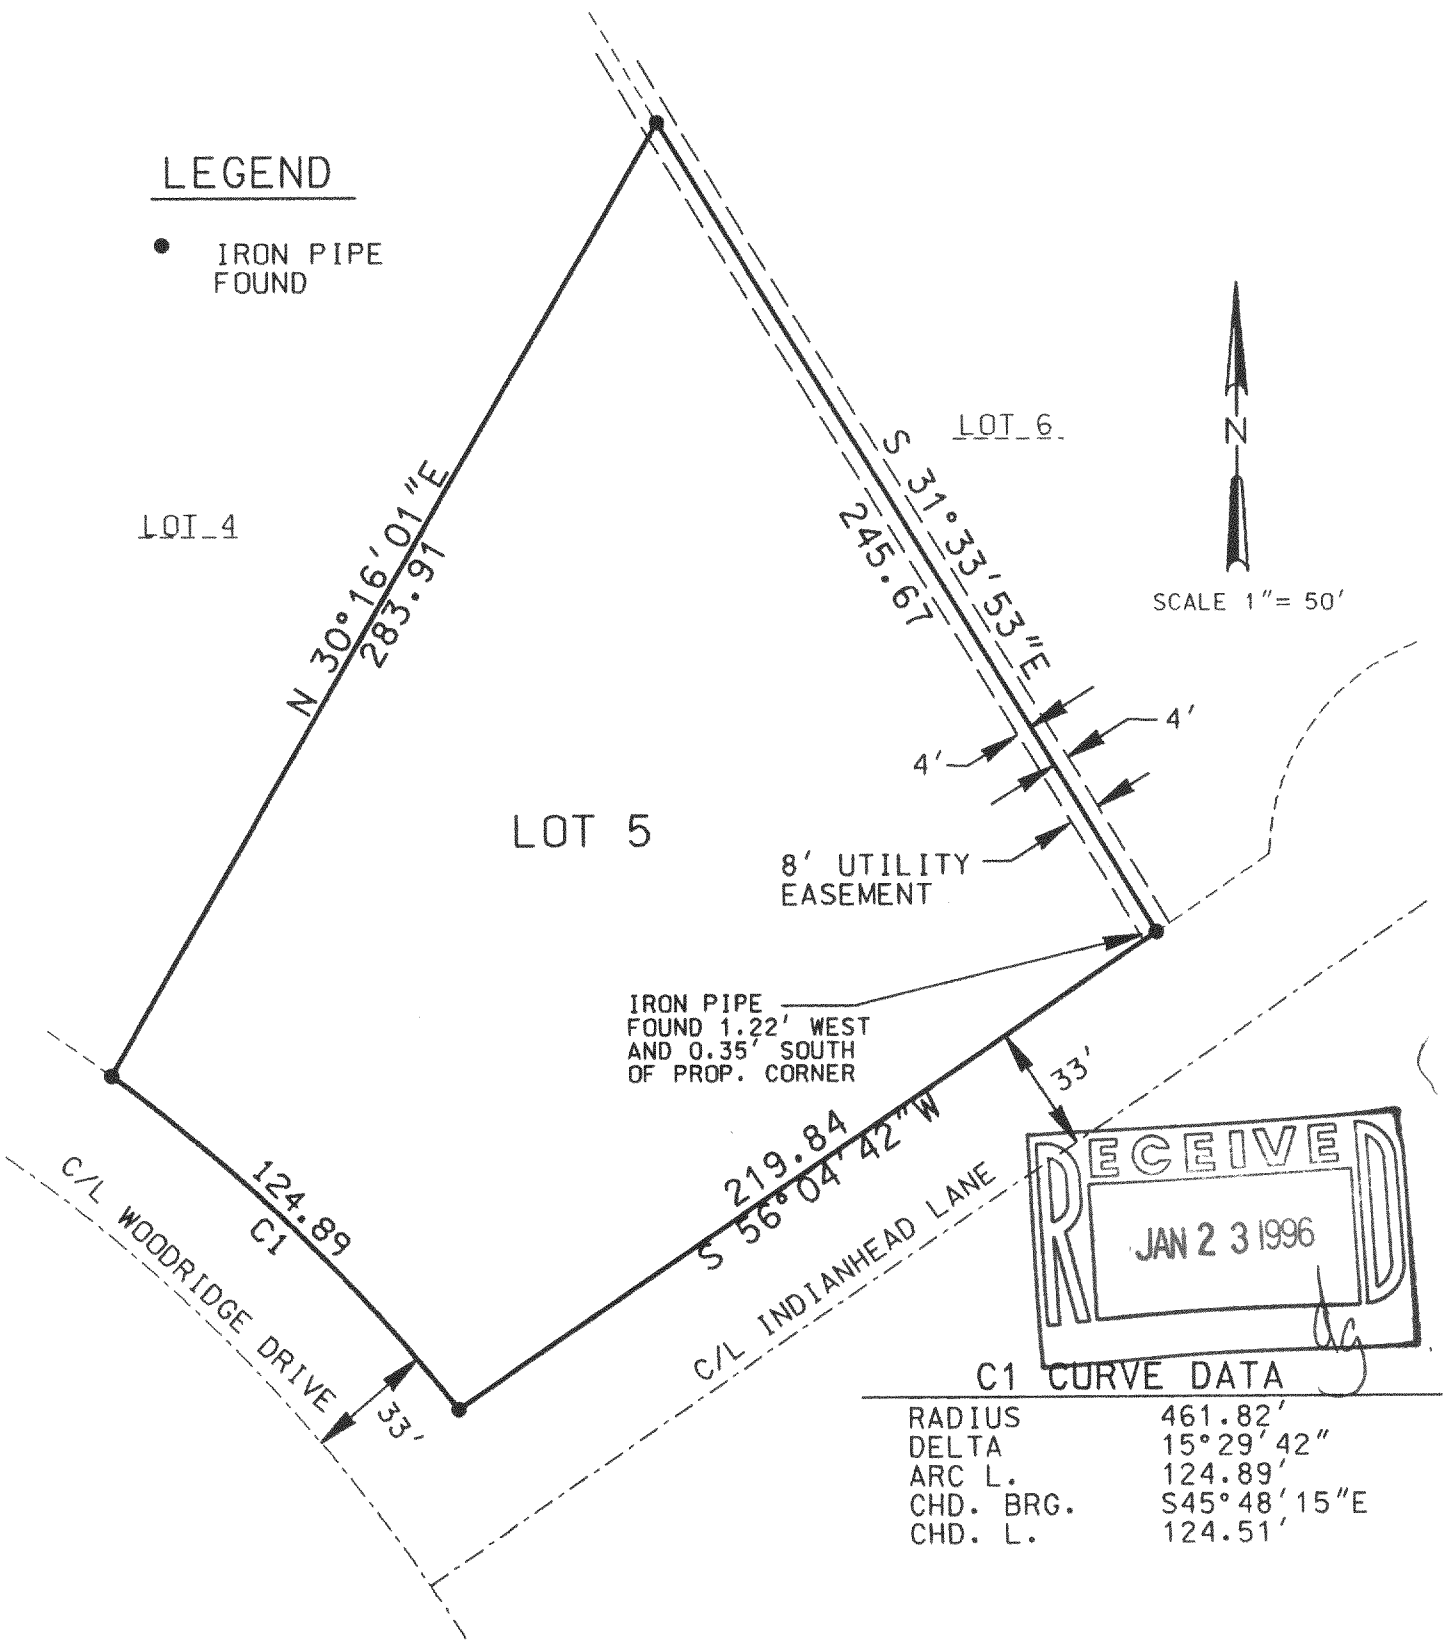

RECEIVED
JAN 23 1996

C1 CURVE DATA

RADIUS	461.82'
DELTA	15°29'42"
ARC L.	124.89'
CHD. BRG.	S45°48'15"E
CHD. L.	124.51'

THE ABOVE MAP IS A TRUE REPRESENTATION THEREOF AND SHOWS THE SIZE AND LOCATION OF ALL THE PROPERTY, EXTERIOR BOUNDARIES, THE LOCATION OF ALL VISIBLE BOUNDARY FENCES, APPARENT EASEMENTS, ROADWAYS AND VISIBLE ENCROACHMENTS, IF ANY.

THIS SURVEY IS MADE FOR THE USE OF THE PRESENT OWNERS OF THE PROPERTY, AND ALSO THOSE WHO PURCHASE, MORTGAGE OR GUARANTEE TITLE THERETO WITHIN ONE (1) YEAR FROM DATE HERETO.

BRADFORD L. SPENCER, R.L.S. 2069
RSV# 95116.DGN

WISCONSIN
BRADFORD L. SPENCER
S-2069
MUKWONAGO, WIS.
LAND SURVEYOR

THIS IS ORIGINAL PRINT ONLY IF SEAL IS IMPRINTED IN RED

KAT-67 317-370