
PLAT OF SURVEY

ORDERED BY: DAVID AUL
N 7376 LOST NATION ROAD
ELKHORN, WI. 53121

DESCRIPTION: UNIT 30 ROLLING GREEN COUNTRY ESTATES, A CONDOMINIUM LOCATED IN THE SOUTHEAST 1/4 OF SECTION 18, T3N, R17E, TOWN OF LA FAYETTE, WALWORTH COUNTY, WISCONSIN.

RECEIVED
JUN 24 1999

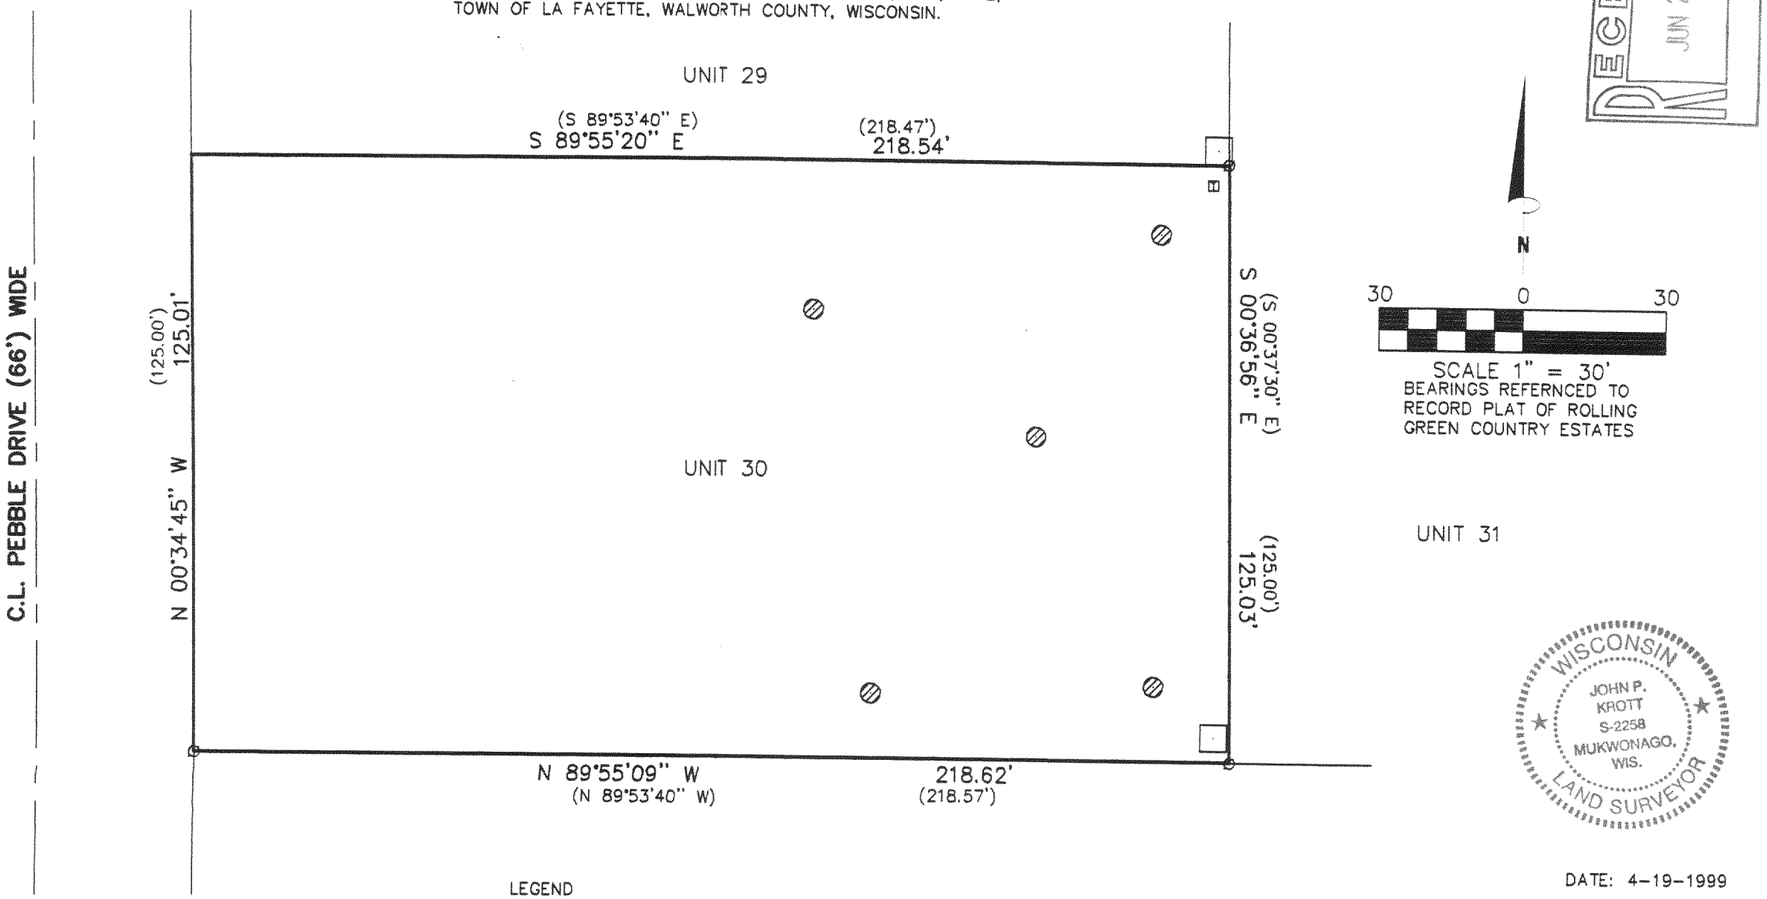

SCALE 1" = 30'
BEARINGS REFERNCED TO RECORD PLAT OF ROLLING GREEN COUNTRY ESTATES

LEGEND

- ○ FOUND IRON PIPE
- (XXX) RECORDED AS
- ▣ TELEPHONE PEDASTAL
- □ ELECTRIC PEDASTAL
- ⊘ SOIL BORING

THE ABOVE MAP IS A TRUE REPRESENTATION THEREOF AND SHOWS THE SIZE AND LOCATION OF ALL THE PROPERTY, EXTERIOR BOUNDARIES, THE LOCATION OF ALL VISIBLE BOUNDARY FENCES , APPARENT EASEMENTS , ROADWAYS AND VISIBLE ENCROACHMENTS , IF ANY

THIS SURVEY IS MADE FOR THE USE OF THE PRESENT OWNERS OF THE PROPERTY , AND ALSO THOSE WHO PURCHASE , MORTGAGE OR GURANTEE TITLE THERETO WITHIN ONE (1) YEAR FROM DATE HERETO.

JOHN P. KROTT , R.L.S. 2258

DATE: 4-19-1999

NOTE: THIS IS NOT A CERTIFIED COPY UNLESS SEAL IS IN RED.

JOB NUMBER #99078 3-17-KRG-30

PATHFINDER SURVEYING
FORMERLY KOLB LAND CONSULTING
929 WILLIAMS STREET LAKE GENEVA, WI. 53147
(414) 248-3697

317-451 KRG-30