

PLAT OF SURVEY
LOT 92 OF EVERGREEN ESTATES


A SUBDIVISION LOCATED IN
SECTIONS 18 AND 19, TOWN 3 NORTH, RANGE 17 EAST
WALWORTH COUNTY, WISCONSIN

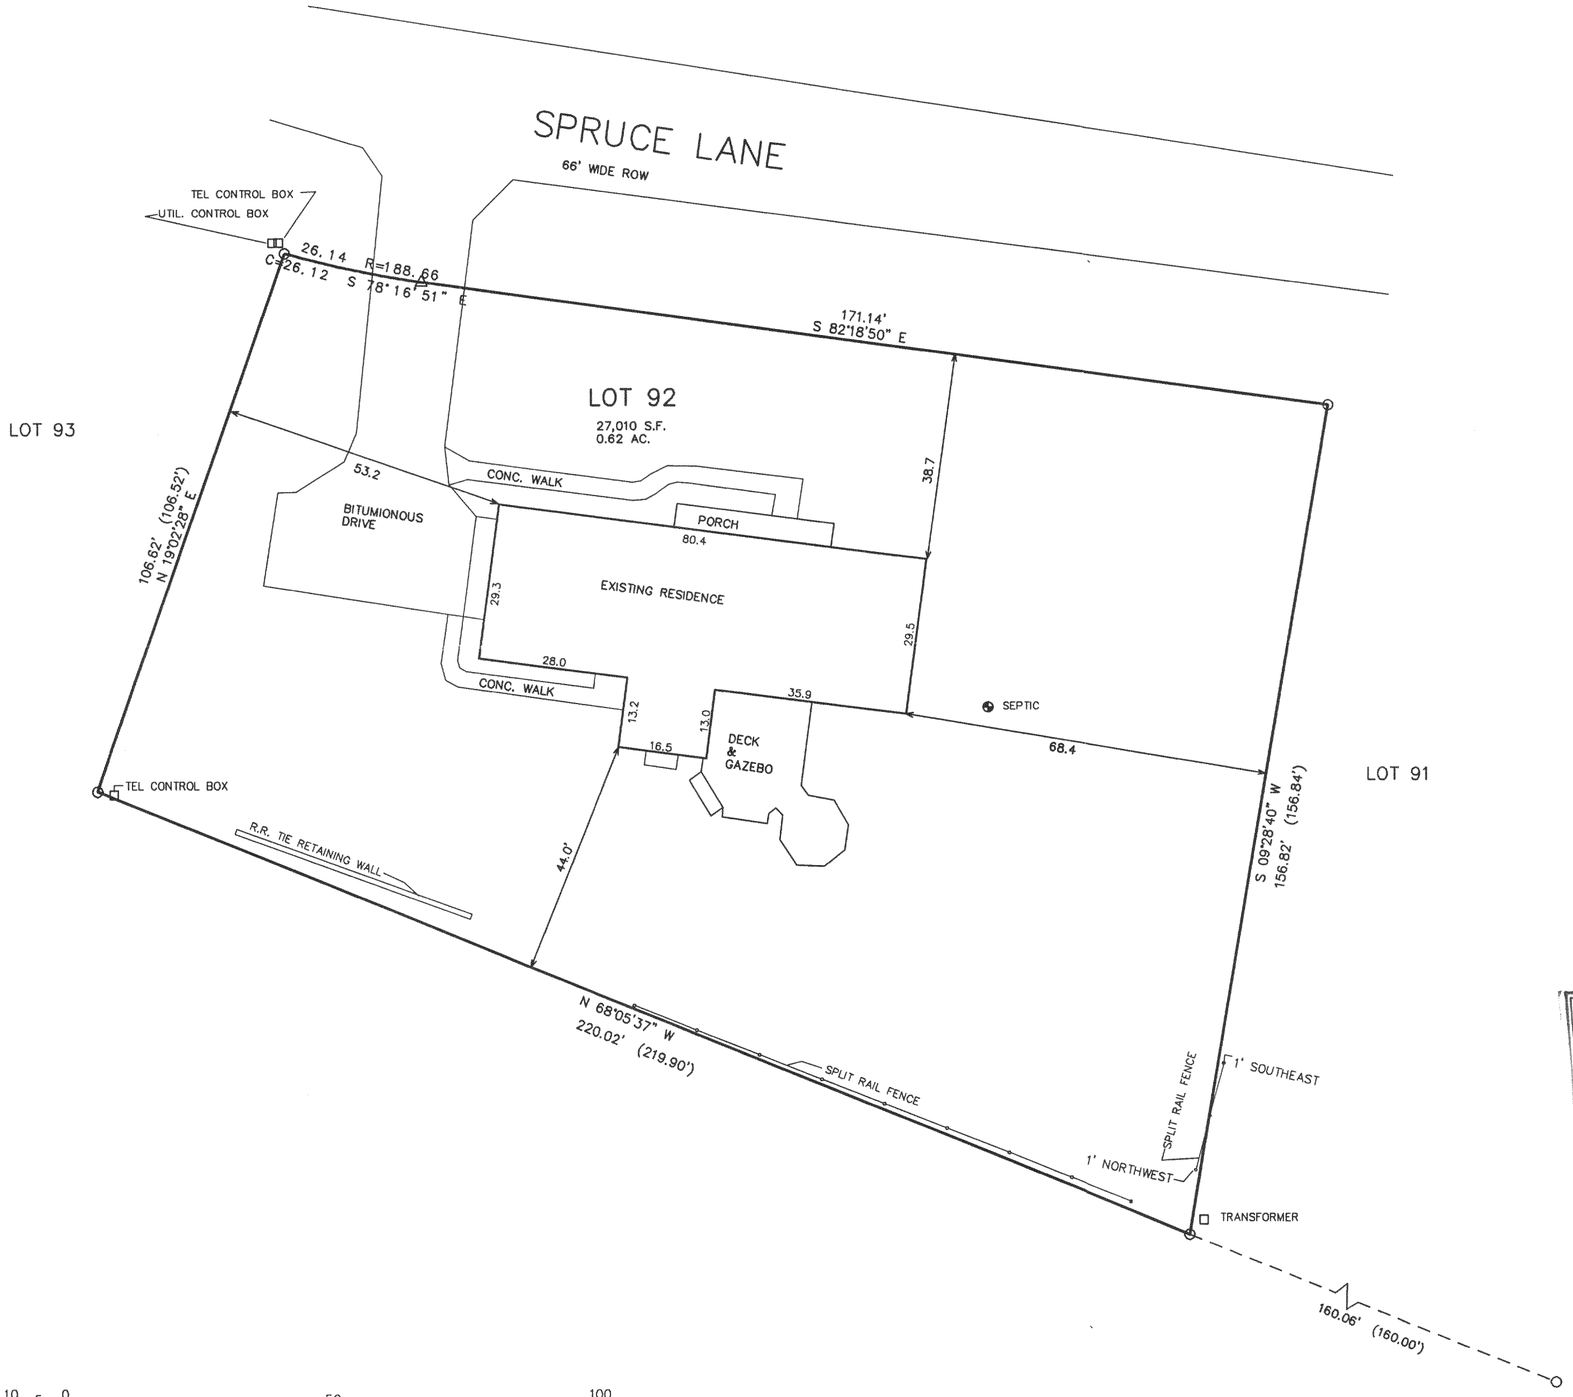


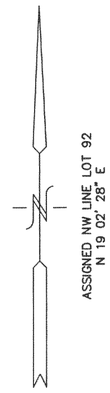


LEGEND

O = FOUND IRON PIPE STAKE
△ = SET NAIL IN PAVEMENT
(xxx) = RECORDED AS

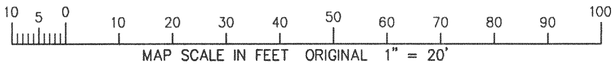

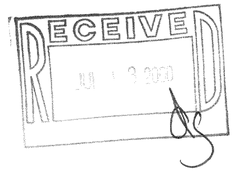

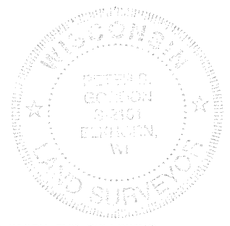

NOTE: COPIES OF THIS MAP TO WHICH THE FOLLOWING CERTIFICATE WILL APPLY SHOW SURVEYOR'S ORIGINAL SEAL AND SIGNATURE IN RED INK. COPIES BY ANY OTHER MEANS MAY HAVE ALTERATIONS WHICH DO NOT REPRESENT THE SURVEYOR'S WORK PRODUCT.

I HEREBY CERTIFY THAT THE ABOVE DESCRIBED PROPERTY HAS BEEN SURVEYED UNDER MY DIRECTION AND THAT THE ABOVE MAP IS A TRUE REPRESENTATION THEREOF AND SHOWS THE SIZE AND LOCATION OF THE PROPERTY AND ITS EXTERIOR BOUNDARIES. THIS SURVEY IS MADE FOR THE USE OF THE PRESENT OWNERS OF THE PROPERTY, AND ALSO THOSE WHO PURCHASE, MORTGAGE, OR GUARANTEE THE TITLE THERETO WITHIN ONE YEAR FROM THE DATE HEREOF.

DATED: 6-8-2000

PETER S. GORDON R.L.S. 2101

JUN 08 2000

KE-92 317-489

WORK ORDERED BY: TERESA CURTIS
CENTURY 21 AFFILIATED
PO BOX 367
WILLIAMS BAY, WI. 53191

FARRIS, HANSEN & ASSOCIATES, INC.
Engineering, Architecture, Surveying
7 Ridgway Court P.O. Box 437
ELKHORN, WISCONSIN 53121
Office: (414) 723-2098
Fax: (414) 723-5886

REVISIONS

PROJECT NO. 5608
DATE: 06-08-00
SHEET NO. 1 OF 1