
#133-63

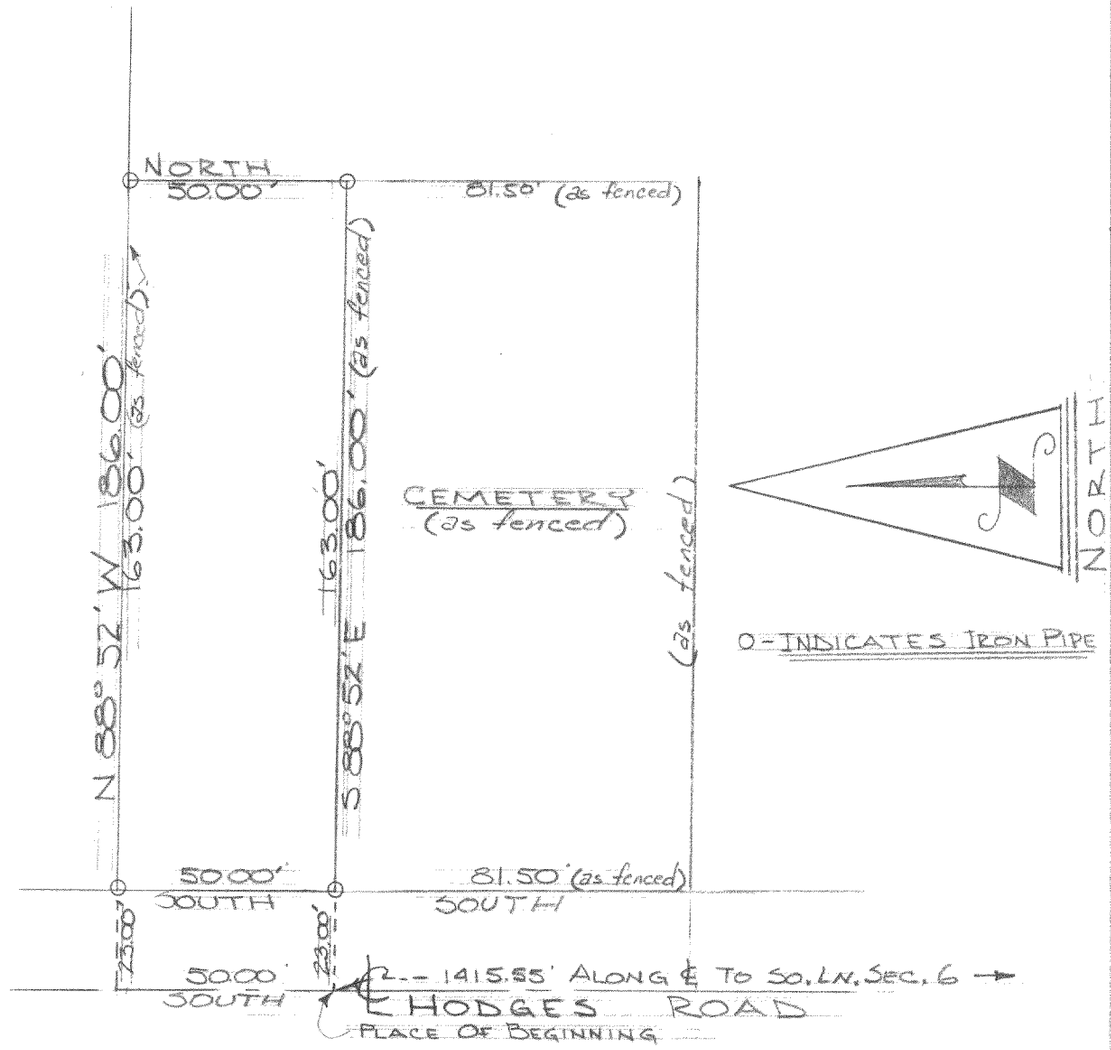

DESCRIPTION: Commencing at a point in the center line of Hodges Road that is 1415.55 feet north of the point of intersection of said center line and the south line of Section 6, T. 3 n., R. 17 E. Walworth County, Wisconsin, thence S. 88° 52' E. along the north line of a cemetery (as fenced) 186.00 feet to an iron pipe, thence North 50.00 feet to an iron pipe, thence N. 88° 52' W. 186.00 feet to a point in the center line of said road, thence South along said center line 50.00 feet to the place of beginning.

CERTIFICATE: I , James F. Biagi, surveyor, do hereby certify that I have surveyed the property hereon described.

November 4, 1963.

WISCONSIN
JAMES F. BIAGI
MILWAUKEE, WIS.
LAND SURVEYOR

James F. Biagi

James F. Biagi RLS 272

LF-6-6 Cemetery

317-4B