
# PLAT OF SURVEY

## SUGAR CREEK FARMS
## LOT 11

LOCATED IN THE EAST 1/2 OF THE NE 1/4 OF
SECTION 11, TOWN 3 NORTH, RANGE 17 EAST,
TOWN OF LAFAYETTE, WALWORTH COUNTY, WISCONSIN

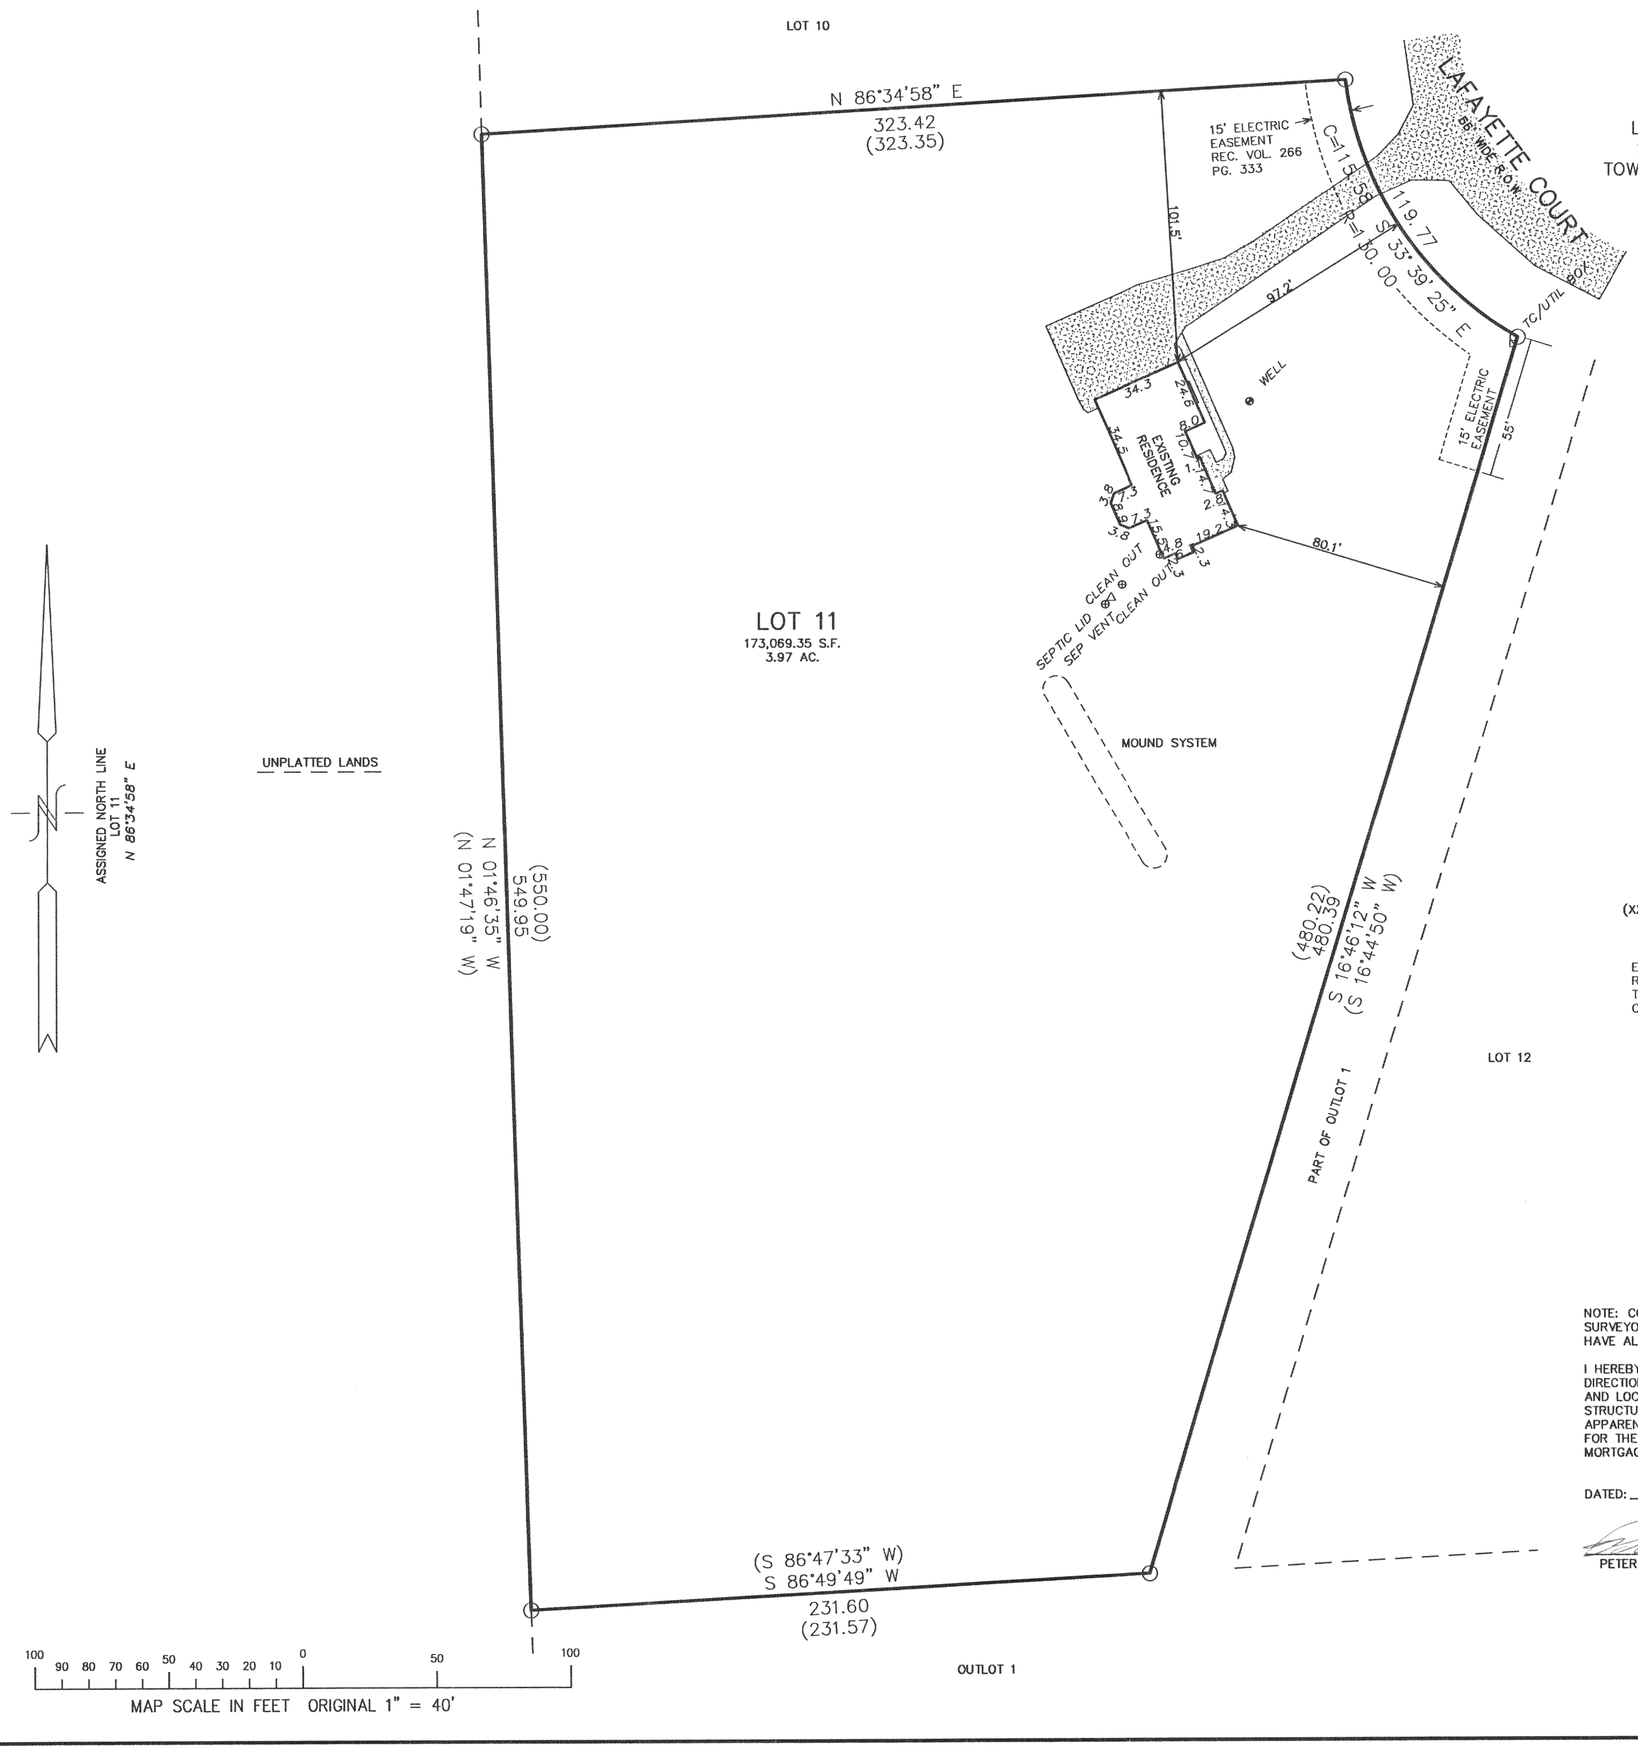


⊙ = FOUND IRON PIPE STAKE
● = FOUND IRON REBAR STAKE
⊡ = FOUND CONCRETE COUNTY MONUMENT
(XXX) = RECORDED AS

EASEMENT REC. IN VOL. 95 OF RECORDS, PAGE 756
REFERS TO AN EASEMENT IN THE SW 1/4 OF THE NW 1/4 SECTION 12
THE LANDS SURVEYED FALL IN THE EAST 1/2 OF THE NE 1/4
OF SECTION 11

RECEIVED
APR 1 2002

NOTE: COPIES OF THIS MAP TO WHICH THE FOLLOWING CERTIFICATE WILL APPLY SHOW SURVEYOR'S ORIGINAL SEAL AND SIGNATURE IN RED INK. COPIES BY ANY OTHER MEANS MAY HAVE ALTERATIONS WHICH DO NOT REPRESENT THE SURVEYOR'S WORK PRODUCT.

I HEREBY CERTIFY THAT THE ABOVE DESCRIBED PROPERTY HAS BEEN SURVEYED UNDER MY DIRECTION AND THAT THE ABOVE MAP IS A TRUE REPRESENTATION THEREOF AND SHOWS THE SIZE AND LOCATION OF THE PROPERTY, ITS EXTERIOR BOUNDARIES, THE LOCATION OF ALL VISIBLE STRUCTURES, AND DIMENSIONS OF ALL PRINCIPLE BUILDINGS THEREON, BOUNDARY FENCES, APPARENT EASEMENTS, ROADWAYS, AND VISIBLE ENCROACHMENTS, IF ANY. THIS SURVEY IS MADE FOR THE USE OF THE PRESENT OWNERS OF THE PROPERTY, AND ALSO THOSE WHO PURCHASE, MORTGAGE, OR GUARANTEE THE TITLE THERETO WITHIN ONE YEAR FROM THE DATE HEREOF.

DATED: MARCH 19, 2002

PETER S. GORDON R.L.S. 2101

- WORK ORDERED BY -
CONNIE POGGENSEE
RAULAND AGENCY
P.O. BOX 159
WALWORTH, WI 53184

FARRIS, HANSEN & ASSOCIATES, INC.
ENGINEERING – ARCHITECTURE – SURVEYING
7 RIDGWAY COURT P.O. BOX 437
ELKHORN, WISCONSIN 53121
OFFICE: (262) 723-2098 FAX: (262) 723-5886

REVISIONS

PROJECT NO. 5956
DATE: 01/11/02
SHEET NO. 1 OF 1

MAR 19 2002

KS-11 317-529